

# Goose Lake - Water Rights & Land Use

Submitted by Mary Maurer, DNR\DMLW, 1/10/05

**Water Rights**

- Water Rights
- Water Rights - Annotation

**AK Coastal Mgmt Program**

- Special Area Plan Bndry : Anchorage Wetlands Management Plan

**Settlements**

- Settlements, Exchanges & Reconveyances

**Land Use**

- Land Sales, Leases, Permits & Material Sales

**Mental Health Trust Lands**

- Mental Health Trust Land (QCD's)

**Municipal Entitlements**

- Municipal Entitlements

**Hydrography**

- ITM Hydro - Lines
- ITM Hydro - Polygons

**Statewide Grids**


- Section Grid

**Other State Title**


- Other State Land

**Statehood Title**

- State Grant Land

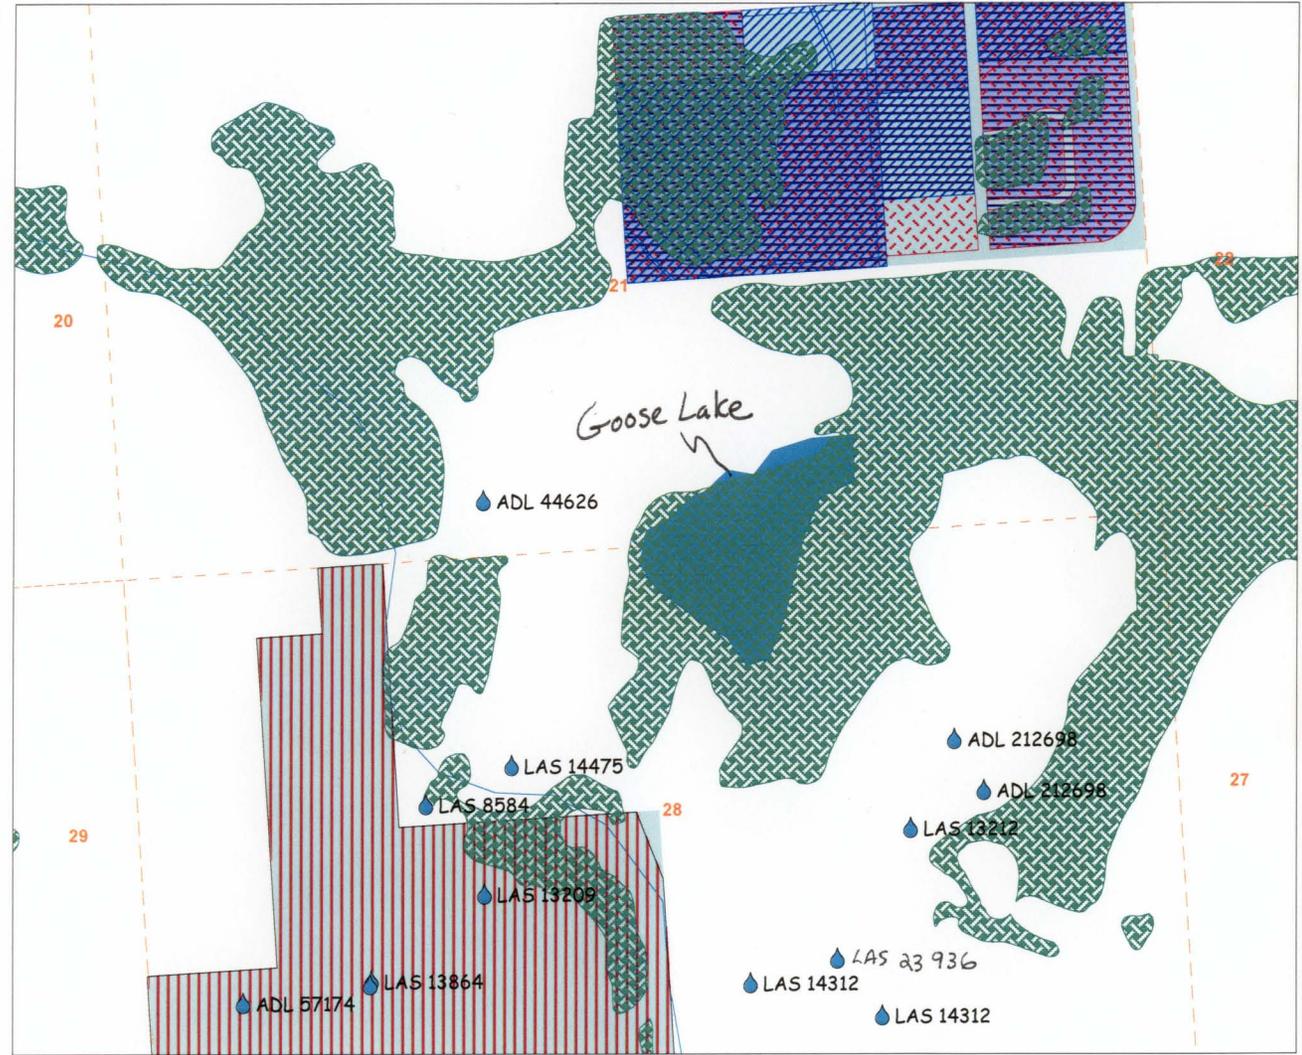

SCALE 1 : 11,574

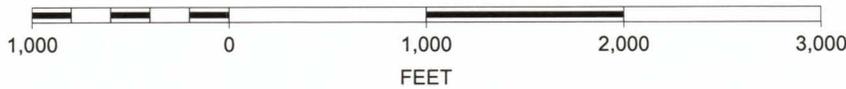

hand annotations by Mary Maurer, DNR\DMLW, 1/6/05



Submitted by Mary Maurer, DNR\DMLW, 1/10/05

*Goose Lake area*

To look up the details for a particular case click on the File Type and Number.

Explanation of Source, Use and SIC Codes

Source: Each Source represents a takepoint. A water right/reservation may have one or more sources/takepoints associated with it. Sources are represented by letters, A, B, C, D, etc...

They do not represent any priority, in other words, Source A is not any more important than Source C or E.

Use: Each Source may have one or more Uses associated with it. Uses are represented by letters, A, B, C, D, etc... They do not represent any priority, Use A is not any more important than Use C or E.

SIC Code: Associated with each Use is an SIC code. These codes generally describe the planned or allowed water use.

Number of distinct water rights/reservations in this report: 11

File Type & Number	Source:	Use:	Source Type Code (Format = YYYYMMDD)	SIC Code	SIC Description	Quantity	Quantity Unit Code	Quantity Description	Beginning Date (Format = MM/DD)	Ending Date (Format = MM/DD)	Days of Use
<del>ADL 44626</del>	<del>A</del>	<del>A</del>	<del>DRLW</del>	<del>4941</del>	<del>PUBLIC WATER SUPPLY</del>	<del>11.0</del>	<del>D</del>	<del>MILLION GAL/DAY</del>	<del>0101</del>	<del>1231</del>	
<del>ADL 44626</del>	<del>B</del>	<del>A</del>	<del>DRLW</del>	<del>4941</del>	<del>PUBLIC WATER SUPPLY</del>	<del>0.0</del>	<del>G</del>	<del>GAL/DAY</del>	<del>0101</del>	<del>1231</del>	
<del>ADL 44626</del>	<del>C</del>	<del>A</del>	<del>DRLW</del>	<del>4941</del>	<del>PUBLIC WATER SUPPLY</del>	<del>0.0</del>	<del>G</del>	<del>GAL/DAY</del>	<del>0101</del>	<del>1231</del>	
<del>ADL 44626</del>	<del>D</del>	<del>A</del>	<del>DRLW</del>	<del>4941</del>	<del>PUBLIC WATER SUPPLY</del>	<del>0.0</del>	<del>G</del>	<del>GAL/DAY</del>	<del>0101</del>	<del>1231</del>	
<del>ADL 44626</del>	<del>E</del>	<del>A</del>	<del>DRLW</del>	<del>4941</del>	<del>PUBLIC WATER SUPPLY</del>	<del>0.0</del>	<del>G</del>	<del>GAL/DAY</del>	<del>0101</del>	<del>1231</del>	
ADL 44626 <i>MoA</i>	F	A	DRLW <i>near Goose Lake</i>	4941	PUBLIC WATER SUPPLY	0.0	G	GAL/DAY	0101	1231	
ADL 44626	G	A	DAM	4941	PUBLIC WATER SUPPLY	7200000.0	G	GAL/DAY	0101	1231	
ADL 57174	A	A	DRLW	8221	COLLEGE	9.21	A	ACRE FT/YR	0401	0930	
ADL 212698	B	A	DRLW	8221	COLLEGE	148.8	A	ACRE FT/YR	0501	0930	
LAS 8584	A	A	DRLW	8800	FAMILY DWELLING	500.0	G	GAL/DAY	0101	1231	
LAS 13209	A	A	DRLW	8221	COLLEGE	89.1	A	ACRE FT/YR	0501	0930	
LAS 13212	A	A	DRLW	8221	COLLEGE	153.8	A	ACRE FT/YR	0501	0930	

Submitted by Mary Maurer, DNR\DMLW, 1/10/05

LAS 13864	A	A	DRLW	8221	COLLEGE	19.5	A	ACRE FT/YR	0515	0915	
LAS 14312 <i>Providence</i>	A	A	DRLW	5070	INDUSTRIAL COOLING	1200.0	M	GAL/MIN	0515	0915	
LAS 14312 <i>Hospital</i>	B	B	DRLW	5070	INDUSTRIAL COOLING	1200.0	M	GAL/MIN	0515	0915	
LAS 14475	A	A	DRLW	8800	FAMILY DWELLING	750.0	G	GAL/DAY	0101	1231	
LAS 14475	A	B	DRLW	0782	LAWN AND GARDEN	600.0	G	GAL/DAY	0501	0930	
LAS 22632	A	A	DRLW	8221	COLLEGE	30.5	A	ACRE FT/YR	0501	0930	
LAS 23936 <i>Providence Hospital</i>	A	A	DRLW	5070	INDUSTRIAL COOLING	207360.0	G	GAL/DAY	0501	0930	

Output Report to Excel

Submitted by Mary Maurer, DNR\DMLW, 1/10/05

Goose Lake area

**Temporary Water Use Authorizations****Alaska Department of Natural Resources**

(TWUPS)

Following is a list of Temporary Water Use Authorizations located in S013N003W.  
Authorizations are displayed in order by File Type and Number.

Please allow a few moments for the list to display.

If no Authorizations are listed it means there are currently none in the system that match your search criteria. Please return to the Temporary Water Use Authorizations search page and try again.

The Status Date indicates:

the date the Authorization was signed if the status is "ISS/APPRV/ACTV AUTH" or  
the date the Application was received if the status is "APLN/INITIAL STATUS."

To look up the details for a particular case click on the File Type and Number displayed in the list below.

File Type & Number	Customer Name	File Status	Status Date (Format is YYYYMMDD)	Meridian, Township, Range Section
<u>TWUP A2001-114</u>	UNIVERSITY OF ALASKA,	ISS/APPRV/ACTV AUTH	20020401	S013N003W 28 <i>360,000 gpd for cooling</i>
<del>TWUP A2001-31</del>	USDOT FAA AK REGION,	ISS/APPRV/ACTV AUTH	20010425	S013N003W 10
<del>TWUP A2001-87</del>	ALASKA NATIVE MEDICAL CENTER,	ISS/APPRV/ACTV AUTH	20010828	S013N003W 27
<u>TWUP A2003-22</u>	PROVIDENCE HEALTH SYSTEM IN AL, ASKA	ISS/APPRV/ACTV AUTH	20030502	S013N003W 28 <i>add spring fall use for cooling system 1200 gal/min.</i>
<del>TWUP A2003-65</del>	ALASKA NATIVE TRIBAL HEALTH CO, NSORTIUM	ISS/APPRV/ACTV AUTH	20031219	S013N003W 27