

ATKA, ALASKA

WATER SYSTEM UPGRADES


- WATER TREATMENT PLANT (WTP)
- BACKWASH WATER DISCHARGE BASIN (2 EA)
- ABANDON THE EXISTING WTP AND WOODSTAVE WATER STORAGE TANKS
- 3,000 LF ± 8" HDPE WATERMAIN UPGRADE
- 2,800 LF ± 6" HDPE WATERMAIN UPGRADE

In Cooperation with the State of Alaska
 Department of Environmental Conservation
 Village Safe Water Program

RECORD DRAWINGS



LOCATION MAP

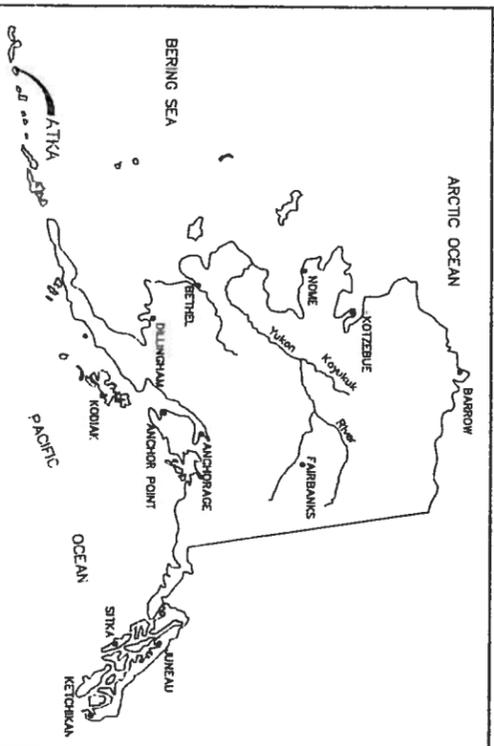

CONSULTANT

RECORD DRAWING CERTIFICATE

THESE DRAWINGS REFLECT RECORDED INFORMATION OBTAINED DURING CONSTRUCTION. INFORMATION PROVIDED HEREIN IS ACCURATE TO THE BEST OF MY KNOWLEDGE.

NAME: *Paul C. Moore* DATE: *1-22-2013*




Project Number (Consultant): 610801 (VSW)
 VSW Project Engineer: SUSAN RANDELTT, P.E.
 Construction Foreman: _____
 Final Design (Date): _____
 ADEC Approval (Date): _____
 Construction Period (From) _____ (To) _____
 As-Built (Date): _____

SHEET INDEX

No.	Title
GENERAL	
G1.0	COVER SHEET INDEX
G1.1	GENERAL NOTES AND PROJECT LOCATIONS
G1.2	DESIGN NOTES AND CALLOUTS
G1.3	SURVEY CONTROL
G1.4	PROJECT DESIGN AND CRITERIA
G1.5	ORIGINAL ELEVATION SCHEMATIC
G1.6A	PROPOSED ELEVATION SCHEMATIC
G1.6B	2012 EXISTING ELEVATION SCHEMATIC
G1.6C	2012 EXISTING ELEVATION SCHEMATIC
G1.7	GEOTECHNICAL TEST PIT LOCATIONS
G1.8 - G1.12	GEOTECHNICAL INFORMATION
G2.0	SITE CONTROL
CIVIL	
C1.0	SITE PLAN - WATER TREATMENT SITE
C1.1	SECTIONS - WATER TREATMENT SITE
C2.0	WATERMAIN IMPROVEMENTS - INDEX SHEET
C2.1	PLAN AND PROFILE
C2.2	PLAN AND PROFILE
C2.3	PLAN AND PROFILE
C2.4	PLAN AND PROFILE
C2.5	PLAN AND PROFILE
C2.6	PLAN AND PROFILE
C2.7	PLAN AND PROFILE
C2.8	PLAN AND PROFILE
C2.9	PLAN AND PROFILE
C2.10	PLAN AND PROFILE
C2.11	PLAN AND PROFILE
C5.1	TRENCH SECTION AND PIPE DETAILS
C5.2	LAGOON DRAIN DETAILS WATER TREATMENT SITE
C5.3	FENCE DETAILS
C5.4	ON-SITE WASTE WATER DISPOSAL
ARCHITECTURAL	
A1.1	WTP ELEVATIONS AND FLOORPLAN
A1.2	ROOM SCHEDULES
A1.3	LABORATORY AND RESTROOM CEILING DETAIL
STRUCTURAL	
S1.0	GENERAL STRUCTURAL NOTES
S2.0	WTP PLANS AND SECTIONS
S3.0	WTP DETAILS
MECHANICAL	
M1.0	WATER TREATMENT PROCESS DIAGRAM OPERATIONAL NARRATIVE
M1.1	WATER TREATMENT PROCESS DIAGRAM
M2.0	WATER TREATMENT PLANT MECHANICAL FLOOR PLAN
M2.1	WATER SUPPLY PROCESS DIAGRAM
M2.2	PRESSURE FILTER ISOMETRIC
M2.3	TANK FILL AND DRAIN PROCESS SCHEMATIC
M2.4	PRESSURE FILTER DETAILS AND SECTIONS
M2.5	DRAIN WASTE AND VENT
M2.6	PIPE SUPPORT DETAILS
M2.7	CHLORINATION ROOM ASBESTOS
M2.8	INSTRUMENTATION AND CONTROL FEED PUMP DIAGRAM
M2.9	PIPE CURVES
M3.0	PIPE CURVES
M4.1	HVAC AND PLUMBING PLAN
M4.2	PLUMBING DETAILS
M4.3	EQUIPMENT LIST
M5.1	EQUIPMENT LIST
M5.2	EQUIPMENT LIST
M5.3	EQUIPMENT LIST
ELECTRICAL	
E1.0	ELECTRICAL LEGEND AND SCHEDULES
E2.0	ELECTRICAL PLANS AND DETAILS
E3.1	ELECTRICAL DIAGRAMS AND DETAILS
E3.2	ELECTRICAL DIAGRAMS AND DETAILS

RECORDED
 DEC 31 2013
 DEC
 Division of Water Quality
 Wastewater Discharge Program
Can't accept without documentation
Called on Dec 31, 2013
Br

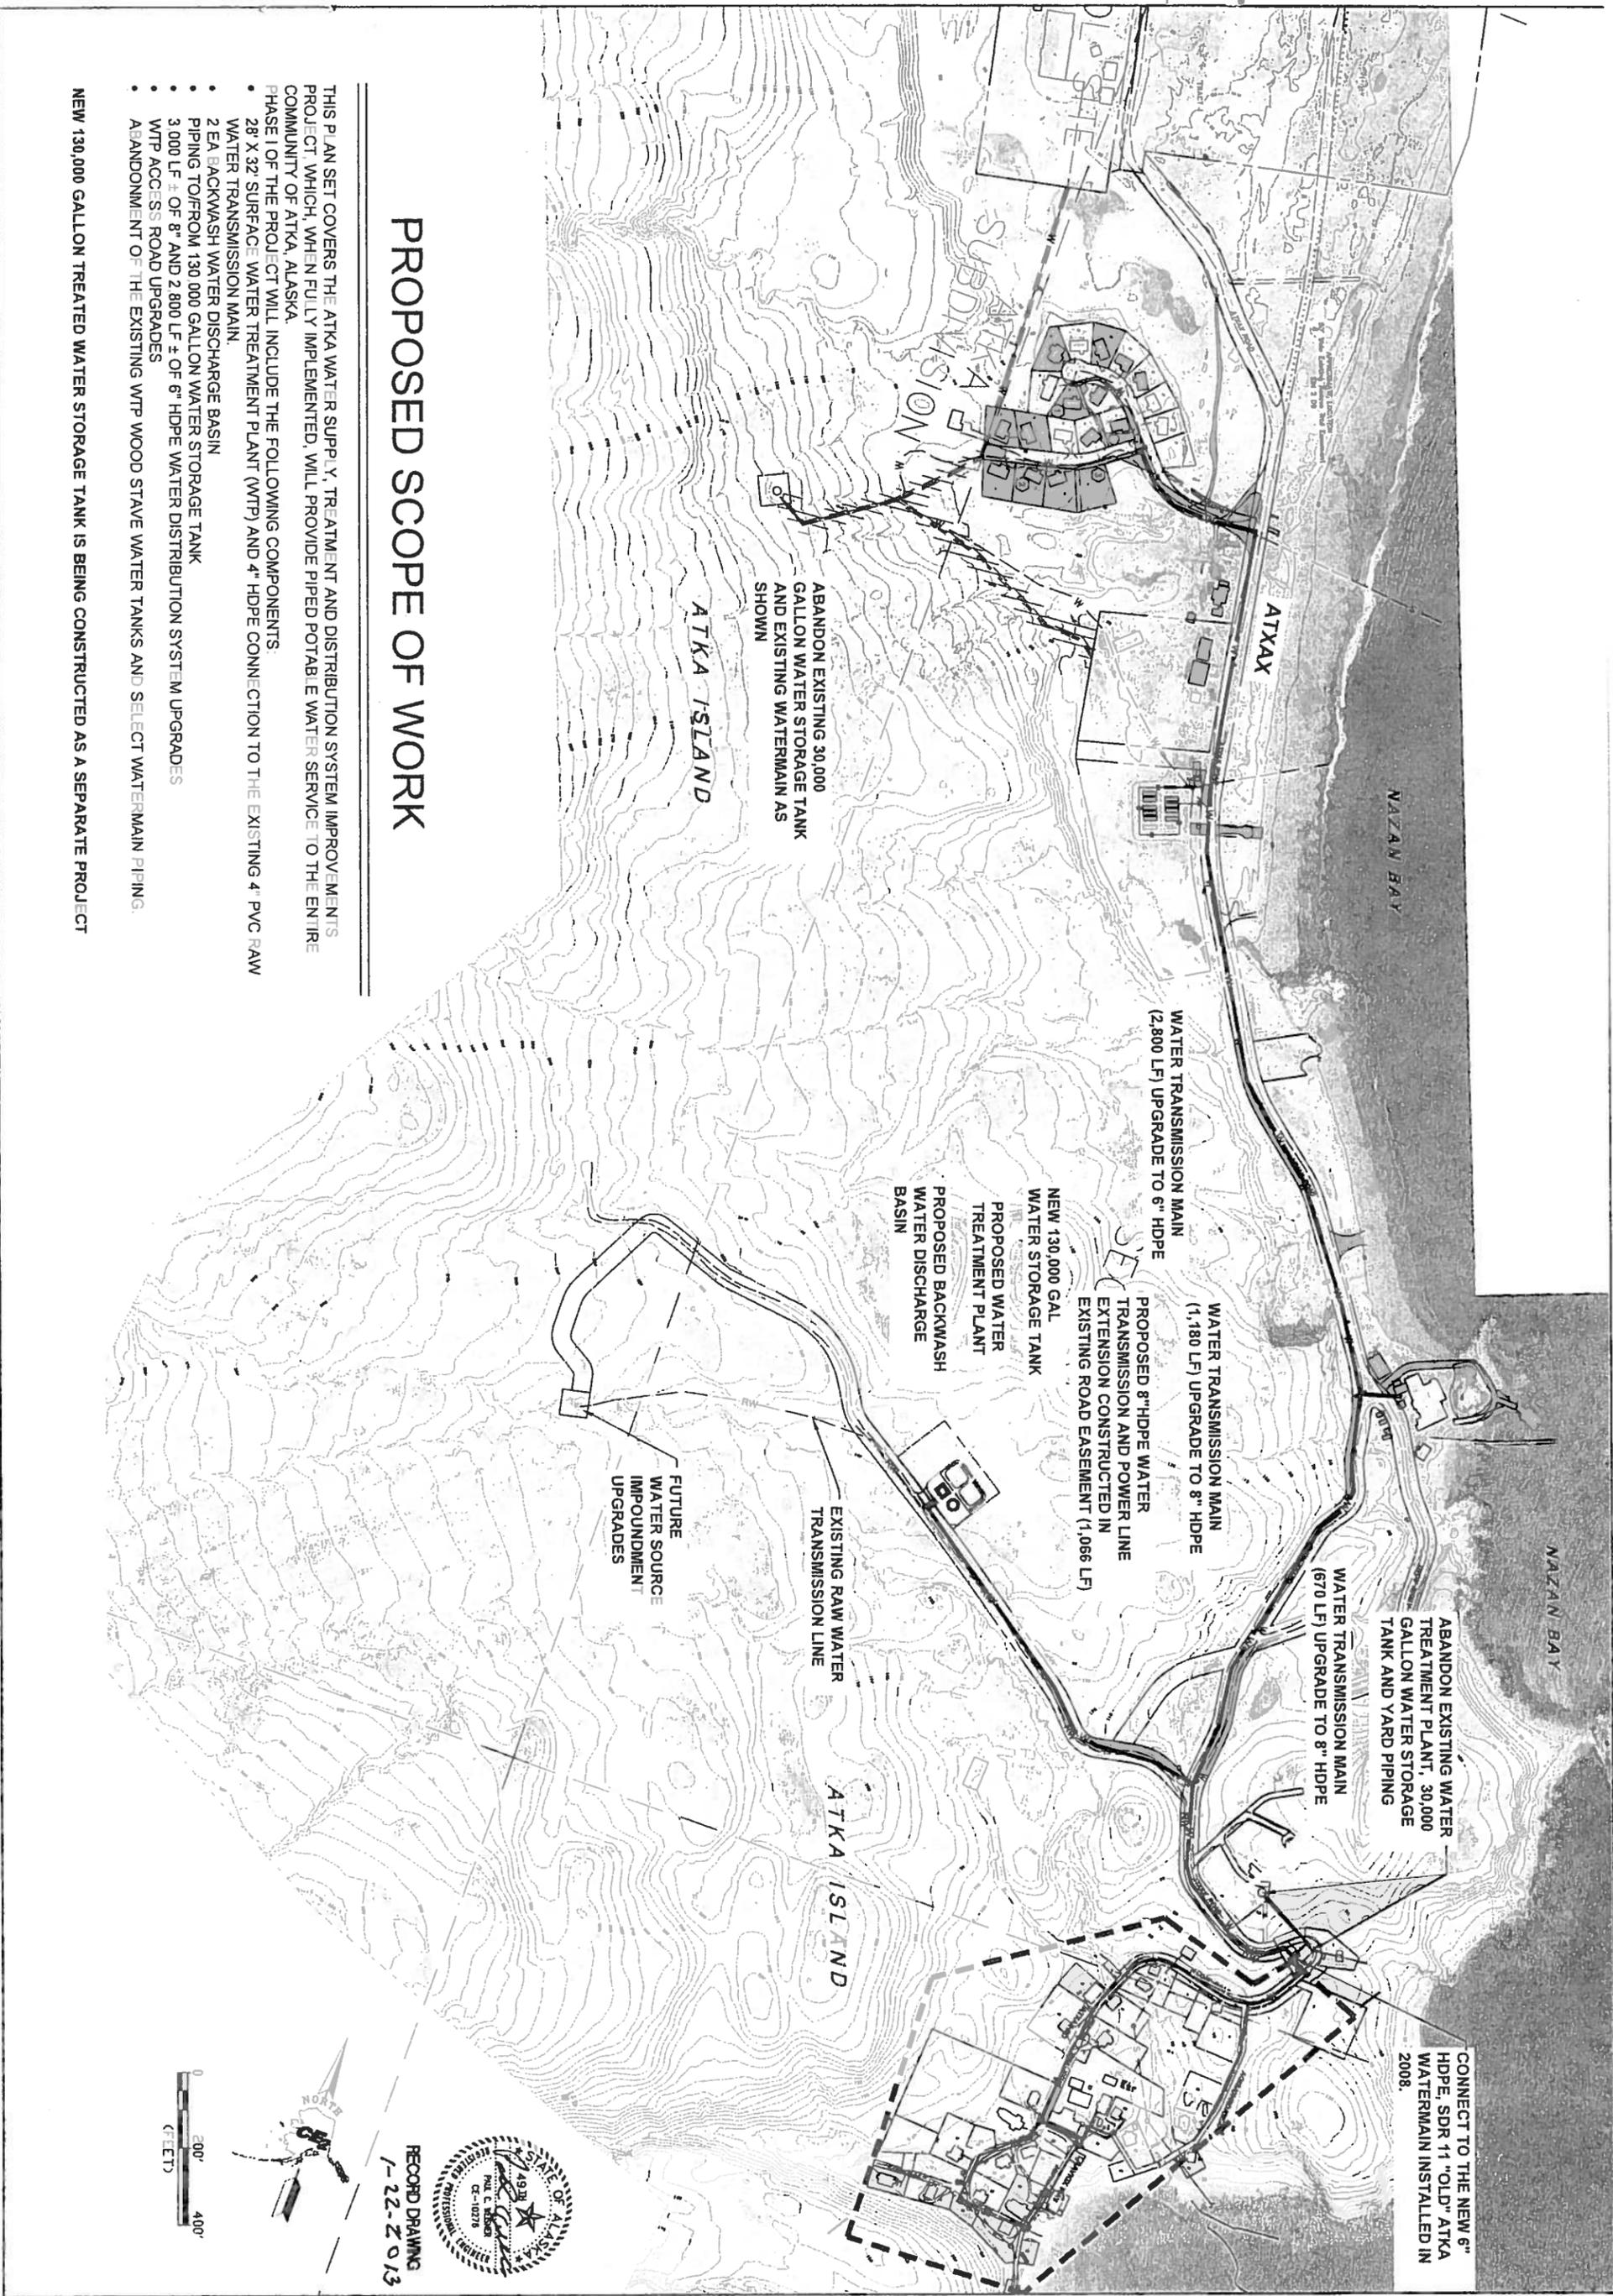


PROPOSED SCOPE OF WORK

THIS PLAN SET COVERS THE ATKA WATER SUPPLY, TREATMENT AND DISTRIBUTION SYSTEM IMPROVEMENTS PROJECT WHICH, WHEN FULLY IMPLEMENTED, WILL PROVIDE PIPED POTABLE WATER SERVICE TO THE ENTIRE COMMUNITY OF ATKA, ALASKA.

PHASE I OF THE PROJECT WILL INCLUDE THE FOLLOWING COMPONENTS:

- 28" X 32" SURFACE WATER TREATMENT PLANT (WTP) AND 4" HDPE CONNECTION TO THE EXISTING 4" PVC RAW WATER TRANSMISSION MAIN.
- 2 EA BACKWASH WATER DISCHARGE BASIN
- PIPING TO/FROM 130,000 GALLON WATER STORAGE TANK
- 3,000 LF ± OF 8" AND 2,800 LF ± OF 6" HDPE WATER DISTRIBUTION SYSTEM UPGRADES
- WTP ACCESS ROAD UPGRADES
- ABANDONMENT OF THE EXISTING WTP WOOD STAVE WATER TANKS AND SELECT WATERMAIN PIPING.

NEW 130,000 GALLON TREATED WATER STORAGE TANK IS BEING CONSTRUCTED AS A SEPARATE PROJECT

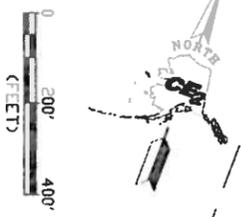

RECORD DRAWING
1-22-Z-013

Project No.	
Date	MAY 2010
Designed	LAP
Drawn	LAW
Approved	LAP

REVISION	BY	DATE

CE2 ENGINEERS, INC.
PO BOX 232848 ANCHORAGE, AK 99523 PH: 907-349-1010 FAX: 907-349-1915

2009 WATER SYSTEM UPGRADES

VICINITY MAP AND PROJECT LOCATIONS

ATKA, ALASKA



CONSTRUCTION RECORD	FIELD BOOK
STAKING	
FOREMAN	AS-BUILT
SPECTOR	

SCALE:

BAR IS ONE INCH OR ORIGINAL DRAWING

IF NOT ONE INCH ON THIS SHEET ADJUST SCALES ACCORDINGLY

RECORD DRAWING CERTIFICATE	
THESE DRAWINGS REFLECT RECORDED INFORMATION OBTAINED DURING CONSTRUCTION. INFORMATION PROVIDED HEREIN IS ACCURATE TO THE BEST OF MY KNOWLEDGE.	
NAME	DATE

GENERAL NOTES

1. ALL CONSTRUCTION SHALL BE DONE IN A SAFE WORKMANLIKE MANNER TO INDUSTRY STANDARDS AND IN CONFORMANCE WITH APPLICABLE LOCAL, STATE, AND FEDERAL CODES AND REGULATIONS.
 - A. WATERMAIN - 4 INCH, 6 INCH OR 8 INCH HOPE, SDR 11 CARRIER PIPE WITH BUTT FUSED JOINTS.
 - B. YARD PIPING - 6, 8 AND 10 INCH HOPE, SDR 11 CARRIER PIPE WITH BUTT FUSED JOINTS.
 - C. MECHANICAL ROOM PROCESS PIPING - SCH 80 PVC UNLESS OTHERWISE NOTED.
2. MATERIALS
3. THE BASIS OF VERTICAL CONTROL SHALL BE AS SHOWN ON SHEET G14.
4. THE BASIS OF HORIZONTAL CONTROL SHALL BE AS SHOWN ON SHEET G14.
5. EXISTING UTILITIES ARE SHOWN IN APPROXIMATE LOCATION OF THE ENGINEER AT THE TIME OF DESIGN. UTILITY RECORDS MAY NOT BE COMPLETELY ACCURATE. THE PROJECT SUPERINTENDENT SHALL VERIFY HORIZONTAL AND VERTICAL LOCATION OF UTILITIES WITHIN EACH CONSTRUCTION REACH PRIOR TO CONSTRUCTION. ALL UTILITIES ARE BURIED UNLESS OTHERWISE NOTED.
6. THE PROJECT SUPERINTENDENT SHALL BE RESPONSIBLE FOR MAINTAINING A CLEAN SET OF AS-BUILT FIELD LINE RECORD DRAWINGS SHOWING LOCATION AND SWING TIES TO ALL MANHOLES, CLEANOUTS, VALVES, BENDS, HEAT TRACE END SEALS, AND SERVICE LINE TAPS. ALL ELEVATIONS SHALL BE MARKED ASB (AS-BUILT) OR F.C. (FIELD CHANGED) WITH THE CORRECT VALUE INSERTED. DRAWINGS SHALL BE KEPT CURRENT IN RED PENCIL AND UPDATED DAILY IN A NEAT AND LEGIBLE FASHION. A COPY OF THE AS-BUILT DRAWINGS SHALL BE SUBMITTED TO THE ENGINEER FOR PREPARATION OF PROJECT RECORD DRAWINGS.
7. HORIZONTAL SEPARATION DISTANCE BETWEEN WATER AND SEWER MAINS SHALL BE TEN (10) FEET MINIMUM, AS MEASURED BETWEEN THE OUTSIDE OF THE CARRIER PIPES, UNLESS OTHERWISE NOTED. VERTICAL SEPARATION DISTANCE BETWEEN WATER MAINS AND SEWER MAINS, STORM DRAINS AND SERVICE LINES SHALL BE EIGHTEEN (18) INCHES MINIMUM, WHERE WATER MAINS CROSS SEWER MAINS OR STORM DRAINS. THE PROJECT SUPERINTENDENT SHALL STAGGER THE JOINTS FOR THE WATER PIPE SUCH THAT NO JOINT SHALL BE CLOSER THAN NINE (9) FEET FROM THE CENTERLINE CROSSING OF THE LINES. IT SHALL BE THE PROJECT SUPERINTENDENT'S RESPONSIBILITY TO MAINTAIN THESE SEPARATION DISTANCES AND TO NOTIFY THE ENGINEER IF EXTRAORDINARY MEASURES WILL BE REQUIRED TO ACHIEVE THE REQUIRED MINIMUM SEPARATION.
8. SEWER MANHOLE TOP-OF-CASTING ELEVATIONS SHALL BE SET SIX (6) INCHES BELOW FINAL GRADE IN ALL UNPAVED ROADS. SEWER MANHOLE TOP-OF-CASTING ELEVATIONS SHALL BE SET SIX (6) INCHES ABOVE FINISHED GRADE IN ALL UNDEVELOPED, UNTRAVELED AREAS.
9. EXISTING UTILITIES (WATER, SEWER, STORM, ETC.) THAT CONFLICT WITH THE PROPOSED PIPING SHALL BE REMOVED. ANY EXISTING UTILITIES TO BE ABANDONED IN PLACE SHALL HAVE OPEN ENDS(3) PLUGGED WITH CEMENT GROUT PRIOR TO CLOSURE OF THE DITCH. THE UPPER 3- FEET OF ALL MANHOLES TO BE ABANDONED IN PLACE SHALL BE REMOVED. TWO 6-INCH-DIAMETER DRAIN HOLE PENETRATIONS INSTALLED NEAR THE BASE AND THE BARREL SECTION AND BACKFILLED WITH PIT RUN MATERIAL PLACED IN 12-INCH LIFTS AND COMPACTED TO 95% OF THE MATERIALS RELATIVE DENSITY.
10. GENERAL RESTORATION - THE AREAS IMPACTED BY CONSTRUCTION SHALL BE RETURNED TO PRECONSTRUCTION CONDITIONS OR BETTER. CONSTRUCTION DEBRIS SHALL BE REMOVED FROM THE AREA AND DISPOSED OF IN AN APPROVED MANNER. DUE CARE AND CAUTION SHALL BE TAKEN TO AVOID DISTURBING PERSONAL PROPERTY.
11. THE ENTIRE EXCAVATION SITE SHALL BE ADEQUATELY PROTECTED, RESTRICTED, AND BARRICADED IN THE BEST PUBLIC INTERESTS OF HEALTH, SAFETY, AND WELFARE WITH VISIBLE AND STABLE BARRIERS, FLASHING YELLOW WARNING LIGHTS IN GOOD WORKING ORDER, UNDERSTANDABLE LARGE-PRINT WARNING SIGNS, AND OTHER PRECAUTIONARY EQUIPMENT AND MEASURES AS THE CITY MAY REQUIRE. ALL SAFETY MEASURES SHALL BE IN CONFORMANCE WITH APPLICABLE STATE OF ALASKA, DOT AND OSHA SAFETY REQUIREMENTS.
12. EARTHWORK
 - A. SAFETY CONSIDERATIONS - SIDEWALLS OF TRENCHES AND EXCAVATIONS SHALL BE SLOPED OR SUFFICIENTLY BRACED IN CONFORMANCE WITH SECTION 05.180 OF THE STATE OF ALASKA DEPARTMENT OF LABOR STANDARDS AND THE LATEST FEDERAL OSHA EXCAVATION AND TRENCHING STANDARDS TO PROVIDE A SAFE WORKING ENVIRONMENT. ALL TRENCHES SHALL BE BACKFILLED BEFORE WORK IS STOPPED FOR THE DAY. IF IT BECOMES NECESSARY TO LEAVE A PORTION OF THE EXCAVATION OPEN AND UNATTENDED, THE OPEN EXCAVATIONS SHALL BE ADEQUATELY SIGNED AND BARRICADED TO WARN RESIDENTS OF THE HAZARD.
 - B. VIBRATORY PLATE COMPACTOR SHALL TYPICALLY BE ACCOMPISHED BY USE OF A MECHANICAL DEVICE SUCH AS A VIBRATORY PLATE COMPACTOR OR SELF-PROPELLED VIBRATORY DRUM COMPACTOR. TRENCH ZONE BACKFILL ABOVE THE PIPE ZONE AND WITHIN ROADS OR OTHER TRAVELED WAYS SHALL BE COMPACTED IN 8 INCH MAXIMUM LIFTS TO THE DENSITY AS SHOWN ELSEWHERE IN THESE PLANS.
 - C. BACKFILL MATERIAL - MATERIAL WITHIN 8 INCHES OF THE PIPE SHALL BE 3/4" MINUS GRANULAR COMPACTIBLE PIT RUN MATERIAL AND SHALL CONFORM TO PROJECT ORGANIC MATERIAL, EXCEPT FOR THE MAXIMUM PARTICLE SIZE. THE REMAINING BACKFILL MATERIAL SHALL BE SIMILARLY RESTRICTED AND AS SHOWN IN THE PLANS.
 - D. EROSION CONTROL - EROSION CONTROL MEASURES SHALL BE INSTALLED AND MAINTAINED THROUGHOUT CONSTRUCTION.
 - E. SOIL CONDITIONS AT THIS SITE CONSIST OF A LAYER OF SURFACE ORGANICS AND SILTY OVER SILTY GRAVELS SURFACE ORGANICS AND SILTS ARE TO BE REMOVED AND REPLACED (IF NECESSARY) WITH COMPACTED GRAVEL.
 - F. BASED ON DUANE MILLER ASSOCIATES INVESTIGATION, A SOIL BEARING PRESSURE OF 3500 PSF WAS USED FOR DESIGN PURPOSES. IF SOIL CONDITION OTHER THAN THOSE REPORTED ARE ENCOUNTERED, CONTACT THE STRUCTURAL ENGINEER FOR EVALUATION.
 - G. UTILIZE A MINIMUM OF THREE PASSES OF A VIBRATORY PLATE COMPACTOR FOR BEST COMPACTON EFFORT. FOUNDATION FILL SHALL BE TESTED BY CONE PENETROMETER TO VERIFY COMPACTON CONSISTENCY.
13. SITE PREPARATION
 - A. ALL FILL PLACED BELOW FOOTINGS SHALL BE NON-FROST SUSCEPTIBLE GRANULAR MATERIAL, FREE OF ORGANIC MATTER AND DEBRIS PLACED IN LIFTS NOT EXCEEDING 12" IN LOGIC THICKNESS AND COMPACTED TO 95% OF MAXIMUM DENSITY IN ACCORDANCE WITH ASTM D-1557-4. ALL ORGANIC MATERIAL, FROZEN SOIL, LOOSE FILL, DEBRIS, AND REMNANTS OF PREVIOUS IMPROVEMENTS (FOUNDATIONS, SEPTIC TANKS, ETC.) SHALL BE REMOVED FROM THE WORK SITE PRIOR TO PLACING ANY STRUCTURAL FILL, MATS, SLABS OR FOOTINGS.
14. CONCRETE
 - A. CODE - CONCRETE WORK AND REINFORCEMENT SHALL CONFORM TO THE INTERNATIONAL BUILDING CODE (IBC) 2006 EDITION WITH THE FOLLOWING REQUIREMENTS OF THE AMERICAN CONCRETE INSTITUTE (ACI) 308, SPECIFICATIONS FOR STRUCTURAL CONCRETE FOR BUILDINGS EXCEPT AS MODIFIED BY THE NOTES HEREON. ALL MATTERS PERTAINING TO CONCRETE WORK WHENEVER THE IBC IS IN CONFLICT WITH THE REQUIREMENTS OF ACI 318-05.
 - B. CEMENT - ASTM C150, TYPE 1, HIGH EARLY STRENGTH.
 - C. AGGREGATE - SHALL MEET THE REQUIREMENTS OF ASTM C33.
 - D. CONCRETE STRENGTH - 28-DAY, 3,000 PSI COMPRESSIVE STRENGTH.
 - E. MAXIMUM AGGREGATE SIZE - 1-1/2".
 - F. SLUMP - 2" TO 4".
 - G. AIR ENTRAINMENT - 6% (±1%).
 - H. MIX DESIGN - MIX DESIGN IS REQUIRED UNLESS OTHERWISE APPROVED.
 - I. TESTING - TWO CONCRETE TEST CYLINDERS SHALL BE TAKEN DURING EACH CONCRETE POUR. CONCRETE STRENGTHS SHALL BE VERIFIED BY STANDARD 7 DAY AND 28 DAY CYLINDER TESTS UNLESS OTHERWISE APPROVED. PERFORM SLUMP WHENEVER CYLINDERS ARE TAKEN.
 - J. REINFORCING STEEL - ASTM A615 GRADE 60.
 - K. REINFORCING STEEL COVER - (UNLESS OTHERWISE NOTED) MINIMUM COVER, REQUIRED (INCHES)

LINE OF STEEL REINFORCEMENT	MINIMUM COVER, REQUIRED (INCHES)
SLAB BARS	1-1/2"
FOOTINGS AND SLAB BARS CAST ON GROUND	3"
 - L. CHAMBERS - EXCEPT AS OTHERWISE REQUIRED, EXPOSED CONCRETE CORNERS AND EDGES SHALL HAVE 3/4" CHAMBERS. RE-ENTRANT CORNERS SHALL NOT HAVE FILETS UNLESS OTHERWISE SHOWN.
 - M. STEEL WORK SHALL BE PERFORMED AS DESCRIBED IN CHAPTER 22 OF THE INTERNATIONAL BUILDING CODE.
 - N. STEEL SHALL BE OF THE GRADE NOTED BELOW.
 - A) 1) STRUCTURAL STEEL IS ASTM A588
 - 2) STEEL TUBE IS ASTM A500, GRADE B
 - O. BOLTS NOTED AS A.B. (ANCHOR BOLTS) AND M.B. (MACHINE BOLTS) SHALL CONFORM TO ASTM A307. HIGH STRENGTH BOLTS NOTED AS A325 AND A490 SHALL CONFORM TO DIVISION IV OF THE UBC CHAPTER 22.
 - P. WELDING SHALL CONFORM TO AWS D1.1:96. WELDS SHALL BE 3/16" MINIMUM UNLESS NOTED OTHERWISE. ELECTRODES SHALL BE AWS E70.
 - Q. METAL STUDS, JOISTS AND ACCESSORIES SHALL BE FORMED FROM GALVANIZED STEEL MEETING THE MINIMUM REQUIREMENTS OF ASTM A445 GRADE (F36) FOR JOISTS AND LIGHTER GALVANIZED COATINGS MUST MEET THE ASTM A593 SPECIFICATION.
 - R. ALL SECTION PROPERTIES SHALL BE BASED ON AMERICAN IRON AND STEEL INSTITUTE (AISI) "SPECIFICATIONS FOR THE DESIGN OF COLD-FORMED STEEL STRUCTURAL MEMBERS".
15. PRESSURE TESTING
 - A. ALL TESTS SHALL BE WITNESSED BY A REPRESENTATIVE DESIGNATED BY THE OWNER (CITY OF ATKA) UPON SUCCESSFUL COMPLETION OF A TEST THE RESULTS OF THE TEST SHALL BE DOCUMENTED ON A TEST FORM AND ACKNOWLEDGED BY SIGNATURE OF THE OWNER'S REPRESENTATIVE WITNESSING THE TEST AND BY THE CONTRACTOR. THE CONTRACTORS RED LINED AS-BUILT DRAWINGS AND DAILY FIELD REPORT SHALL ALSO NOTE, FOR EACH SEGMENT OF THE SYSTEM TESTED, THE TIME AND DATE OF THE TEST AND THE NAME OF THE OWNER'S WITNESS.
 - B. WATERMAIN TESTING - PERFORM HYDROSTATIC TESTING OF WATERMAINS. HYDROSTATIC TESTS SHALL BE PERFORMED AFTER OPEN BORE FLUSHING AND BEFORE DISINFECTION (SEE ITEM 17 BELOW). FILL THE LINE WITH WATER AND REMOVE AIR PRIOR TO STARTING THE TEST. PRESSURIZE TO 1.5 X OPERATING PRESSURE (60 PSI) + 120 PSI AND LEAVE FOR A MINIMUM OF 1 HOUR. AFTER THIS INITIAL PERIOD, ADD WATER TO BRING THE PRESSURE UP TO 120 PSI AND BEGIN A 1 HOUR TEST FOR THE WATERLINE TO BE ACCEPTED THE MAKE UP WATER REQUIRED TO RETURN THE PRESSURE TO 120 PSI AT THE END OF THE TEST PERIOD SHALL NOT BE GREATER THAN 0.4 GALLONS PER 100 FEET OF WATERMAIN OR 0.3 GALLONS PER 100 FEET OF WATERMAIN PLUS 0.1 GALLONS PER 60 FEET OF CIRCULATING WATER SERVICE LINE.
16. DISINFECTION PROCEDURES
 - A. WATER LINE DISINFECTION - ALL WATER DISTRIBUTION LINES SHALL BE DISINFECTED IN ACCORDANCE WITH THE REQUIREMENTS OF THE LATEST EDITION OF AWWA C651. THE METHOD OF CHLORINATION SHALL BE WITH THE SLUG METHOD AS DESCRIBED IN SECTION 5.3 OF THE STANDARD. AFTER DISINFECTION, THE WATER DISTRIBUTION LINES SHALL BE FLUSHED IN ACCORDANCE WITH THE REQUIREMENTS OF SECTION 6. HEAVILY CHLORINATED WATER SHALL BE NEUTRALIZED WITH A SOLUTION OF SODIUM BISULFITE OR SODIUM SULFITE AT A RATE TABULATED IN APPENDIX B OF THE STANDARD. THE SUPERINTENDENT IN CHARGE OF THE DISINFECTION AND FLUSHING OF THE LINES SHALL HAVE A COPY OF AWWA C651 ON SITE FOR READY REFERENCE.
 - B. WATER TREATMENT PLANT DISINFECTION - ALL PIPING IN THE WATER TREATMENT PLANT SHALL BE DISINFECTED IN ACCORDANCE WITH THE REQUIREMENTS OF THE LATEST EDITION OF AWWA C651 USING THE SLUG METHOD AS DESCRIBED IN SECTION 5.3 OF THE STANDARD. FILTERS R-1 AND R-2 SHALL BE DISINFECTED IN ACCORDANCE WITH THE LATEST EDITION AWWA C651 USING THE DISINFECTION METHOD DESCRIBED IN SECTION 5.2. THE SUPERINTENDENT SHALL HAVE A COPY OF AWWA C651 ON SITE FOR READY REFERENCE.
17. STORMWATER MANAGEMENT
 - A. CONSTRUCTION SHALL BE PLANNED AND EXECUTED TO EXPEDITIOUSLY COMPLETE THE PROJECT WHILE MAINTAINING THE CONSTRUCTION SITE IN A MANNER THAT REDUCES THE POTENTIAL FOR CONTAMINATED STORM RUNOFF. SPECIFIC STEPS ARE TO INCLUDE THE FOLLOWING:
 - PRIOR TO CONSTRUCTION DEVELOP A STORM WATER POLLUTION PREVENTION PLAN (SWPPP) WHICH FULFILLS THE BEST MANAGEMENT PRACTICES (BMPs) AND IS IN COMPLIANCE WITH THE NATIONAL POLLUTANT DISCHARGE ELIMINATION SYSTEM (NPDES) AND THE ALASKA CONSTRUCTION GENERAL PERMIT NO. AGR100000.
 - FILE A NOTICE OF INTENT (NOI) WITH THE STATE OF ALASKA A MINIMUM OF 7 DAYS PRIOR TO THE START OF CONSTRUCTION.
 - CONSTRUCTION SHALL BE VIGILANT WITH IMPLEMENTATION OF THE PLAN.
 - INSPECTIONS SHALL BE COMPLETED BY AN ALASKA GEOL. (CERTIFIED EROSION AND SEDIMENT CONTROL) LEAD IN ALASKA MUST BE FILED WITH THE STATE OF ALASKA WITHIN 30 DAYS OF REMOVAL OF TEMPORARY CONTROL DEVICES.
 - ALL RECORDS MUST BE KEPT FOR AT LEAST 3 YEARS.
 - B. PLANS AND OUTLINE SPECIFICATIONS - MINIMUM REQUIRED CONSTRUCTION QUALITY REQUIREMENTS ARE PRESENTED HEREIN. IT IS ASSUMED THAT INDUSTRY STANDARD PRACTICES CONSTRUCTION REQUIREMENTS AND LEVEL OF QUALITY SHALL BE MAINTAINED IN THE COURSE OF CONSTRUCTION. THE FOLLOWING ARE THE MINIMUM REQUIREMENTS:
 - INSPECTIONS AND REQUIRED CERTIFICATIONS - ANY CRITICAL OPERATION OR SPECIALTY TRADES (I.E. HOPE, THERMAL, BUTT FUSION PROCEDURE, CONSTRUCTION SURVEYING, ETC.) SHALL BE PERFORMED BY TRAINED PERSONNEL. QUALITY ASSURANCE INSPECTIONS AT REGULAR INTERVALS ARE ALSO ENCOURAGED.
 - QUALITY IS EVERYBODY'S RESPONSIBILITY - EVERY PROJECT CREW MEMBER IS RESPONSIBLE FOR THEIR OWN WORK. THEY SHOULD MAINTAIN THE HIGHEST QUALITY OF WORK STANDARDS POSSIBLE AND SHOULD BE WILLING TO SIGN EVERY COMPONENT INSTALLED.
18. CONSTRUCTION QUALITY
 - A. IT IS ASSUMED THAT CONSTRUCTION WILL BE PERFORMED BY SEMI-TRAINED OR IN-TRAINING CONSTRUCTION PERSONNEL. THEREFORE, ADHERENCE TO CONSTRUCTION PROCEDURES THAT ASSURE EVERY COMPONENT IS IN COMPLIANCE WITH QUALITY EXPECTATIONS IS REQUIRED. THE FOLLOWING MEASURES AND METHODS MUST BE USED BY THE CONSTRUCTION SUPERVISORS, PERSONNEL AND INSPECTORS AS APPROPRIATE:
 - PLANS AND OUTLINE SPECIFICATIONS - MINIMUM REQUIRED CONSTRUCTION QUALITY REQUIREMENTS ARE PRESENTED HEREIN. IT IS ASSUMED THAT INDUSTRY STANDARD PRACTICES CONSTRUCTION REQUIREMENTS AND LEVEL OF QUALITY SHALL BE MAINTAINED IN THE COURSE OF CONSTRUCTION.
 - INSPECTIONS AND REQUIRED CERTIFICATIONS - ANY CRITICAL OPERATION OR SPECIALTY TRADES (I.E. HOPE, THERMAL, BUTT FUSION PROCEDURE, CONSTRUCTION SURVEYING, ETC.) SHALL BE PERFORMED BY TRAINED PERSONNEL. QUALITY ASSURANCE INSPECTIONS AT REGULAR INTERVALS ARE ALSO ENCOURAGED.
 - QUALITY IS EVERYBODY'S RESPONSIBILITY - EVERY PROJECT CREW MEMBER IS RESPONSIBLE FOR THEIR OWN WORK. THEY SHOULD MAINTAIN THE HIGHEST QUALITY OF WORK STANDARDS POSSIBLE AND SHOULD BE WILLING TO SIGN EVERY COMPONENT INSTALLED.



RECORD DRAWING
1-22-2013


Project No. _____ Date: <u>MAY 2010</u> Designed: <u>LAP</u> Drawn: <u>DDR</u> Approved: <u>LAP</u>	 PO BOX 22206 ANCHORAGE, AK 99523 PH: 607-349-1010 FAX: 607-349-1015	2009 WATER SYSTEM UPGRADES GENERAL NOTES ATKA, ALASKA		CONSTRUCTION RECORD FIELD BOOK _____ STAKING _____ FOREMAN _____ AS-BUILT _____ INSPECTION _____	SCALE: 1" = 100' IF NOT ONE INCH ON THIS SHEET, SCALE AS ACCORDINGLY	RECORD DRAWING CERTIFICATE THESE DRAWINGS REFLECT RECORDED INFORMATION OBTAINED DURING CONSTRUCTION. INFORMATION PROVIDED HEREIN IS ACCURATE TO THE BEST OF MY KNOWLEDGE. NAME _____ DATE _____
---	---	---	--	---	--	---

Sheet No. G1.2

LEGEND

EXISTING	PROPOSED	DESCRIPTION
PLAN VIEW	PROFILE VIEW	GROUND SURFACE
PLAN VIEW	PROFILE VIEW	CREEK / DRAINAGE
PLAN VIEW	PROFILE VIEW	WATERMAIN GATE VALVE, HYDRANT (HYDRANT NOT SHOWN IN PROFILE VIEW)
PLAN VIEW	PROFILE VIEW	CULVERT
PLAN VIEW	PROFILE VIEW	BURIED ELECTRICAL LINE
PLAN VIEW	PROFILE VIEW	BURIED FUEL OIL LINE
PLAN VIEW	PROFILE VIEW	BURIED TELEPHONE LINE
PLAN VIEW	PROFILE VIEW	OVERHEAD ELECTRIC
PLAN VIEW	PROFILE VIEW	EASEMENT
PLAN VIEW	PROFILE VIEW	UTLIDOR
PLAN VIEW	PROFILE VIEW	FORCE MAIN
PLAN VIEW	PROFILE VIEW	UTILITY POLE (EXISTING LOCATION)
PLAN VIEW	PROFILE VIEW	UTILITY POLE (PROPOSED LOCATION)
PLAN VIEW	PROFILE VIEW	FENCE
PLAN VIEW	PROFILE VIEW	PROPOSED OR FUTURE GRAVEL TRAVELED WAY
PLAN VIEW	PROFILE VIEW	CONTOUR LINE
PLAN VIEW	PROFILE VIEW	R.O.W. (RIGHT-OF-WAY)
PLAN VIEW	PROFILE VIEW	SHORELINE
PLAN VIEW	PROFILE VIEW	TREES AND/OR BRUSH
PLAN VIEW	PROFILE VIEW	STRUCTURE
PLAN VIEW	PROFILE VIEW	NATURAL GROUND OR COMPACTED SOIL
PLAN VIEW	PROFILE VIEW	DIRECTION OF DRAINAGE
PLAN VIEW	PROFILE VIEW	PROPERTY LINE
PLAN VIEW	PROFILE VIEW	SECTION LINE
PLAN VIEW	PROFILE VIEW	ABANDONED VEHICLE
PLAN VIEW	PROFILE VIEW	BENCH MARK
PLAN VIEW	PROFILE VIEW	SPOT ELEVATION
PLAN VIEW	PROFILE VIEW	REBAR - ABILITY SURVEY POINT NO
PLAN VIEW	PROFILE VIEW	YELLOW PLASTIC CAP (REBAR)
PLAN VIEW	PROFILE VIEW	TRACT NUMBER
PLAN VIEW	PROFILE VIEW	LOT NUMBER
PLAN VIEW	PROFILE VIEW	TELEPHONE PEDestal
PLAN VIEW	PROFILE VIEW	HEAT TRACE ACCESS VAULT
PLAN VIEW	PROFILE VIEW	HEAT TRACE POWER SUPPLY
PLAN VIEW	PROFILE VIEW	WATER SERVICE CONNECTION (1 INCH DIAMETER UNLESS OTHERWISE INDICATED) TO THE WATERMAIN FINAL LOCATION TO BE DETERMINED IN THE FIELD AFTER COORDINATION WITH THE PROPERTY OWNER
PLAN VIEW	PROFILE VIEW	EXISTING WATER AND SEWER SERVICE LINE TO BE REMOVED FROM THE PUBLIC RIGHT OF WAY AND DISPOSED OF IN AN APPROVED MANNER

SECTION AND DETAIL DESIGNATIONS

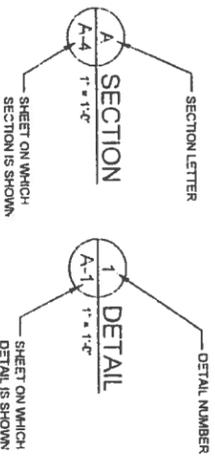

ABBREVIATIONS

AASHTO	AMERICAN ASSOCIATION OF STATE HIGHWAY AND TRANSPORTATION OFFICIALS	N	NORTH
APPROX	APPROXIMATE	NA	NOT APPLICABLE
ASTM	AMERICAN SOCIETY FOR TESTING AND MATERIALS	NOM	NOMINAL
BH	BORE HOLE	NTS	NOT TO SCALE
BLDG	BUILDING	OC	ON CENTER
BM	BENCH MARK	OD	OUTSIDE DIAMETER
BVC	BEGIN VERTICAL CURVE	PC	POINT OF CURVE
CAV	COMBINATION AIR RELEASE/ VACUUM RELIEF	PERF	PERFORATED
CL	CLEARING LIMIT	PI	POINT OF INTERSECTION
CLC	CENTER TO CENTER	PL	PLATE OR PROPERTY LINE
CC	CENTER TO CENTER	PPD	POUNDS PER DAY
CCF	CUBIC FEET PER SECOND	PPM	PARTS PER MILLION
CCF	CUBIC FEET PER SECOND	PRV	PRESSURE REDUCING VALVE
CMP	CORRUGATED METAL PIPE	PSF	POUND PER SQUARE FOOT
CMP	CORRUGATED METAL PIPE	PSI	POUND PER SQUARE INCH
CTS	CENTERS	PT	POINT OF TANGENT
CU	COPPER	PVC	POINT OF VERTICAL CURVE
CY	CUBIC YARD	PVT	OR POLYVINYL CHLORIDE
DET	DETAIL	QTY	POINT OF VERTICAL INTERSECTION
DI	DUCTILE IRON		POINT OF VERTICAL TANGENT
DIA	DIAMETER		
DWG	DRAWING		
EAC	EACH		
EVC	END VERTICAL CURVE		
EL	ELEVATION		
EXIST	EXISTING		
FDN	FOUNDATION	S	SOUTH, SLOPE
FF	FINISH FLOOR	SCH	SCHEDULE
FG	FINISH GRADE	SECT	SECTION
FPS	FEET PER SECOND	SHT	SHEET
FT	FOOT OR FEET	SS	SIMILAR
FTG	FOOTING	SS	STAINLESS STEEL OR SANITARY SEWER
GA	GAGE	STA	STATION
GALV	GALVANIZED	STD	STANDARD
GS	GROUND	STL	STEEL
GND	GROUND	TW	TREATED WATER
GPD	GALLONS PER DAY	TP	TYPICAL
GPM	GALLONS PER MINUTE	TP	TEST PIT
HDP	HIGH DENSITY POLYETHYLENE	UG	UNDERGROUND
HOR	HORIZONTAL	USGS	UNITED STATES GEOLOGICAL SURVEY
HPM	HIGHWAY PRECONSTRUCTION MANUAL	VC	VERTICAL CURVE
IE	INVERT ELEVATION	VER	VERTICAL
ID	INSIDE DIAMETER	VP	VERTICAL POINT OF INTERSECTION
IN	INCH OR INCHES	W	WITH
IP	IRON PIPE	WO	WITHOUT
LB	POUND	WS	WATER SURFACE
LBS	POUNDS	WT	WEIGHT
LF	LINEAR FEET	WVF	WELDED WIRE FABRIC
LI	LINE LOAD	X5	EXTRA STRONG
LL	LINE LOAD	YD	YARD
MAX	MAXIMUM		
MGL	MILLION GALLONS		
MIL	MILLIGRAMS PER LITER		
MIN	MINIMUM OR MINUTE		
MISC	MISCELLANEOUS		
MPH	MILES PER HOUR		



RECORD DRAWING
1-22-2012

Project No. _____ Date: MAY 2010 Designed: LAF Drawn: DDR Approved: LAF	REVISION BY DATE	 PO BOX 22296 ANCHORAGE, AK 99523 PH: 807-348-1010 FAX: 807-348-1015	2009 WATER SYSTEM UPGRADES ABBREVIATIONS AND CALLOUTS ATKA, ALASKA	CONSTRUCTION RECORD FIELD BOOK TAKING FOREMAN AS-BUILT INSPECTOR	SCALE: BAR IS ONE INCH ON THIS SHEET REPRESENTS ONE HUNDRED FEET IF NOT ONE INCH ON THIS SHEET, SCALES ACCORDINGLY	RECORD DRAWING CERTIFICATE THESE DRAWINGS REFLECT RECORDED INFORMATION OBTAINED DURING CONSTRUCTION. INFORMATION PROVIDED HEREIN IS ACCURATE TO THE BEST OF MY KNOWLEDGE. NAME _____ DATE _____
	Sheet No. G1.3		STATE OF ALASKA 49th CE-10278 PROFESSIONAL ENGINEER	FIELD BOOK TAKING FOREMAN AS-BUILT INSPECTOR	NAME _____ DATE _____	

DESIGN CRITERIA ATKA WATER TREATMENT PROJECT--ATKA, ALASKA

DESIGN LIFE (N) 20 YEARS
ANNUAL POPULATION GROWTH RATE (I) 2% ANNUALLY

CURRENT 2010 POPULATION (P) 61 PEOPLE (24 HOMES)
DESIGN 2030 POPULATION (F = P*(1+I)^N) 91 PEOPLE (36 HOMES)
DESIGN WATER DEMAND PER CAPITA 100 GPCD
DESIGN DAILY DOMESTIC WATER DEMAND 9,100 GAL/DAY
PROJECTED PEAK COMMERCIAL FLOW RATE 30 GAL/MINUTE
DESIGN DAILY COMMERCIAL WATER DEMAND 28,800 GAL/DAY (30 GPM x 16 HR/DAY)
DESIGN DAILY TOTAL WATER DEMAND 37,900 GAL/DAY
DESIGN PEAK HR. RESIDENTIAL FLOW (AVG Daily x 4.5) 28.5 GAL/MINUTE
DESIGN PEAK TOTAL FLOW (RES. + COM.) 58.5 GAL/MINUTE

PROPOSED VOLUME OF WATER STORAGE TANK 130,300 GAL
PROPOSED DAYS OF STORAGE 3 DAYS
PROPOSED BASE ELEVATION OF WST 177.0 FT ABOVE MLLW
PROPOSED OVERFLOW ELEVATION OF WST 196.0 FT ABOVE MLLW
CURRENT ELEVATION OF HIGHEST HOUSE 63± FT ABOVE MLLW
PROPOSED PRESSURE OF HIGHEST HOUSE 49 PSI
CURRENT ELEVATION OF LOWEST HOUSE 11.5± FT ABOVE MLLW
PROPOSED PRESSURE OF LOWEST HOUSE 80 PSI
PROPOSED ELEVATION OF FINISH FLOOR OF WTP 177.5 FT ABOVE MLLW
DESIGN PRESSURE OF RAW WATER INTO WTP 12 PSI
DESIGN FLOW RATE INTO WTP 42 GPM

FILTRATION, PRIMARY TYPE 2 PRESSURE MULTIMEDIA
FILTER DIAMETER 60" (EACH FILTER)
FILTER AREA 19.63 SQ FT
DESIGN FLOW RATE THROUGH PLANT 42 GPM
HYDRAULIC LOADING ON FILTERS 1.1 GPM/SQ FT
DESIGN FLOW RATE OF BACKWASH WATER (15 GPM/SQ FT) x (19.63 SQ FT) = 295 GPM
FILTER AIR SCOUR LOADING RATE 4 CFM/SQ FT
FILTER AIR SCOUR FLOW RATE 78.5 CFM PER FILTER

FILTER MEDIA
FREEBOARD (30" DEEP)
ANTHRACITE 1.0 to 1.1 MM PARTICLE SIZE (18" DEEP)
SUBANGULAR QUARTZ SAND 0.45 to 0.55 MM PARTICLE SIZE (12" DEEP)
FILTER GARNET #30 to #40 MESH PARTICLE SIZE (2" DEEP)
SUPPORT GARNET #8 to #12 MESH PARTICLE SIZE (2" DEEP)
SUPPORT GRAVEL 1/8 to 1/4 INCH (2" DEEP)
SUPPORT GRAVEL 1/4 to 1/2 INCH (2" DEEP)
SUPPORT GRAVEL 1/2 to 3/4 INCH (2" DEEP)
SUPPORT GRAVEL 3/4 to 1-1/2 INCH (TO TOP OF LATERALS ON UNDERDRAIN)
FILTRATION REMOVAL CREDIT -- ASSUMED 2.0 LOG

CHLORINE DISINFECTION CALCULATIONS

DISINFECTION - CALCIUM HYPOCHLORITE INJECTION
(FREE CHLORINE RESIDUAL)
INJECTION PUMP-LMI OR EQUAL

CT REQUIRED FOR 1.0 INACTIVATION CREDIT
CT FORMULA FROM ADEC 18AAC 80.655(b)
CT (Required) = (LOG INACTIVATION) (E^{vA}) (E^{vB}) (E^{vC})
E = 2.72
A = -0.0693 X TEMP (°C)
B = 0.361 X PH
C = 0.113 X CHLORINE CONCENTRATION (MG/L)
CHLORINE CONCENTRATION = 0.4 MG/L (FREE CHLORINE RESIDUAL)
PH = 7.8
TEMPERATURE = 5° C (41° F)
LOG INACTIVATION = 1.0
CT (Required) = 63 MG-MIN/L

ACTUAL CT OF SYSTEM

TANK BAFFLE FACTOR (BF) = 0.10
TANK INLET IS DISCHARGED
and DIFFUSED ON OPPOSITE SIDE OF TANK FROM OUTLET
TANK OUTLET IS OVERSIZED (12"), PROVIDING A REDUCED OUTLET VELOCITY
VOLUME OF TANK = 130,300 GALLONS
ASSUME TANK OPERATING RANGE of 20% (Approx. 4 Feet)
USABLE VOLUME FOR CT (80%) = (130,300 GAL) X 0.80 = 104,240 GAL
DESIGN PEAK HOURLY FLOW RATE = 58.5 GPM

CT (Actual) = (Usable Volume/Flow Rate)(BF)(C12 Concentration)
= (104,240 GAL/58.5 GPM)(0.1)(0.4 MG/L)
= 71 MG-MIN/L

CT (Actual) > CT (Required) : 71 MG-MIN/L > 63 MG-MIN/L = OK
CALCULATED MINIMUM TANK LEVEL 92,140 GALLONS OR APPROXIMATELY 70% OF THE TANK VOLUME.



RECORD DRAWING CERTIFICATE	
THESE DRAWINGS REFLECT RECORDED INFORMATION OBTAINED DURING CONSTRUCTION. INFORMATION PROVIDED HEREIN IS ACCURATE TO THE BEST OF MY KNOWLEDGE.	
NAME	DATE

SCALE:
BAR IS ONE INCH ON ORIGINAL DRAWING
IF NOT ONE INCH ON THIS SHEET ADJUST SCALES ACCORDINGLY

CONSTRUCTION RECORD	
FIELD BOOK	
STAKING	
POPEMAN	
AS-BUILT	
INSPECTOR	




2009 WATER SYSTEM UPGRADES	
PROJECT DESIGN AND CRITERIA	
ATKA, ALASKA	



REVISION	BY	DATE

Project No.	
Date	MAY 2010
Designed	LAMIRE
Drawn	DDR
Approved	LAMIRE


Sheet No.	G1.5
-----------	------

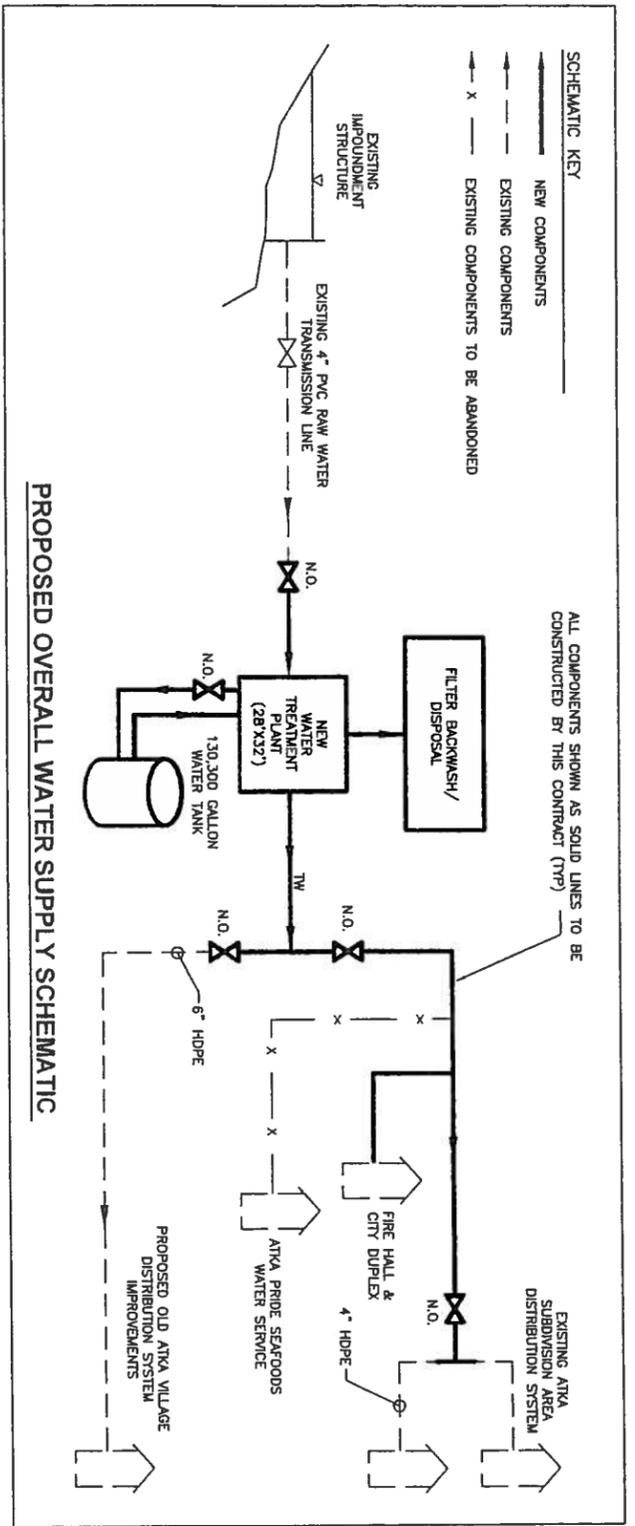

PROPOSED OVERALL WATER SUPPLY SCHEMATIC

SCHEMATIC KEY
 ——— NEW COMPONENTS
 - - - - - EXISTING COMPONENTS
 - X - - - EXISTING COMPONENTS TO BE ABANDONED

ALL COMPONENTS SHOWN AS SOLID LINES TO BE CONSTRUCTED BY THIS CONTRACT (TYP)

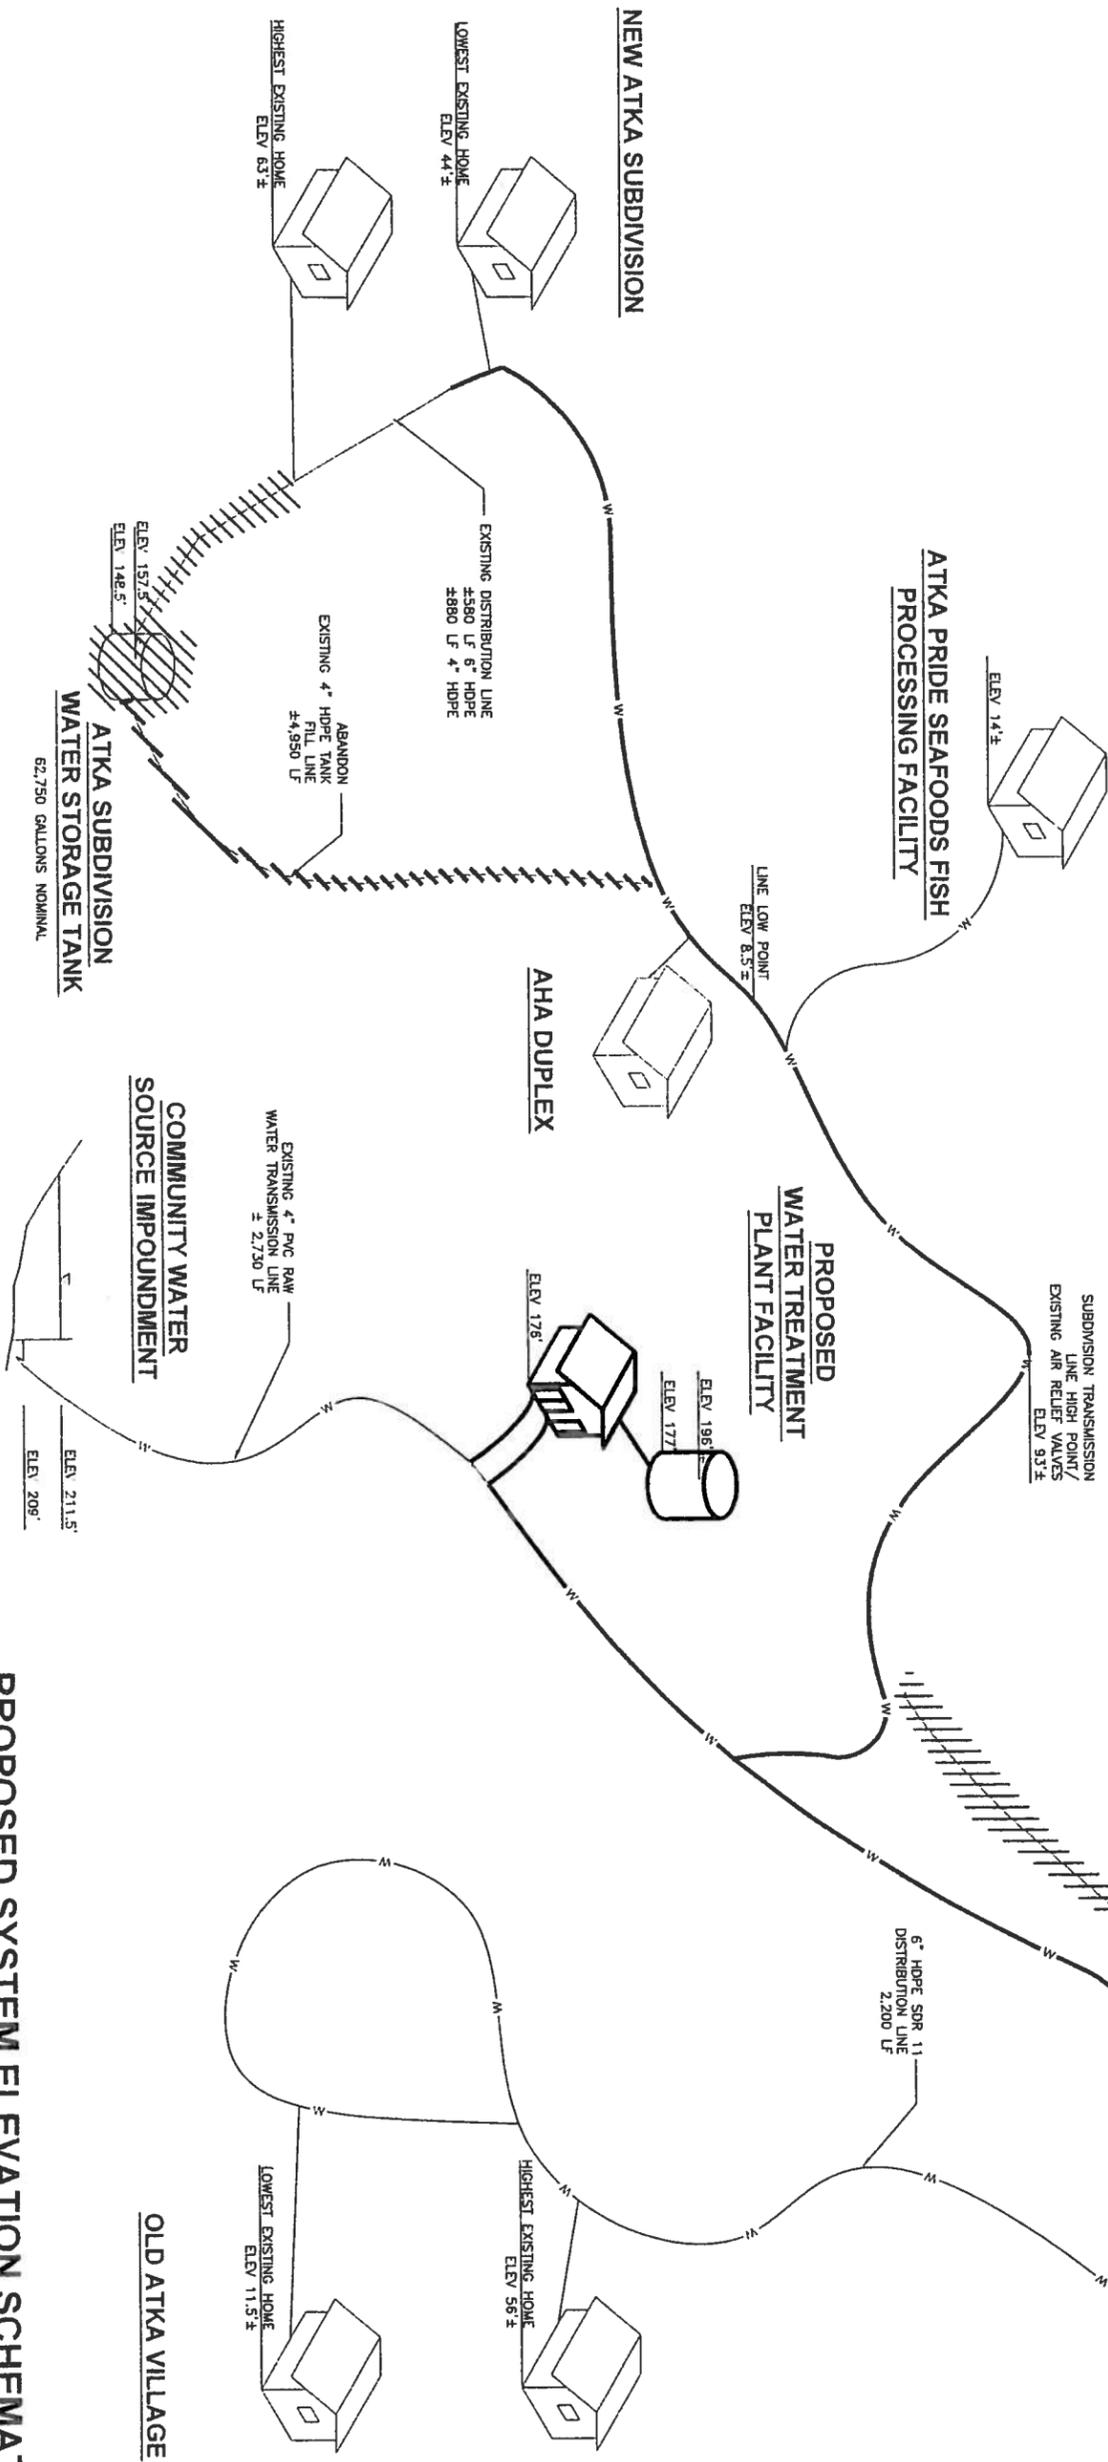

PROPOSED SYSTEM ELEVATION SCHEMATIC

TO BE ABANDONED
 OLD ATKA VILLAGE WATER STORAGE TANK

TO BE TRANSFERRED TO NATIVE
 VILLAGE OF ATKA EXISTING
 WATER TREATMENT PLANT



Project No.	
Date	MAY 2010
Designed	LAP
Drawn	LAW
Approved	LAP
Sheet No.	G1.6B

REVISION	BY	DATE





2009 WATER SYSTEM UPGRADES
 PROPOSED ELEVATION SCHEMATIC
 ATKA, ALASKA



CONSTRUCTION RECORD
FIELD BOOK
STAKING
FOREMAN
AS-BUILT
INSPECTOR

SCALE:
 1" = 100'
 1" = 100'

RECORD DRAWING CERTIFICATE	
THESE DRAWINGS REFLECT RECORDED INFORMATION OBTAINED DURING CONSTRUCTION INFORMATION PROVIDED HEREIN IS ACCURATE TO THE BEST OF MY KNOWLEDGE.	
NAME	DATE

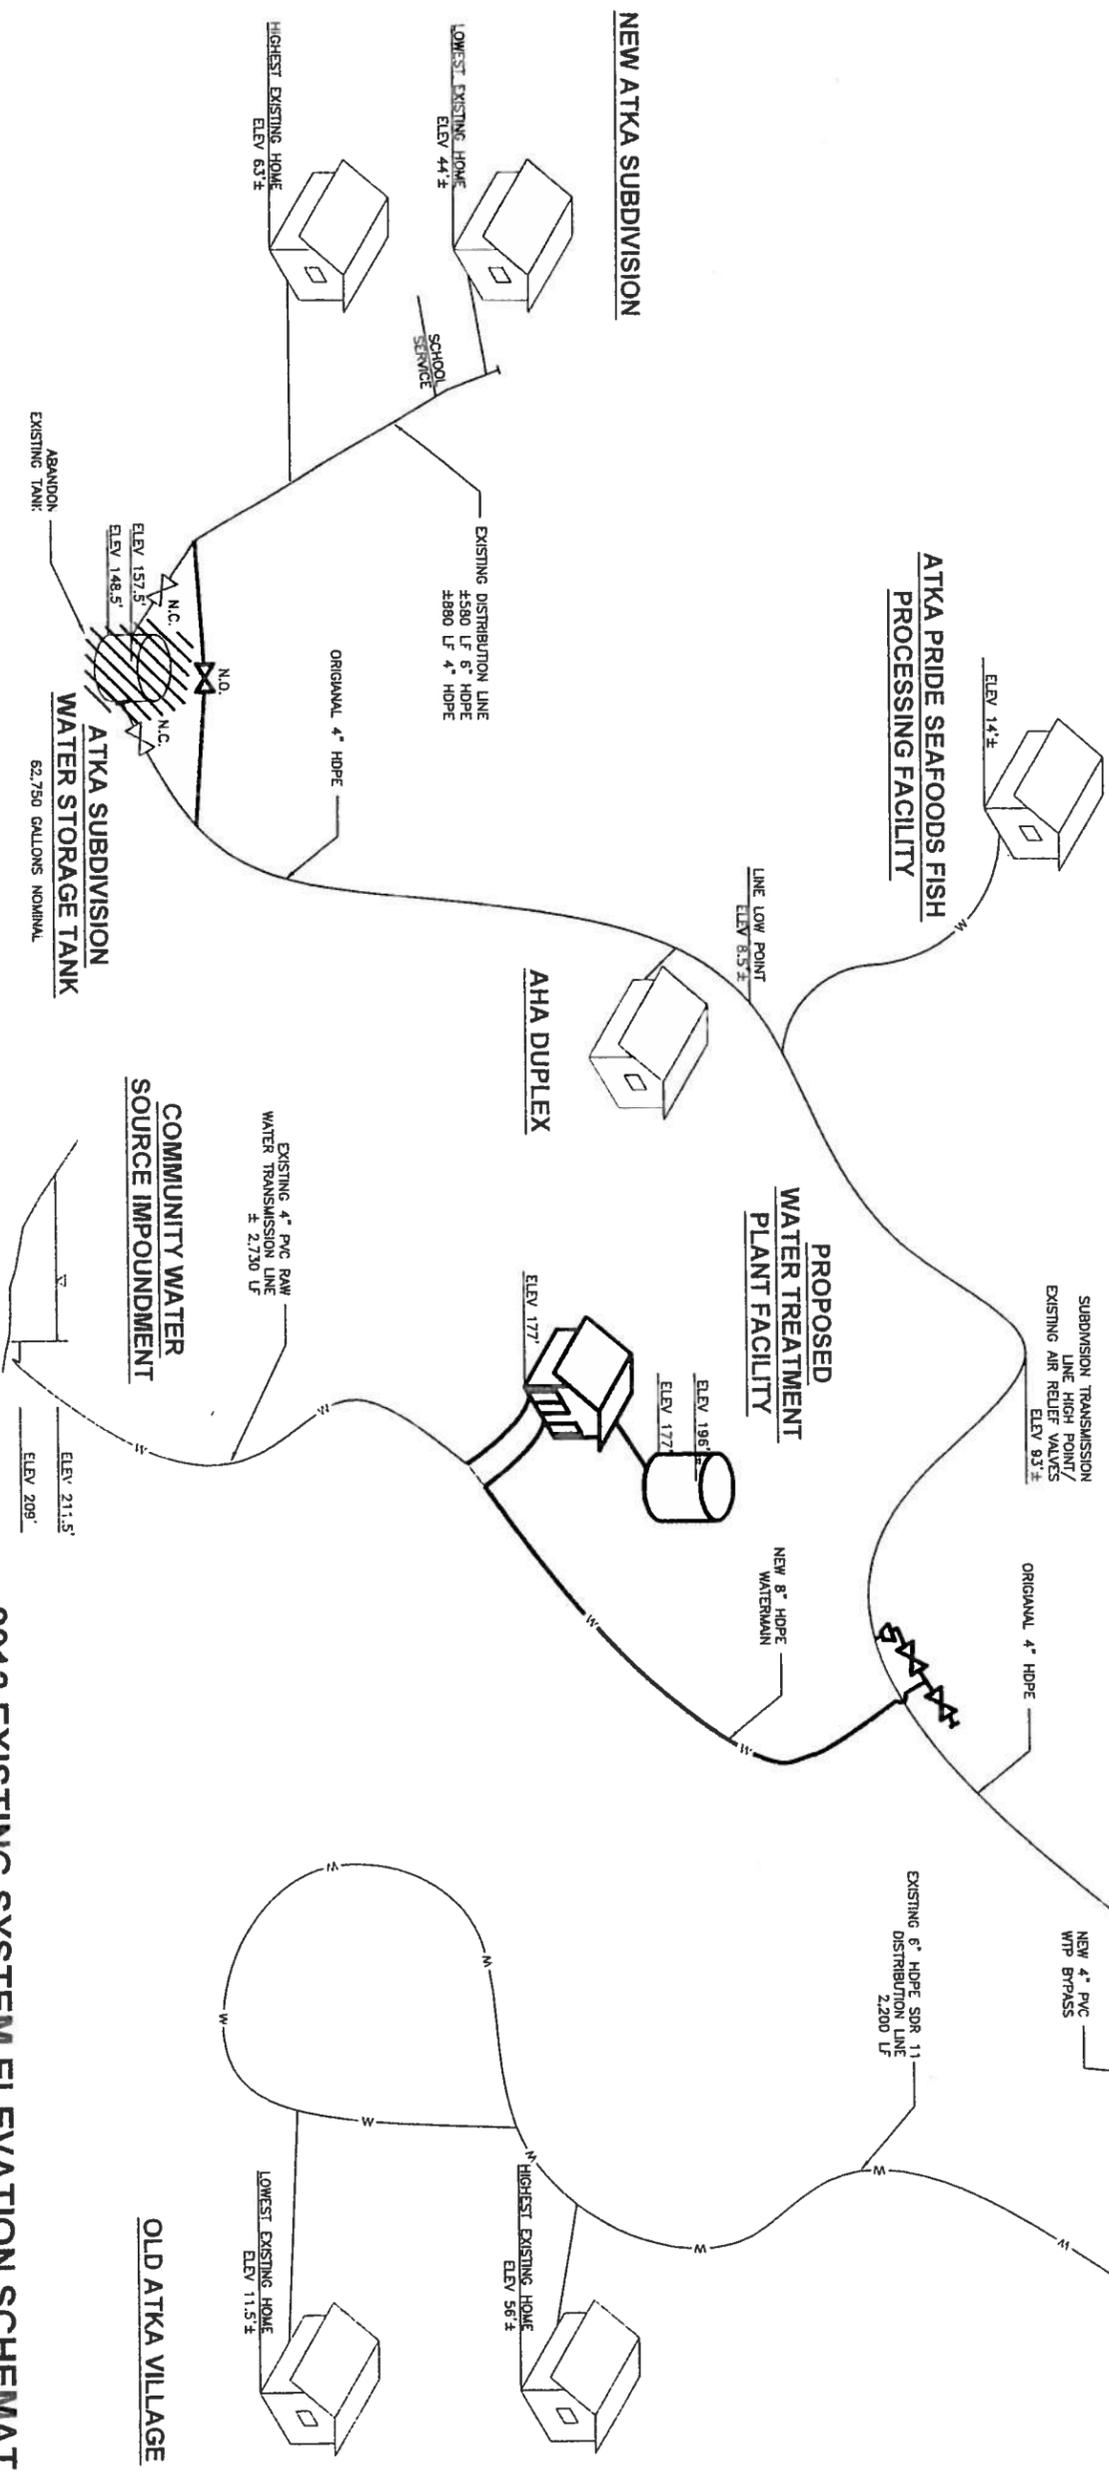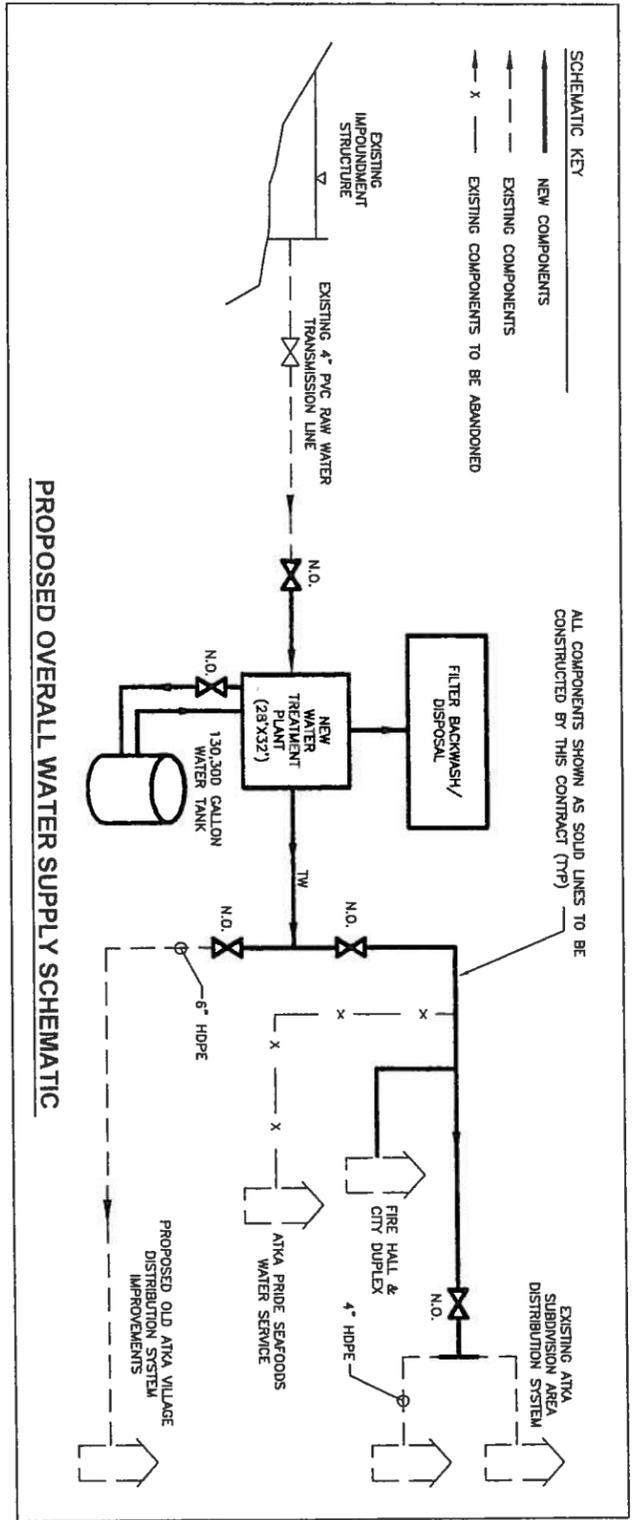

TO BE ABANDONED
OLD ATKA VILLAGE WATER
STORAGE TANK

TO BE TRANSFERRED TO MAINTAIN
VILLAGE OF ATKA EXISTING
WATER TREATMENT PLANT



RECORD DRAWING

2012 EXISTING SYSTEM ELEVATION SCHEMATIC

Project No.	
Date	MAY 2010
Designed	LAP
Drawn	LAW
Approved	LAP


REVISION	BY	DATE

CE2 ENGINEERS, INC.
PO BOX 232948 ANCHORAGE, AK 99523 PH: 907-349-1010 FAX: 907-349-1015

2009 WATER SYSTEM UPGRADES

2012 EXISTING ELEVATION SCHEMATIC

ATKA, ALASKA

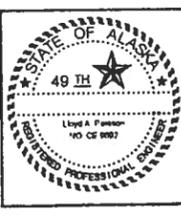


CONSTRUCTION RECORD
FIELD BOOK
STAKING
FOREMAN
AS-BUILT
INSPECTOR

SCALE:

1" = 80'

IF NOT ONE INCH ON THIS SHEET ADJUST SCALES ACCORDINGLY

RECORD DRAWING CERTIFICATE	
THESE DRAWINGS REFLECT RECORDED INFORMATION OBTAINED DURING CONSTRUCTION. INFORMATION PROVIDED HEREIN IS ACCURATE TO THE BEST OF MY KNOWLEDGE.	
NAME	DATE

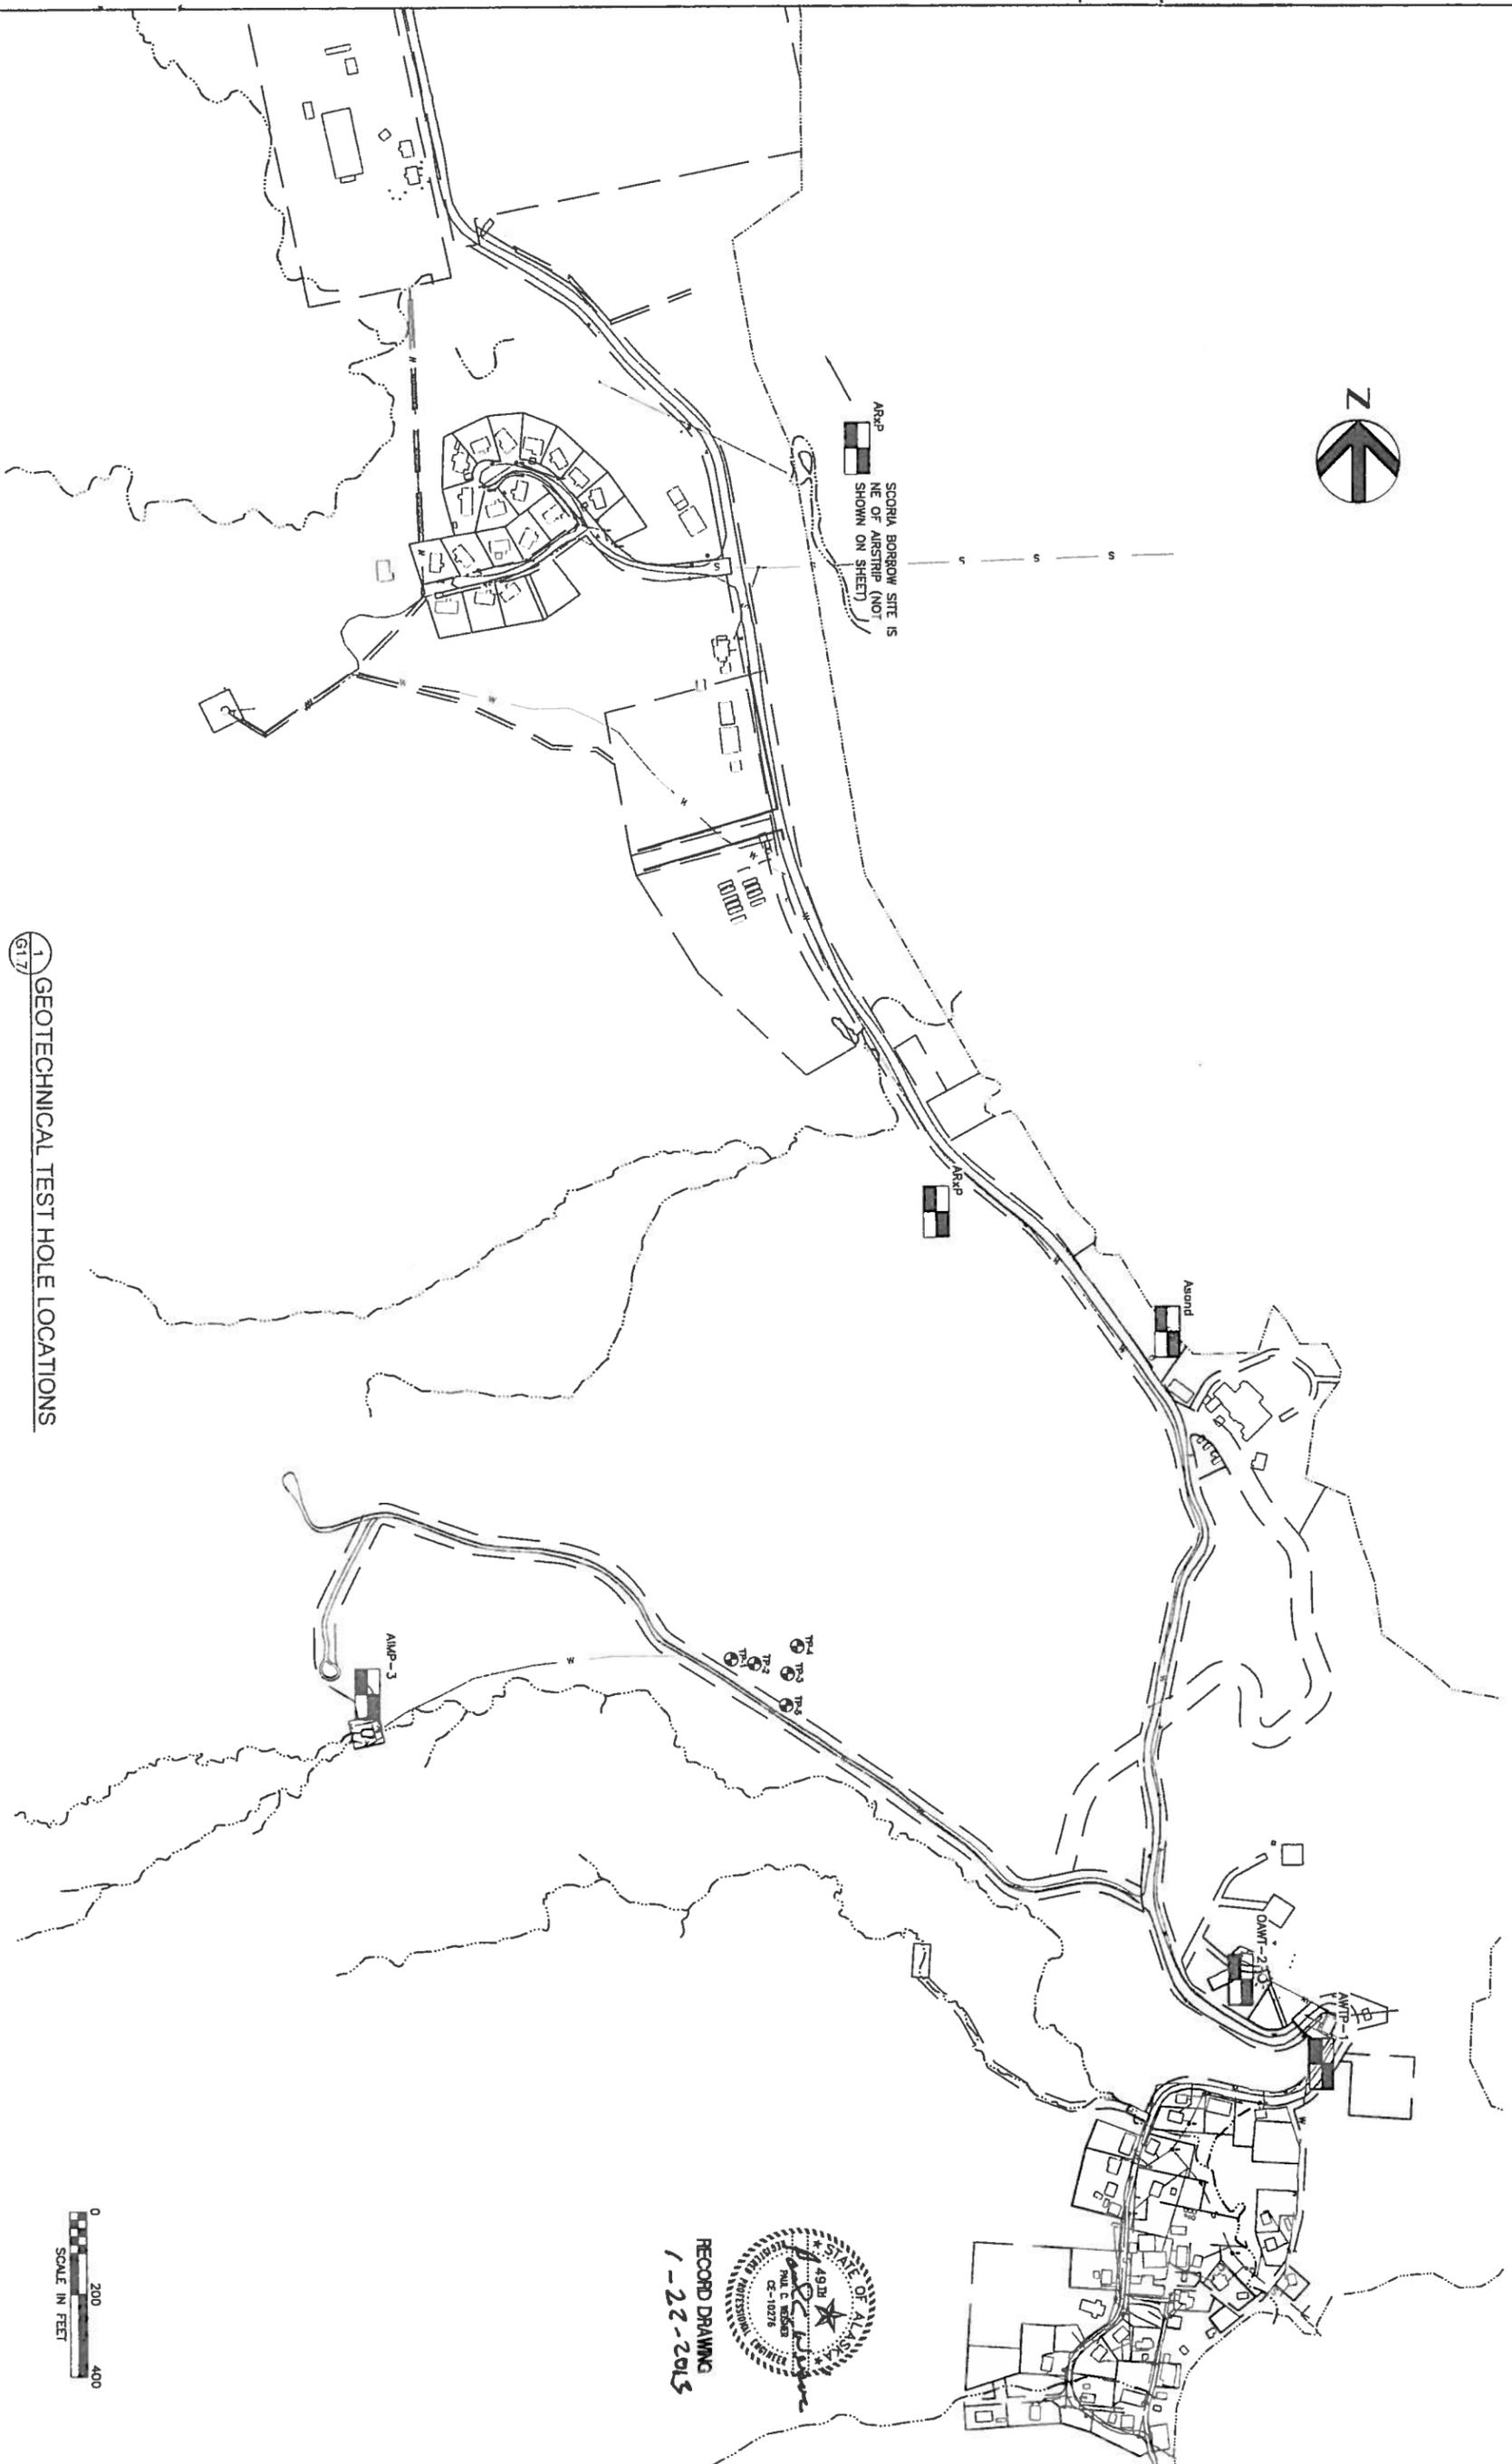


1 GEOTECHNICAL TEST HOLE LOCATIONS
G1.7

LEGEND

AMP-1 LOG HOLE BY DUANE MILLER - JUNE 2008 SEE SHEET G1.8 FOR SOIL LOGS AND DATA.
 AMP-2 LOG HOLE BY DUANE MILLER - SEPT. 2005 SEE SHEET G1.9 FOR SOIL LOGS AND DATA.
 AMP-3 LOG HOLE BY DUANE MILLER - JUNE 2008 SEE SHEET G1.8 FOR SOIL LOGS AND DATA.
 T1 LOG HOLE BY DUANE MILLER - SEPT. 2005 SEE SHEET G1.9 FOR SOIL LOGS AND DATA.
 T2 LOG HOLE BY DUANE MILLER - SEPT. 2005 SEE SHEET G1.9 FOR SOIL LOGS AND DATA.
 T3 LOG HOLE BY DUANE MILLER - SEPT. 2005 SEE SHEET G1.9 FOR SOIL LOGS AND DATA.
 T4 LOG HOLE BY DUANE MILLER - SEPT. 2005 SEE SHEET G1.9 FOR SOIL LOGS AND DATA.

SOURCE

TESTHOLE LOCATION AND CLASSIFICATION INFORMATION TAKEN FROM DUANE MILLER & ASSOCIATES GEOTECHNICAL INVESTIGATION FOR THE ATKA WATER PROJECT - MARCH 2006. TYPICAL FOR G1.8 & G1.9.

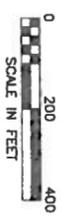

RECORD DRAWING
1-22-2015



Sheet No. G1.7	Project No.
	Date: MAY 2010
	Designed: LAP
	Drawn: DDR
	Approved: LAP

REVISION	BY	DATE

CE₂
ENGINEERS, INC.
PO BOX 222948 ANCHORAGE, AK 99523 PH: 907-349-1010 FAX: 907-349-1015

2009 WATER SYSTEM UPGRADES
GEOTECHNICAL TEST PIT LOCATIONS
ATKA, ALASKA




CONSTRUCTION RECORD
FIELD BOOK
STAKING
FOREMAN
AS BUILT
INSPECTOR

SCALE:
BAR IS ONE INCH ON ORIGINAL DRAWING
IF NOT ONE INCH ON THIS SHEET ADJUST SCALE AS APPROPRIATE

RECORD DRAWING CERTIFICATE	
THESE DRAWINGS REFLECT RECORDED INFORMATION OBTAINED DURING CONSTRUCTION. INFORMATION PROVIDED HEREIN IS ACCURATE TO THE BEST OF MY KNOWLEDGE.	
NAME	DATE

DUANE MILLER ASSOCIATES LLC

Project: Atka Water & Sewer Project
 DMA Job No.: 4149.035
 Logged By: N. Luzny

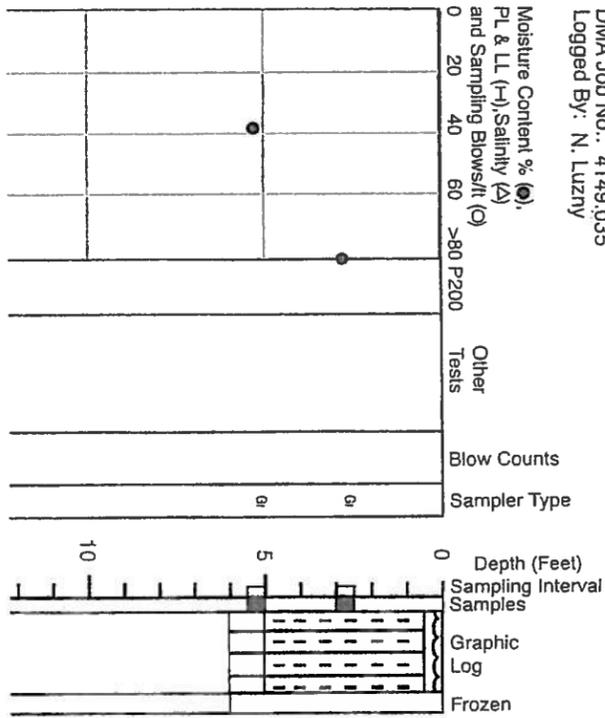

Log of HOLE: TP-05

Date Drilled: June 30, 2008
 Contractor: CE2
 Equipment: Hitachi Z 230 Excavator
 GPS Coord.: 52°12'09.064" N 174°12'08.794" W (WGS 84)
 Elevation: -

Description
PEAT (Pt) Live organic mat, grass roots
ORGANIC SILT (OL) Brown to orange-brown, moist, with peat (Pt) interbeds
GRAVELLY SILT (ML) Brown to orange-brown, moist, with subangular gravel to 1.5 inches and 5-10% subangular rock fragments to 2-foot diameter
Test pit completed at 6 feet on 6/30/2008

1 GEOTECHNICAL TEST HOLES
 G1.9


NOTE FOR TEST HOLE LOCATIONS SEE SHEET G1.7
 TP-4 LOG HOLE BY DUANE MILLER - JUNE 2008 - THIS SHEET
 AMP-1 LOG HOLE BY DUANE MILLER - SEPT 2005 SEE SHEET G1.5



Project No. Date: <u>MAY 2010</u> Designed: <u>LAP</u> Drawn: <u>DDR</u> Approved: <u>LAP</u>	REVISION BY DATE		 PO BOX 222946 ANCHORAGE, AK 99523 PH: 907-349-1010 FAX: 907-349-1015	2009 WATER SYSTEM UPGRADES GEOTECHNICAL INFORMATION ATKA, ALASKA		CONSTRUCTION RECORD FIELD BOOK STAKING FOREMAN AS-BUILT INSPECTOR	SCALE: 1" = 10'-0" IF NOT ONE INCH TO THE SHEET, ADJUST SCALE AS ACCORDANT	RECORD DRAWING CERTIFICATE THESE DRAWINGS REFLECT RECORDED INFORMATION OBTAINED DURING CONSTRUCTION INFORMATION PROVIDED HEREIN IS ACCURATE TO THE BEST OF MY KNOWLEDGE. NAME _____ DATE _____
	Sheet No. G1.9							


DUANE MILLER & ASSOCIATES

Project: Atka Water Project
 DM&A Job No.: 4086.055
 Logged By: L. Siliphant
 Moisture Content % (w),
 PL & LL (L+); Salinity (A)
 and Sampling Blows/ft (C)

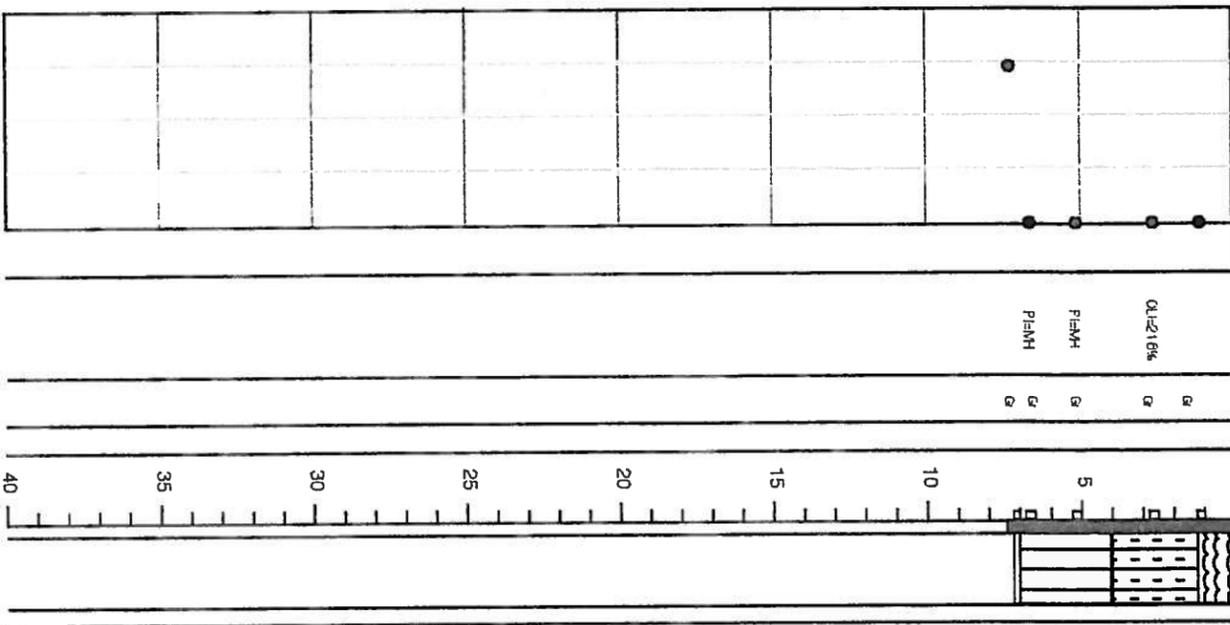

Log of HOLE: AWTP-1
 Date Drilled: 9/1/05
 Contractor: City of Atka
 Equipment: Caterpillar 420D
 GPS Coord.: N 52°12'00.7" W 174°11'48.2" NAD 83
 Elevation: 67'

Description
 Peat (Pt) Brown, fibrous, soft, wet.
 Organic Silt (OL) Brown to red-brown, fibrous, w/ trace fine sand, soil, wet, (ast), water slowly dripping into test pit, 2.5" tan silty ash layer at 2.8'
 Sandy Silt (MH) Light brown, w/ some fibrous organics (roots), wet, plastic (ast)
 Red, medium silt, moist, plastic below 6'
 Bedrock (Rock) Green, cobble size pieces of volcanic rock to 6", w/ brown and gray clay interspersed between pieces of bedrock; moist
 Bottom of test pit at 7.2'. Note: sides of test pit slumping into hole due to high moisture content in the soil.

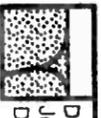


Duane Miller & Associates
 Job No.: 4086.055
 Date: March 2006

LOG of TEST Test Hole AWTP-1
 Atka Water Project
 Atka, Alaska

Plate 2

DUANE MILLER & ASSOCIATES

Project: Atka Water Project
 DM&A Job No.: 4086.055
 Logged By: L. Siliphant
 Moisture Content % (w),
 PL & LL (L+); Salinity (A)
 and Sampling Blows/ft (C)

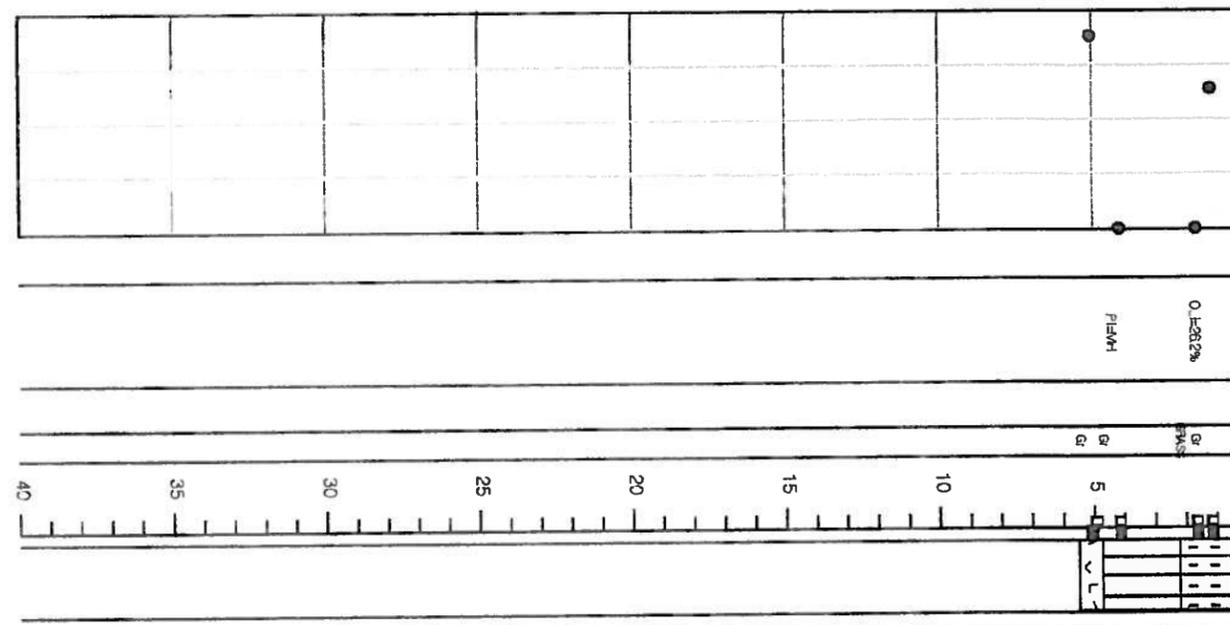

Log of HOLE: CAWT-2
 Date Drilled: 9/1/05
 Contractor: City of Atka
 Equipment: Caterpillar 420D
 GPS Coord.: N 52°12'02.2" W 174°11'50.6" NAD 83
 Elevation: 109'

Description
 Peat (Pt) Red-brown, fibrous, soft
 Organic Silt (OL) Black, w/ some fibrous organics (roots), w/ trace fine to medium sand, soil, dry (ast)
 Sandy Silt (MH) Red, medium silt, moist, plastic, hard to get out of bucket, (ast)
 Bedrock (Rock) Black and green cobble size pieces of bedrock to 4" (andesite), w/ tan clay interspersed between pieces of bedrock.
 Bottom of test pit at 5.5'



Duane Miller & Associates
 Job No.: 4086.055
 Date: March 2006

LOG of TEST Test Hole CAWT-2
 Atka Water Project
 Atka, Alaska

Plate 3

1 GEOTECHNICAL TEST HOLES

NOTE FOR TEST HOLE LOCATIONS SEE SHEET G1.7
 TP-4 LOG HOLE BY DUANE MILLER - JUNE 2008 SEE SHEET G1.8
 AWP-1 LOG HOLE BY DUANE MILLER - SEPT 2005 - THIS SHEET



Project No: <u> </u> Date: <u> MAY 2010 </u> Designer: <u> LAP </u> Drawn: <u> DDR </u> Approved: <u> LAP </u>	REVISION BY DATE	 PO BOX 232946 ANCHORAGE, AK 99523 TEL: 907-349-1010 FAX: 907-349-1015	2009 WATER SYSTEM UPGRADES GEOTECHNICAL INFORMATION ATKA, ALASKA		CONSTRUCTION RECORD FIELD BOOK STAKING FOREMAN AS-BUILT INSPECTOR	SCALE: 1" = 10' (SEE PLAN FOR THIS SHEET & ADJUST SCALES ACCORDINGLY)	RECORD DRAWING CERTIFICATE THESE DRAWINGS REFLECT RECORDED INFORMATION OBTAINED DURING CONSTRUCTION. INFORMATION PROVIDED HEREIN IS ACCURATE TO THE BEST OF MY KNOWLEDGE. NAME: _____ DATE: _____
	Sheet No: G1.10						

Test Hole	Sample Depth	Soil Type (USCS)	Thermal State	Sampler Type	Moisture Content	Dry Density	Organic Loss	Salinity	Passing #200	Other Tests
AWTP-1	1.0 ft	Pt	Unfrozen	Gr	164.7%		22%			
AWTP-1	2.5 ft	OL	Unfrozen	Gr	208.3%					
AWTP-1	5.0 ft	MH	Unfrozen	Gr	102.0%					PI
AWTP-1	6.5 ft	MH	Unfrozen	Gr	124.1%					PI
AWTP-1	7.2 ft	ROCK	Unfrozen	Gr	22.0%					
OAWT-2	1.0 ft	ML	Unfrozen	Gr	28.9%					
OAWT-2	1.5 ft	OL	Unfrozen	Brass	154.2%	26 pcf	26%			
OAWT-2	4.0 ft	MH	Unfrozen	Gr	220.5%					PI
OAWT-2	4.9 ft	ROCK	Unfrozen	Gr	9.8%					
AIMP-3	1.0 ft	OL	Unfrozen	Gr	44.1%					
AIMP-3	3.0 ft	MH	Unfrozen	Gr	140.4%					PI
AIMP-3	7.0 ft	CL + Rock	Unfrozen	Gr	38.5%					
AIMP-3	8.5 ft	CL + Rock	Unfrozen	Gr	33.4%					
AWTP-SE	1.5 ft	SP	Unfrozen	Gr	69.3%			0 ppt		
NAWT-4	1.6 ft	ML	Unfrozen	Gr	137.9%					
NAWT-4	1.0 ft	OL	Unfrozen	Gr	154.2%					
DAM-5	1.5 ft	OL	Unfrozen	Gr	159.1%					
ASCP-1	0.0 ft	GW-GM	Unfrozen	Gr	8.5%				6.8%	
ASCP-2	0.0 ft	GW-GM	Unfrozen	Gr						
Asand-1	0.0 ft	SP	Unfrozen	Gr	6.0%			0 ppt	0.3%	
ARRP-1	0.0 ft	Rock	Unfrozen	Gr						


Duane Miller & Associates
Job No. 4086.055
March 2006

SUMMARY OF SAMPLES
Atka Water Project
Atka, Alaska

Plate 6

Depth =>	ASCP-1 0.0 ft	Asand-1 0.0 ft
3" =>	100%	100%
1.5" =>	77%	100%
3/4" =>	53%	100%
3/8" =>	41%	100%
#4 =>	35%	100%
#10 =>	29%	100%
#20 =>	22%	100%
#40 =>	17%	93%
#60 =>	13%	23%
#100 =>	10%	1%
#200 =>	6.8%	0.3%

Analysis of Data
 D10 size => 0.153 mm
 D30 size => 2.329 mm
 D50 size => 16.197 mm
 D60 size => 23.371 mm
 Coeff. of Uniformity, Cu = 152.27
 Coeff. of Curvature, Cc = 1.51
 Gravel (+#4) percentage = 65.3%
 AASHTO Gravel (+#10) = 71.0%
 Sand percentage = 27.9%
 Fines percentage = 6.8%
 Unified Soil Class Symbol = GW-G

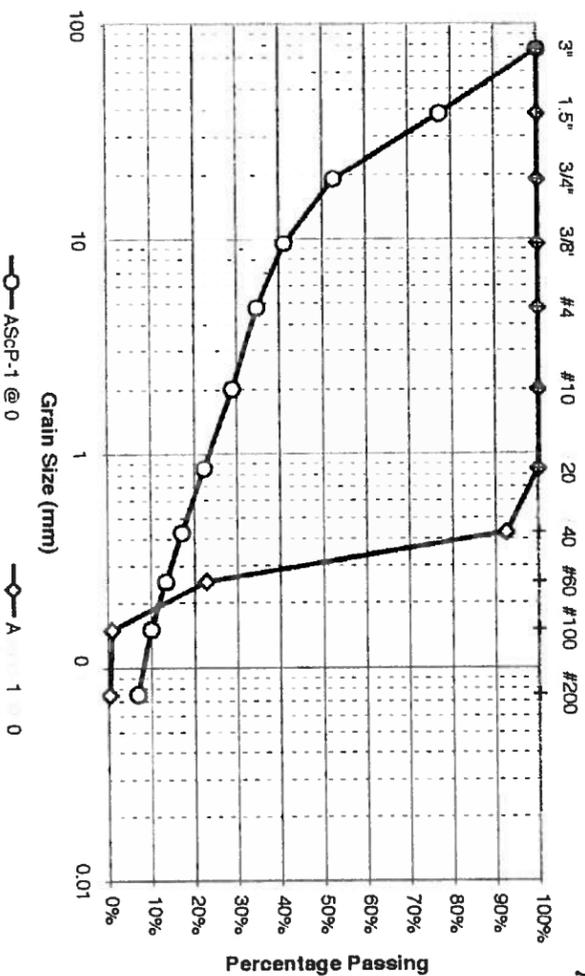

Duane Miller & Associates
Job No. 4086.055
March 2006

PARTICLE SIZE DATA
Atka Water Project
Atka, Alaska

Plate 7

1 GEOTECHNICAL TEST HOLES


NOTE FOR TEST HOLE LOCATIONS SEE SHEET G1.12

LOG HOLE BY DUANE MILLER - JUNE 2008 SEE SHEET G1.8
LOG HOLE BY DUANE MILLER - SEPT. 2005 - THIS SHEET



RECORD DRAWING
1-22-2013

Project No. _____ Date MAY 2010 Designed LAP Drawn DDR Approved LAP	REVISION BY DATE	 PO BOX 232945 ANCHORAGE, AK 99523 P/E: 907-348-1010 FAX: 907-348-1015	2009 WATER SYSTEM UPGRADES GEOTECHNICAL INFORMATION ATKA, ALASKA		CONSTRUCTION RECORD FIELD BOOK STAKING FOREMAN AS-BUILT INSPECTOR	SCALE: 1" = 10' IF NOT ONE INCH ON THIS SHEET ADJUST SCALES ACCORDINGLY	RECORD DRAWING CERTIFICATE THESE DRAWINGS REFLECT RECORDED INFORMATION OBTAINED DURING CONSTRUCTION. INFORMATION PROVIDED HEREIN IS ACCURATE TO THE BEST OF MY KNOWLEDGE. NAME _____ DATE _____
					Sheet No. G1.12		

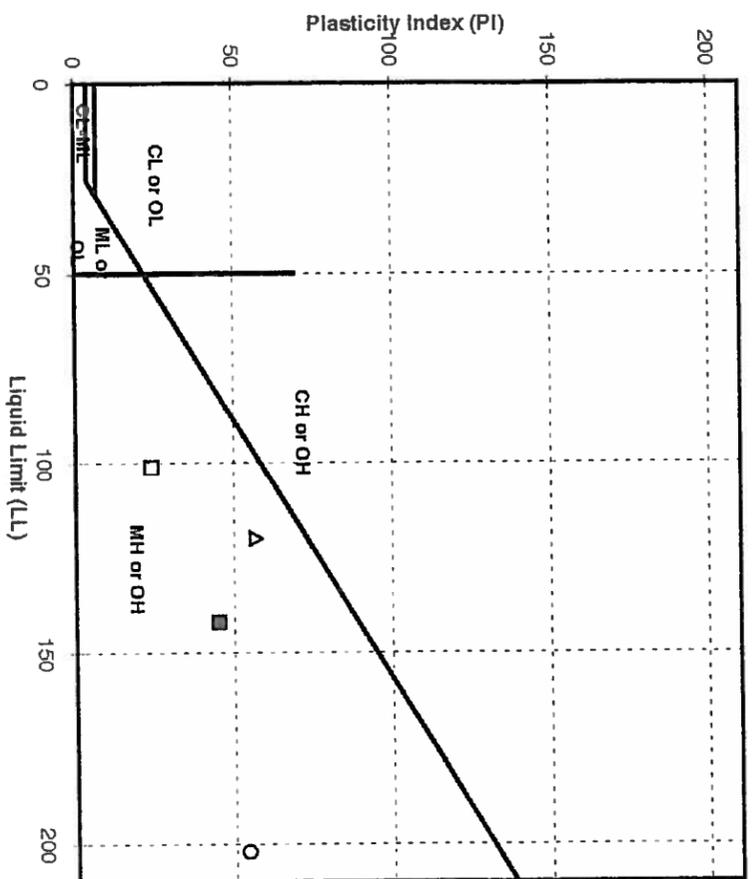

Sample Location	Plastic Limit	Liquid Limit	Plasticity Index	Natural Moisture Content	USCS
□ AWTP @ 5.0 ft	77	101	24	102.0%	MH
△ AWTP @ 6.5 ft	63	120	57	124.1%	MH
○ OAWT @ 4.0 ft	148	202	54	220.5%	MH
■ AIMP @ 3.5 ft	97	142	45	140.0%	MH

Duane Miller & Associates
 Job No. 4086.055
 March 2006

PLASTICITY CHART
 Atka Water Project
 Atka, Alaska

Plate
 8

1 GEOTECHNICAL TEST HOLES

NOTE FOR TEST HOLE LOCATIONS SEE SHEET G1.7

TP4 LOG HOLE BY DUANE MILLER - JUNE 2008 SEE SHEET G1.8

AMP-1 LOG HOLE BY DUANE MILLER - SEPT 2005 - THIS SHEET



Sheet No. G1.13	Project No. Date <u>MAY 2010</u> Designed <u>LAP</u> Drawn <u>DDR</u> Approved <u>LAP</u>	REVISION BY DATE	 PO BOX 22294 ANCHORAGE, AK 99523 PH: 907-348-1010 FAX: 907-348-1015	2009 WATER SYSTEM UPGRADES GEOTECHNICAL INFORMATION ATKA, ALASKA	 RECORD DRAWING 1-22-2013	CONSTRUCTION RECORD FIELD BOOK STAKING FOREMAN AS-BUILT INSPECTOR	SCALE: BAR IS ONE INCH ON ORIGINAL DRAWING IF NOT ONE INCH ON THIS SHEET ADJUST SCALES ACCORDINGLY	RECORD DRAWING CERTIFICATE THESE DRAWINGS REFLECT RECORDED INFORMATION OBTAINED DURING CONSTRUCTION. INFORMATION PROVIDED HEREIN IS ACCURATE TO THE BEST OF MY KNOWLEDGE. NAME _____ DATE _____
---------------------------	---	------------------------	---	--	---------------------------------	--	--	---

SITE CONTROL

Atka Water Treatment Site

Legal Description of

The purpose of this legal description is to describe a parcel to be used for a water treatment plant located in Atka, within Government Lot 1, Section 15, Township 92 South, Range 176 West, Seward Meridian, and more particularly described as follows:

Commencing at Corner 1, Lot 42, Atka ANCSA 14(c) Survey (recorded as Plat No. 2005-8, Aleutian Islands Recording District), a 3/4" brass cap monument thence N81°56'14"E, 832.80 feet, to a point on the boundary of Lot 69, Atka ANCSA 14(c) Survey, and the True Point of Beginning; thence N32°45'40"E, 200.00 feet, to a point; thence S57°14'20"E, 240.00 feet, to a point; thence S32°45'40"W, 199.98 feet, to a point on the boundary of Lot 69; thence along the boundary of Lot 69, 130.19 feet along a curve to the left and having a radius of 5,045.38 feet and an angle of 1°28'43" to a point of tangency; thence continuing along the boundary of Lot 69, N57°38'43"W, 109.82 feet, to the True Point of Beginning, containing 47,868 square feet (1.10 acres), more or less, as shown on Exhibit "A", attached to and a part hereof.

Michael E. Miller
Registered Land Surveyor
LS 7222

Date

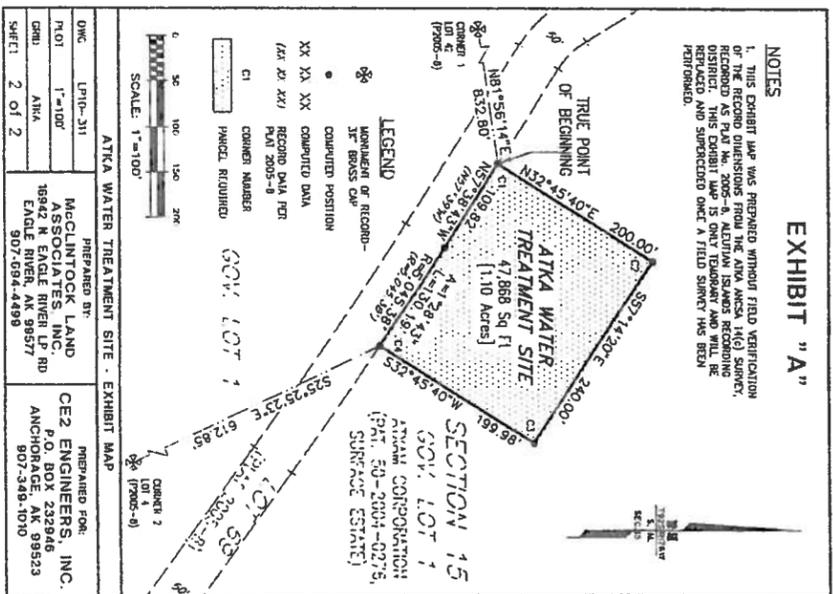


Exhibit "A" - Atka Water Treatment Site

Page 1 of 1

EXHIBIT "A"

NOTES
1. THIS EXHIBIT MAP WAS PREPARED WITHOUT FIELD VERIFICATION OF THE RECORD DIMENSIONS FROM THE ATKA ANCSA 14(C) SURVEY, DISTRICT OF RECORD. THIS EXHIBIT MAP IS ONLY TENDENTARY AND WILL BE REPLACED AND SUPERSEDED ONCE A FIELD SURVEY HAS BEEN PERFORMED.



UNCL	UNCL-311	PREPARED BY:	CE2 ENGINEERS, INC.
LOT	1"-100'	PREPARED FOR:	CE2 ENGINEERS, INC.
GRID	ATKA		
SHEET	2 of 2		

RECORD DRAWING
1-22-2013



REVISION	BY	DATE

CE2
ENGINEERS, INC.
PO BOX 232940 ANCHORAGE, AK 99523 PH: 907-349-1010 FAX: 907-349-1015




2009 WATER SYSTEM UPGRADES
SITE CONTROL
ATKA, ALASKA

CONSTRUCTION RECORD
FIELD BOOK
STAKING
FOREMAN
AS-BUILT
INSPECTOR

SCALE:	RECORD DRAWING CERTIFICATE
BAR IS ONE INCH ON ORIGINAL DRAWING	THESE DRAWINGS REFLECT RECORDED INFORMATION OBTAINED DURING CONSTRUCTION. INFORMATION PROVIDED HEREIN IS ACCURATE TO THE BEST OF MY KNOWLEDGE.
IF NOT ONE INCH ON THIS SHEET ADJUST SCALES ACCORDINGLY	NAME _____ DATE _____


Sheet No
G2.0

Project No.
Date MAY 2010
Designed LAP
Drawn LAW
Approved LAP

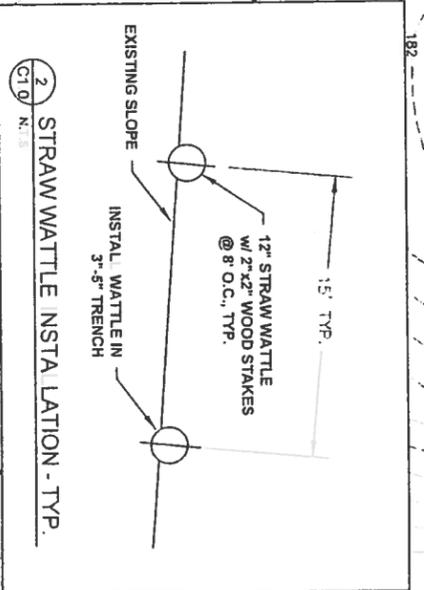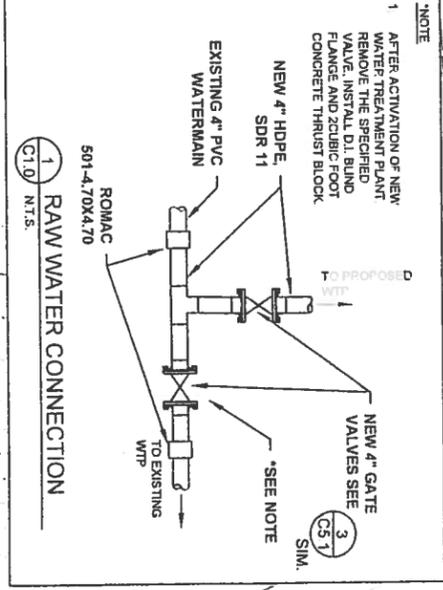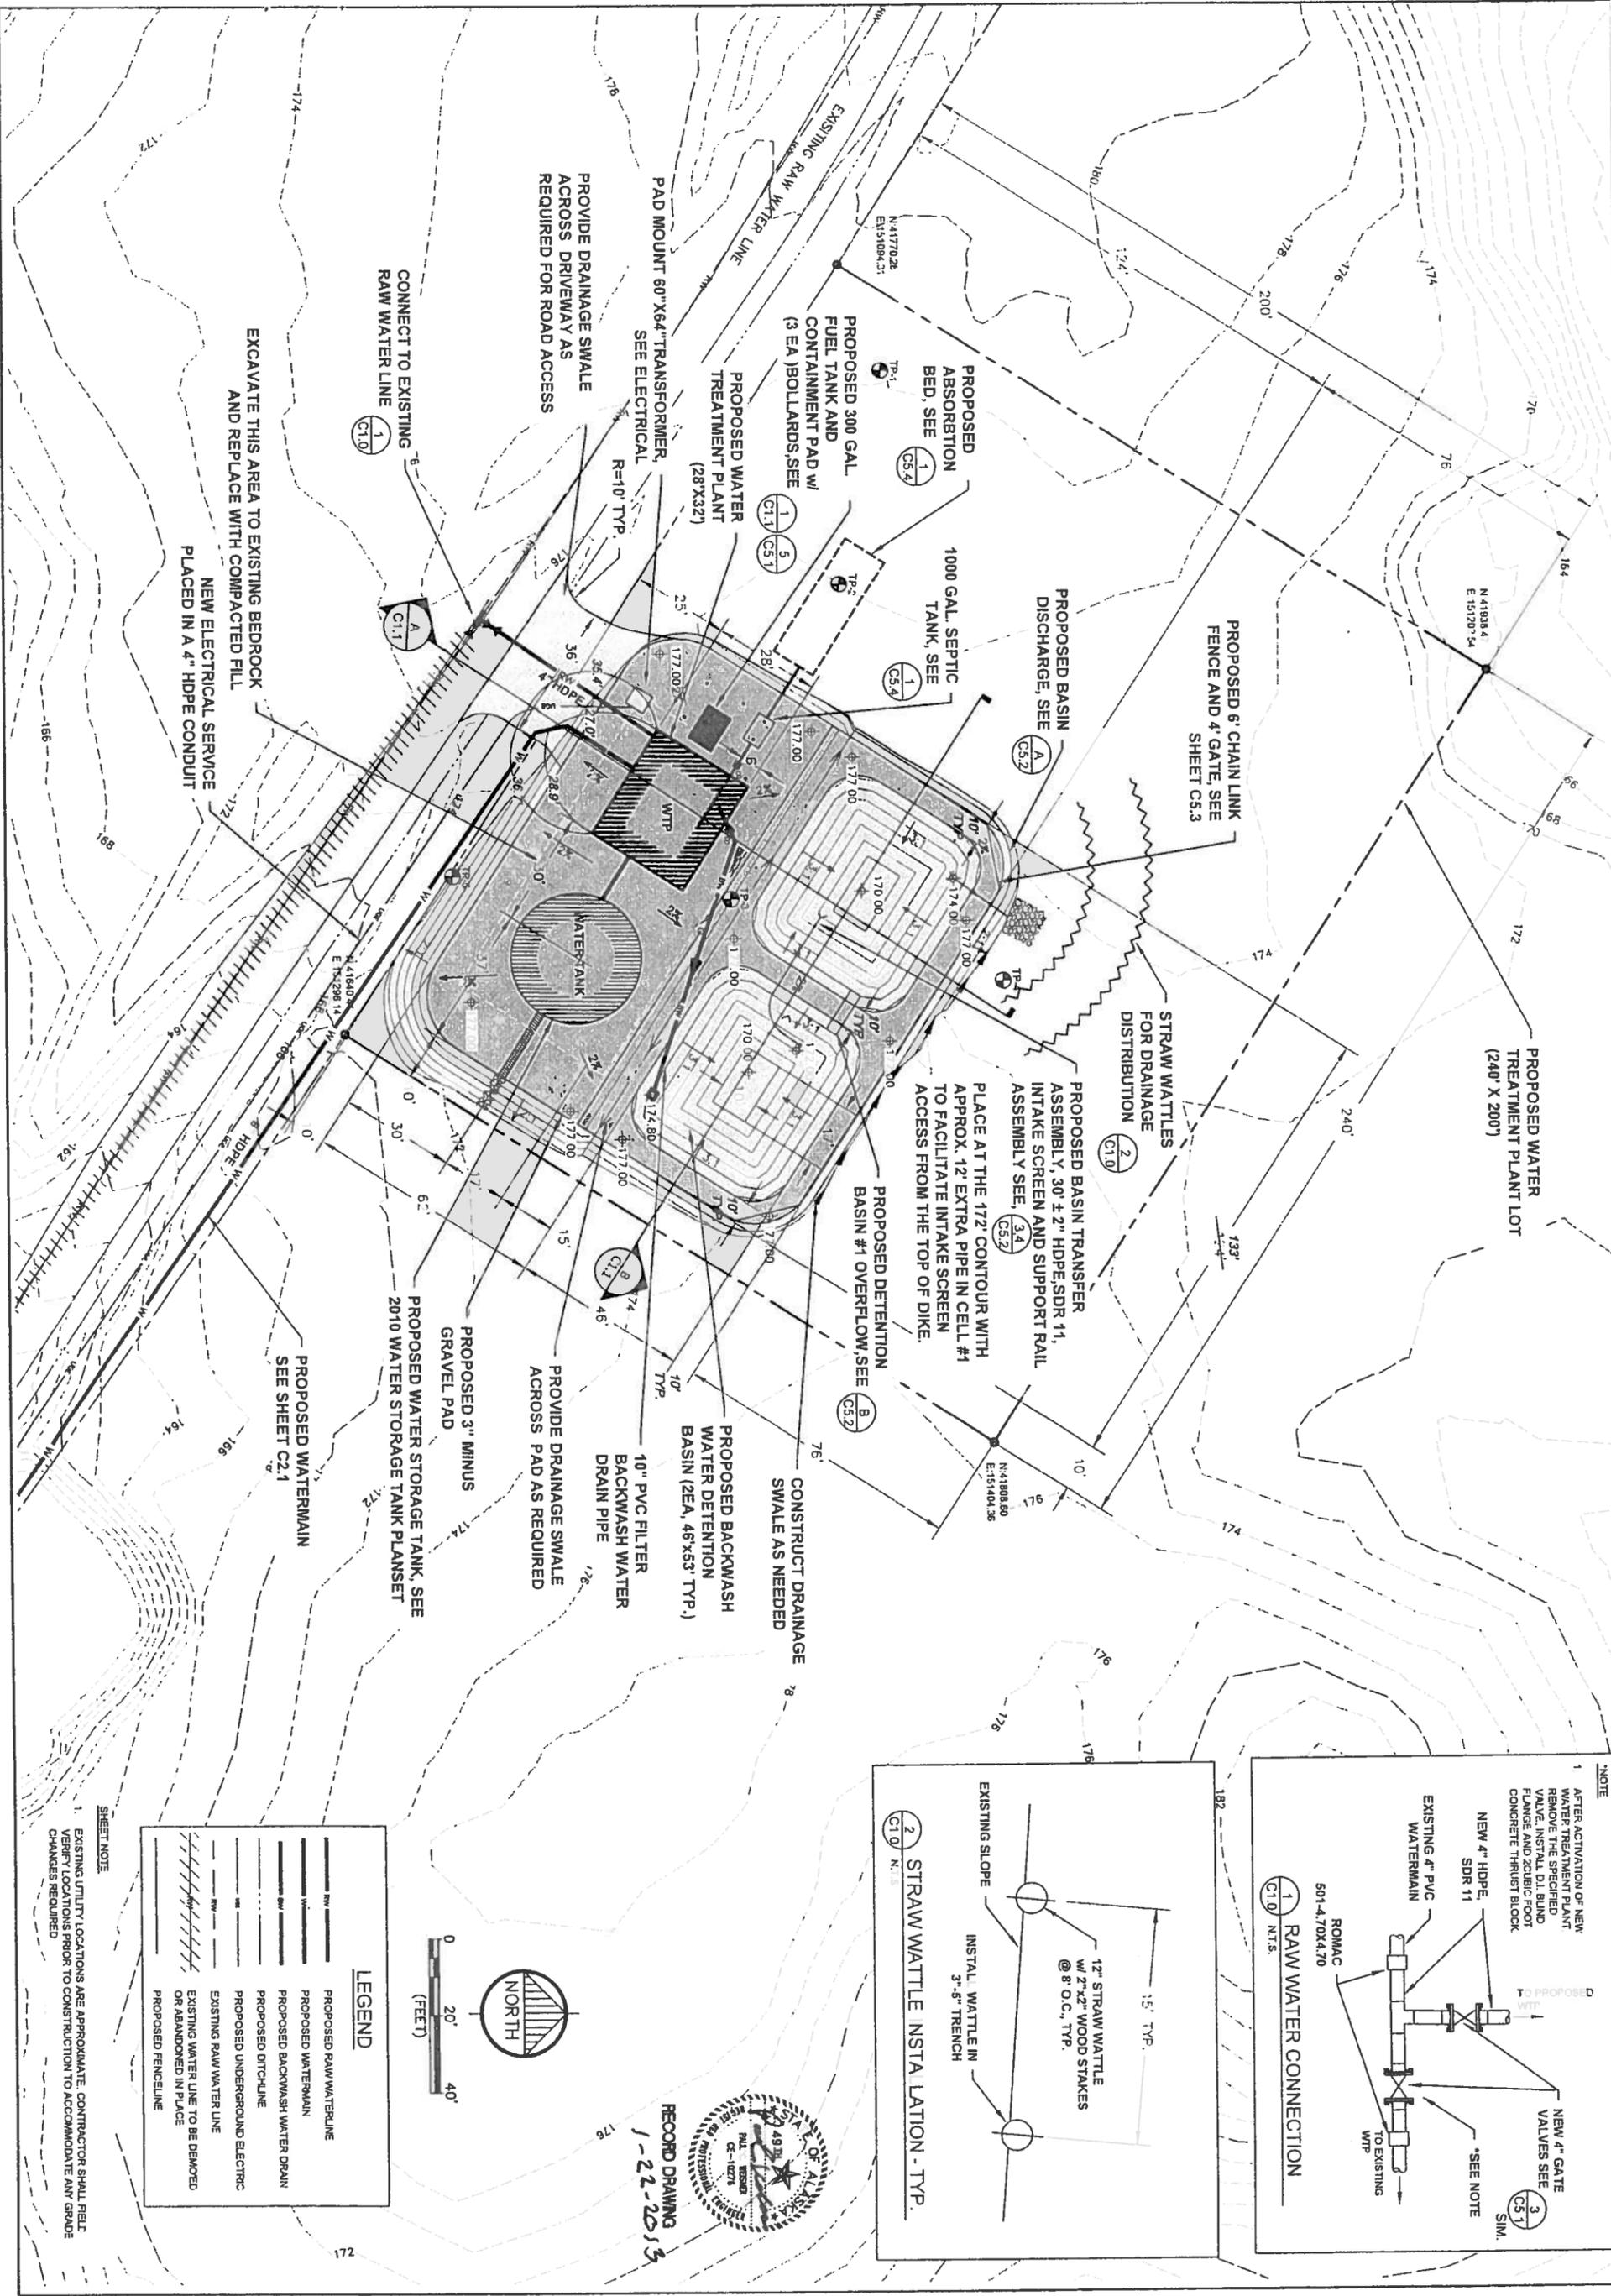

LEGEND

- PROPOSED RAW WATERLINE
- PROPOSED WATERMAIN
- PROPOSED BACKWASH WATER DRAIN
- PROPOSED DITCHLINE
- PROPOSED UNDERGROUND ELECTRIC
- EXISTING RAW WATER LINE
- EXISTING WATER LINE TO BE DEMOLISHED OR ABANDONED IN PLACE
- PROPOSED FENCELINE


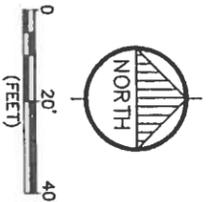


RECORD DRAWING
1-22-2013


SHEET NOTE

1. EXISTING UTILITY LOCATIONS ARE APPROXIMATE. CONTRACTOR SHALL FIELD VERIFY LOCATIONS PRIOR TO CONSTRUCTION TO ACCOMMODATE ANY GRADE CHANGES REQUIRED.


Project No. C1.0	Revision	BY	DATE	<p>PO BOX 222946 ANCHORAGE, AK 99523 PH: 907-348-1010 FAX: 907-348-1015</p>	2009 WATER SYSTEM UPGRADES SITE PLAN WATER TREATMENT SITE ATKA, ALASKA		CONSTRUCTION RECORD FIELD BOOK	SCALE: 1" = 10'-0"	RECORD DRAWING CERTIFICATE THESE DRAWINGS REFLECT RECORDED INFORMATION OBTAINED DURING CONSTRUCTION INFORMATION PROVIDED HEREIN IS ACCURATE TO THE BEST OF MY KNOWLEDGE. NAME _____ DATE _____
	Date MAY 2010	Added Sewerage Holding Tank	PW				1/2/11		
Designed LAP	Relocate Basin Discharge	LW	6/20/11						
Drawn CM	Add Drainage Swale	MRE	8/11/11						
Approved LAP	Drain Pipe Invert								

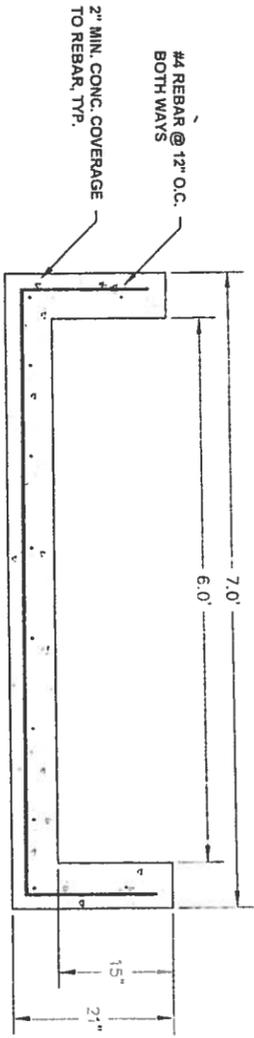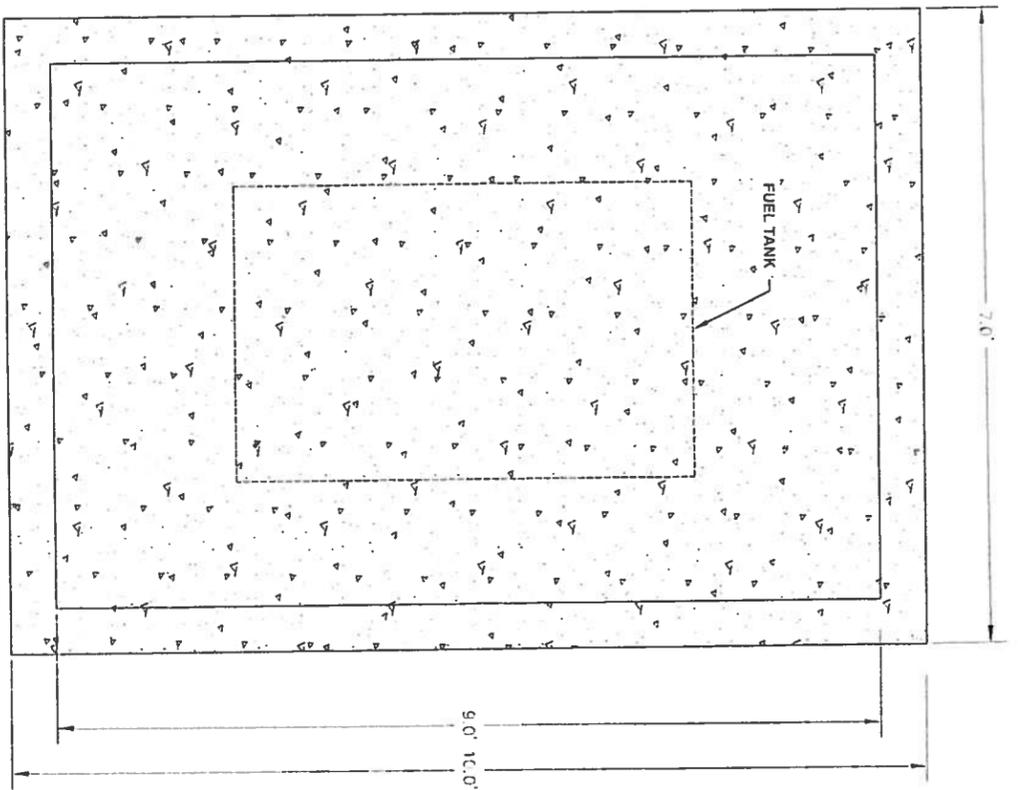

1
C1.1
N.T.S.
FUEL CONTAINMENT SLAB

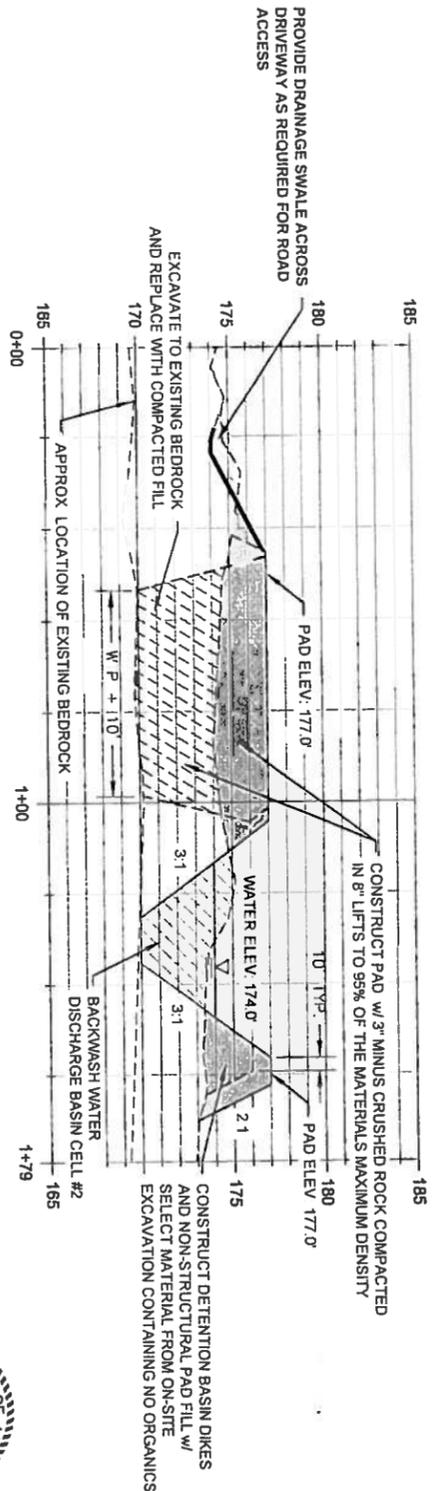

A
WTP SITE - SECTION "A"
Scale: 1"=20' HORIZ. 1"=5' VERT.

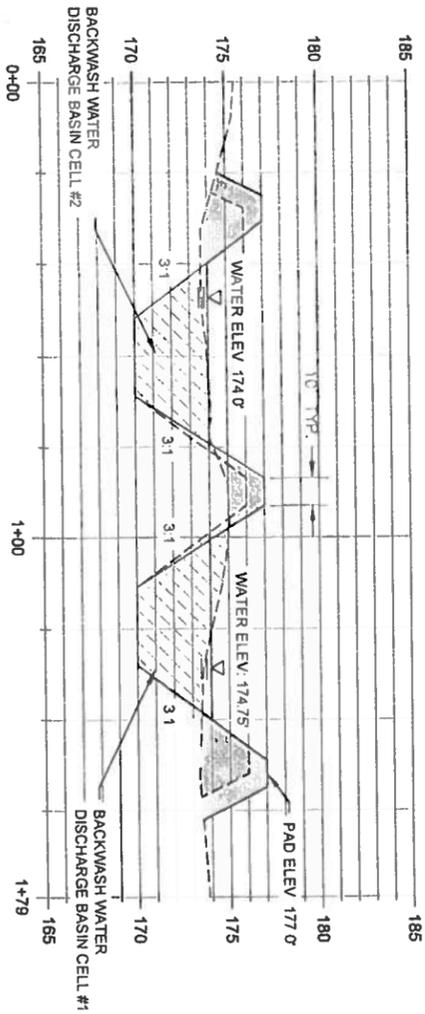


B
WTP SITE - SECTION "B"
Scale: 1"=20' HORIZ. 1"=5' VERT.

RECORD DRAWING
1-22-2013



Project No. Date: <u>MAY 2010</u> Designed: <u>LAP</u> Drawn: <u>CM</u> Approved: <u>LAP</u>	REVISION	BY	DATE	 PO BOX 222948 ANCHORAGE, AK 99522 PH: 907-349-1010 FAX: 907-349-1015	2009 WATER SYSTEM UPGRADES SECTIONS WATER TREATMENT SITE ATKA, ALASKA		CONSTRUCTION RECORD	SCALE	RECORD DRAWING CERTIFICATE
							FIELD BOOK	THESE DRAWINGS REFLECT RECORDED INFORMATION OBTAINED DURING CONSTRUCTION. INFORMATION PROVIDED HEREIN IS ACCURATE TO THE BEST OF MY KNOWLEDGE. NAME _____ DATE _____	

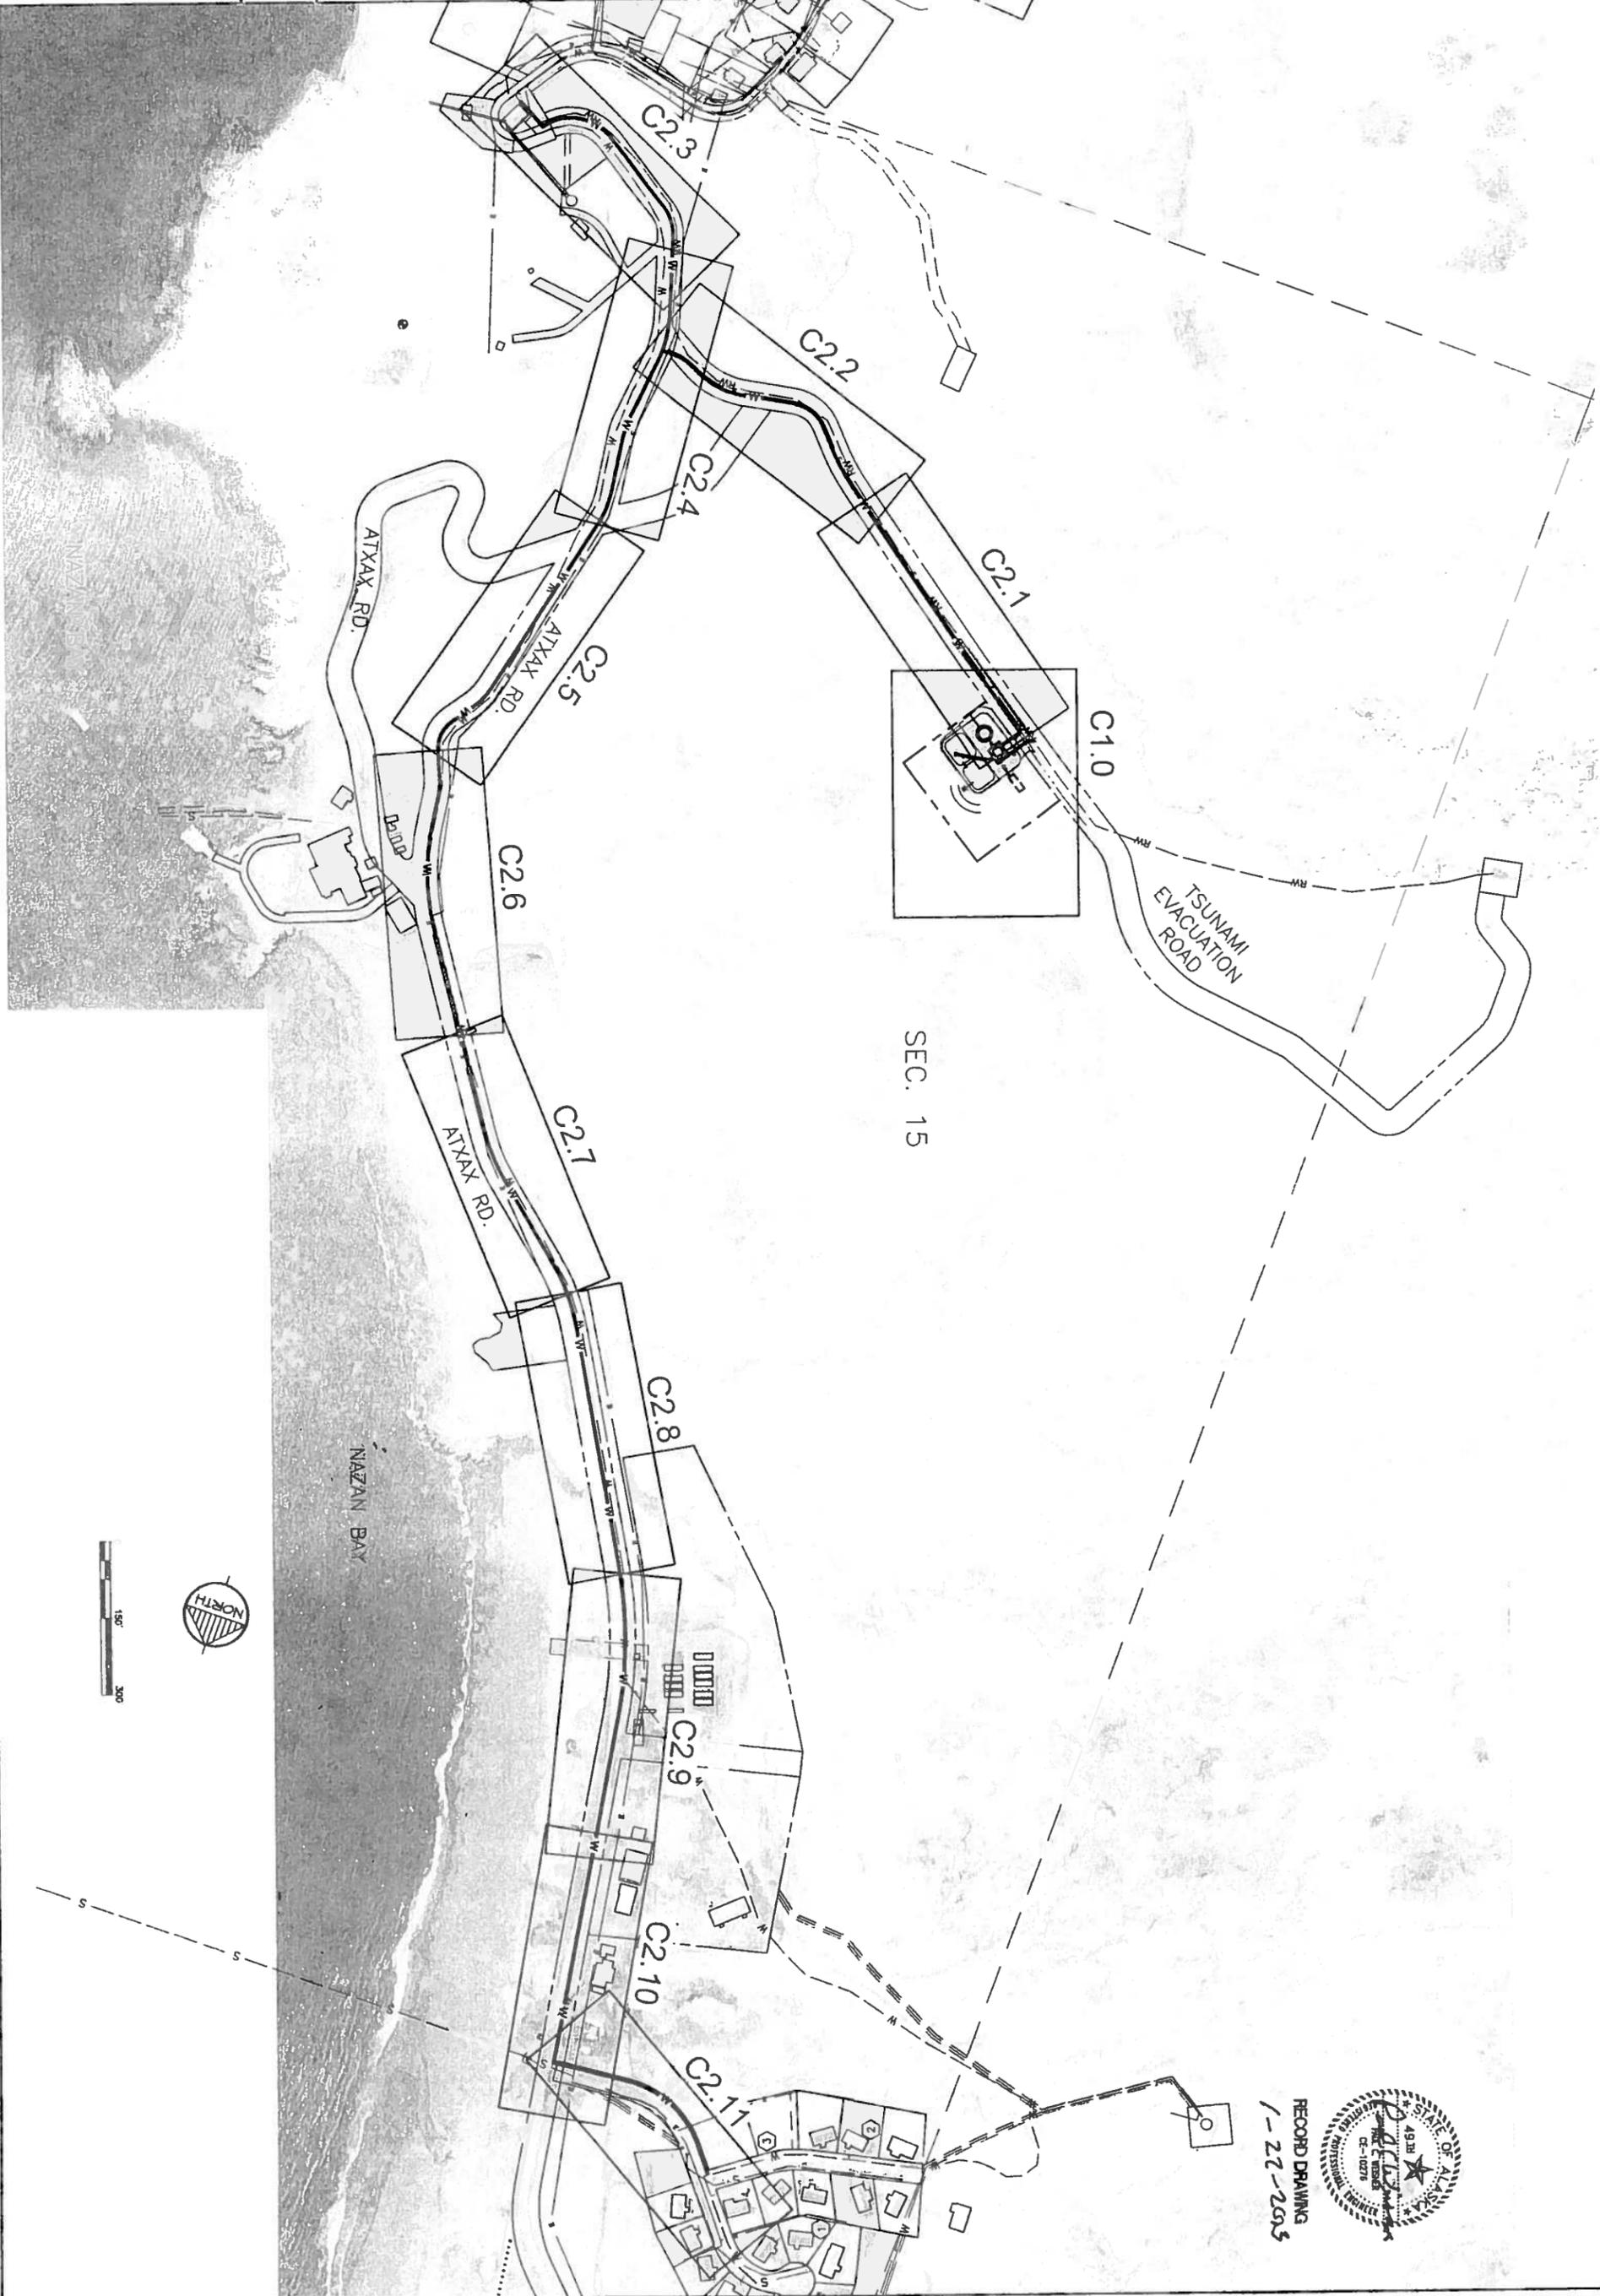

RECORDED DRAWING
1-22-2005



Sheet No. C2.0	Project No.
	Date MAY 2010
	Designed LAP
	Drawn CM
	Approved LAP

REVISION	BY	DATE

CE₂
ENGINEERS, INC.
PO BOX 222946 ANCHORAGE, AK 99523 PH: 807-343-1010 FAX: 807-343-1015


2009 WATER SYSTEM UPGRADES
WATERMAIN IMPROV INDEX SHEET
ATKA, ALASKA



CONSTRUCTION RECORD
FIELD BOOK
STAKING
FOREMAN
AS-BUILT
INSPECTOR

SCALE:
1" = 300'
IF NOT ONE INCH ON THIS SHEET, ADJUST SCALES ACCORDINGLY

RECORD DRAWING CERTIFICATE	
THESE DRAWINGS REFLECT RECORDED INFORMATION OBTAINED DURING CONSTRUCTION INFORMATION PROVIDED HEREIN IS ACCURATE TO THE BEST OF MY KNOWLEDGE.	
NAME	DATE

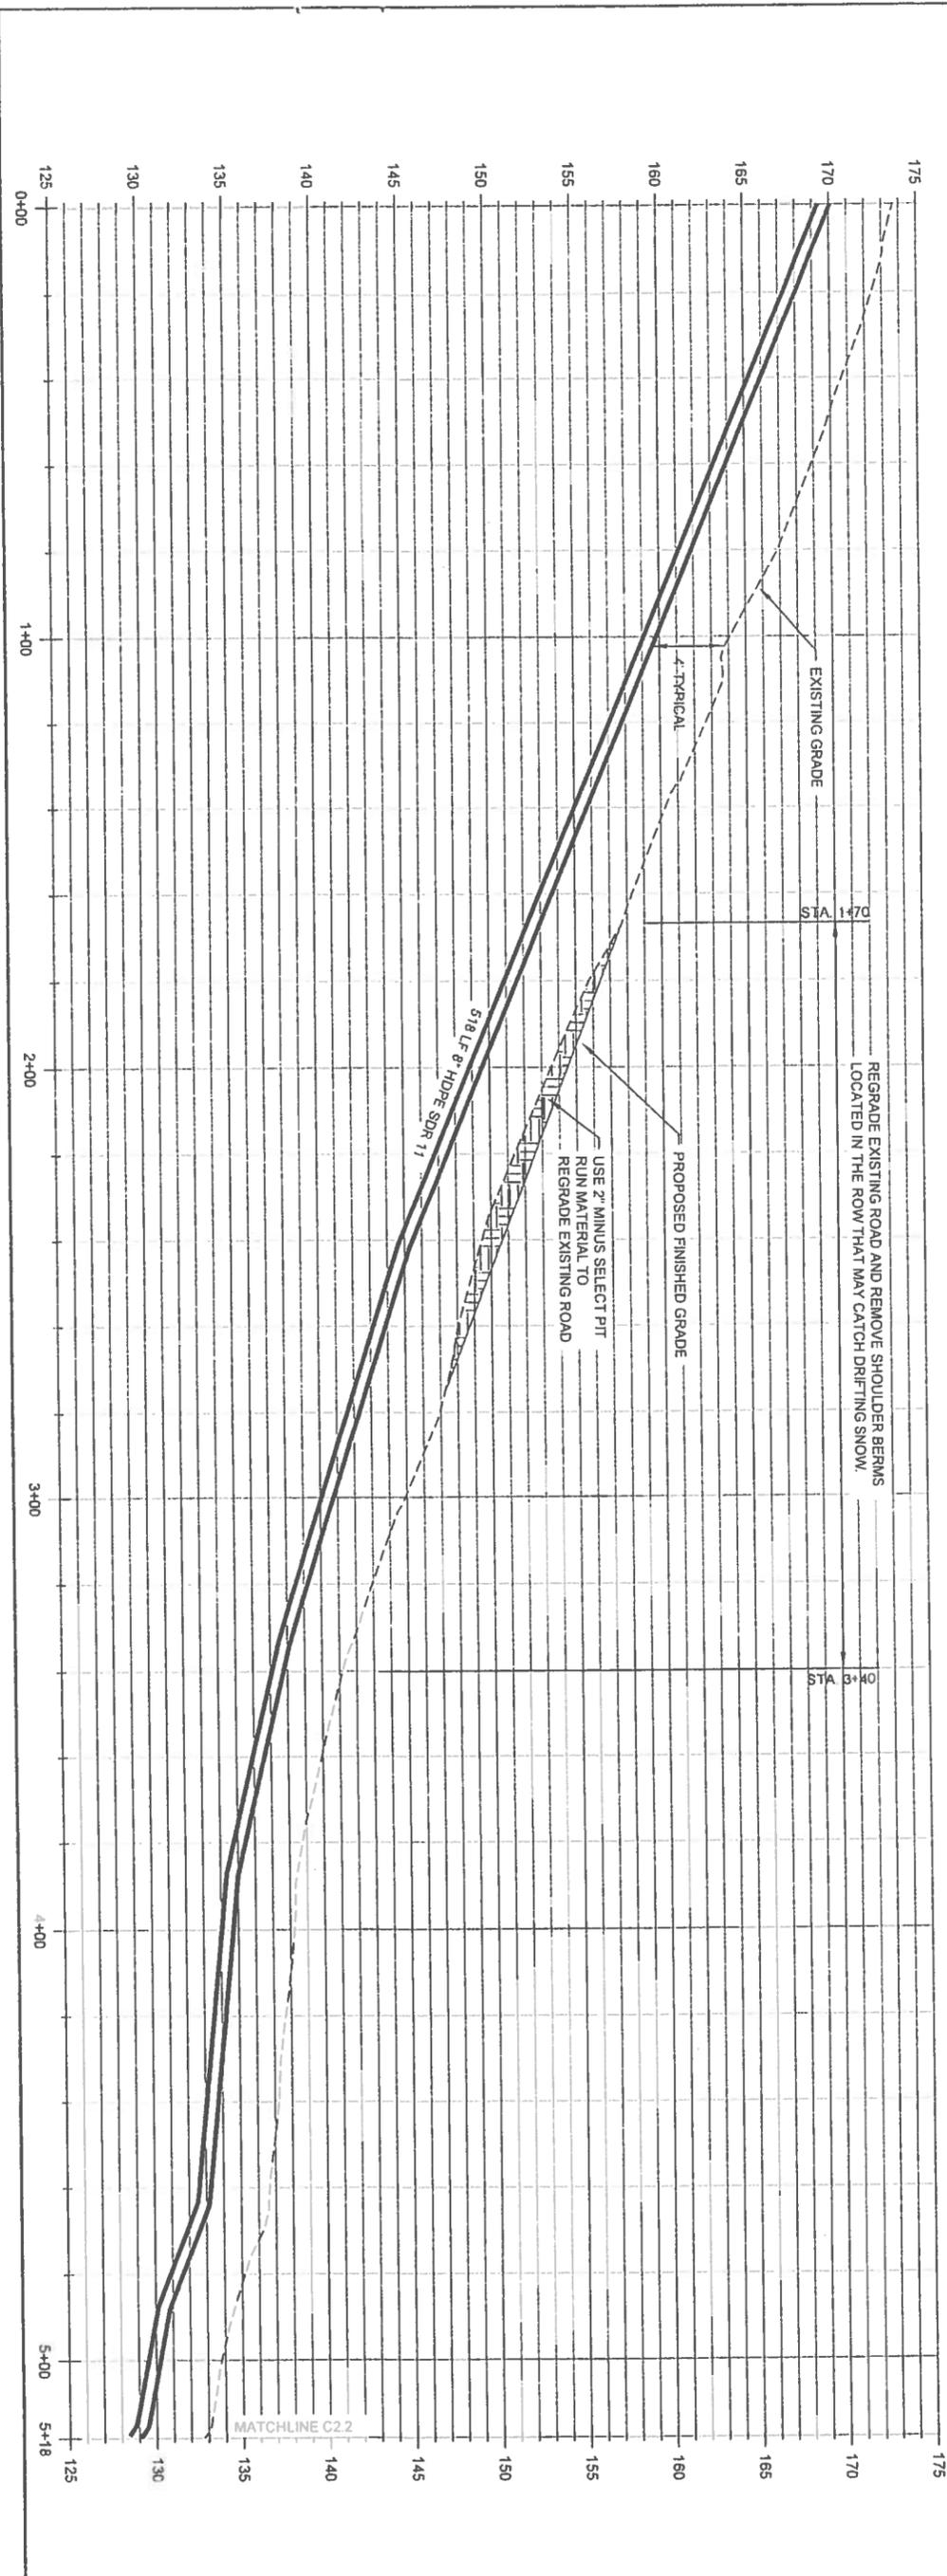

RECORD DRAWING
1-22-2013



Sheet No. C2.1	Project No.
	Date MAY 2010
	Designed LAP
	Drawn CM
	Approved LAP

REVISION	BY	DATE

CE₂
ENGINEERS, INC.
PO BOX 222948 ANCHORAGE, AK 99520 PH: 907-348-1010 FAX: 907-348-1015





2009 WATER SYSTEM UPGRADES
PLAN AND PROFILE
ATKA, ALASKA



CONSTRUCTION RECORD
FIELD BOOK
STAKING
FOREMAN
AS-BUILT
INSPECTOR

SCALE:
1" = 40'
1" = 20'
1" = 10'

RECORD DRAWING CERTIFICATE	
THESE DRAWINGS REFLECT RECORDED INFORMATION OBTAINED DURING CONSTRUCTION INFORMATION PROVIDED HEREIN IS ACCURATE TO THE BEST OF MY KNOWLEDGE.	
NAME	DATE

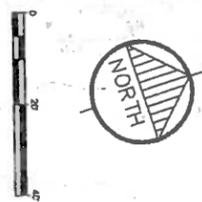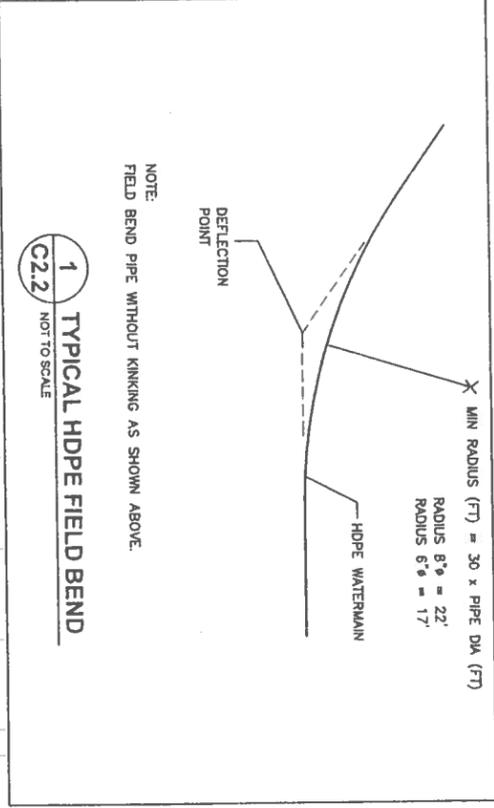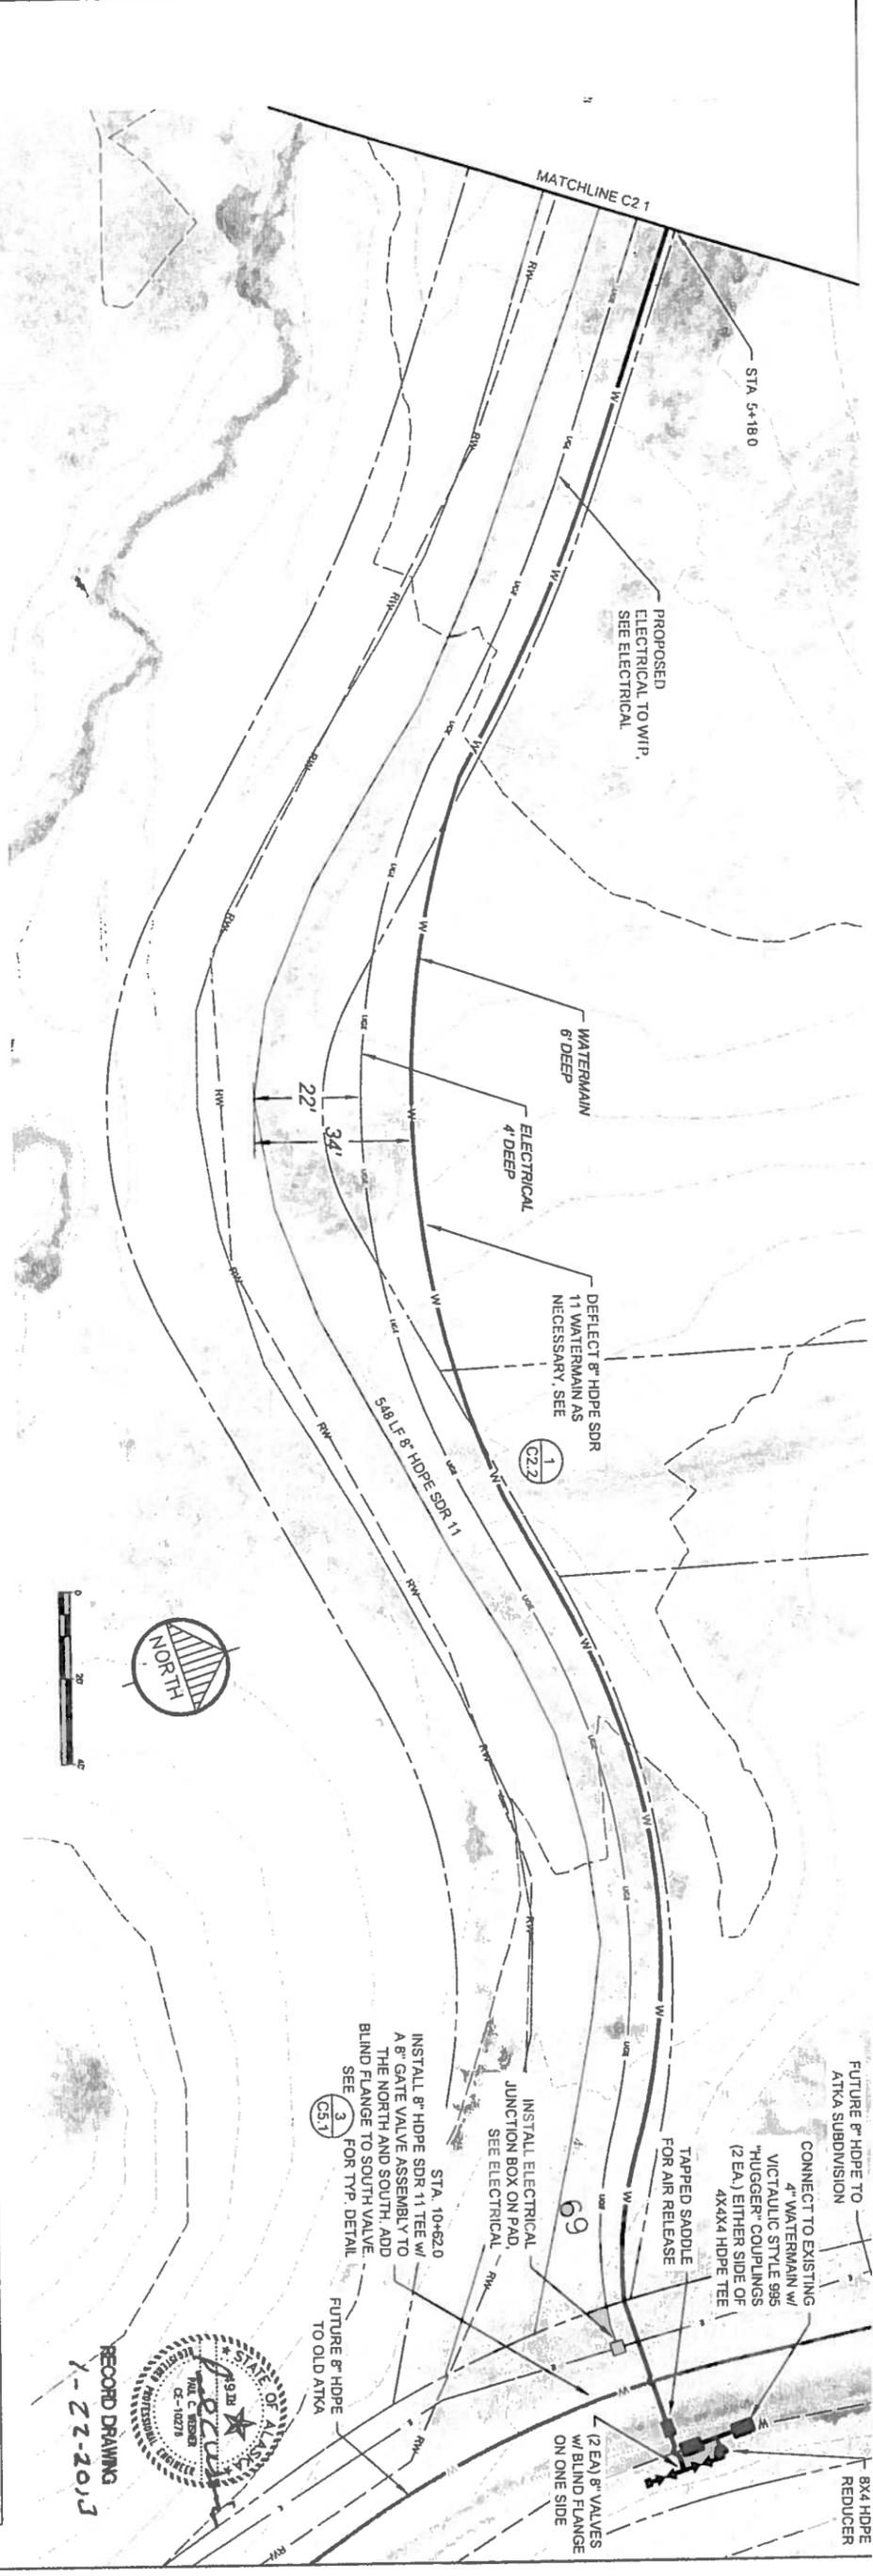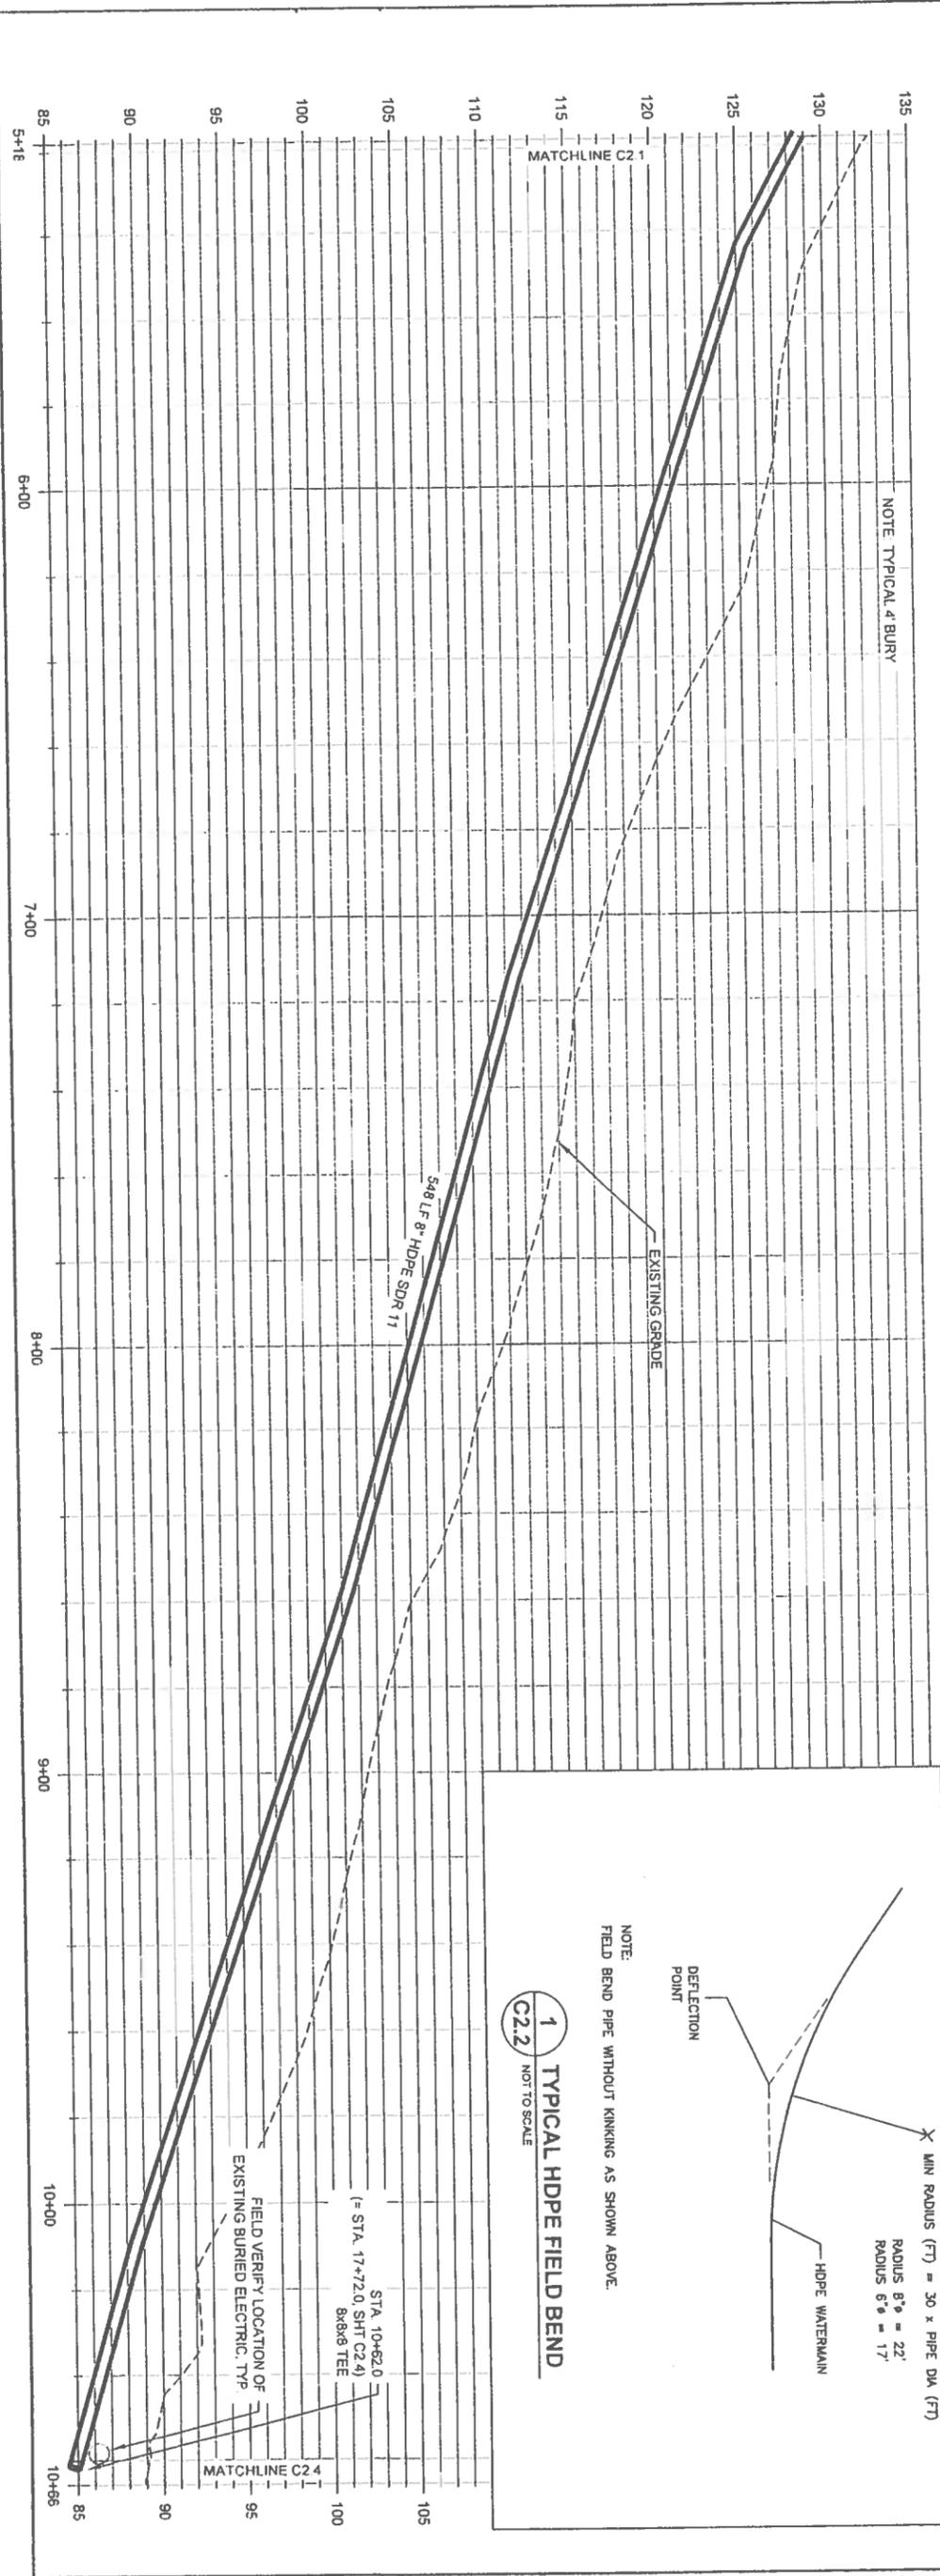

RECORD DRAWING
1-22-2013

Project No.	
Date	MAY 2010
Designed	LAP
Drawn	CM
Approved	LAP

REVISION	BY	DATE

CE₂
ENGINEERS, INC.
PO BOX 222946 ANCHORAGE, AK 99523 PH: 907-348-1010 FAX: 907-348-1015



2009 WATER SYSTEM UPGRADES
PLAN AND PROFILE
ATKA, ALASKA



CONSTRUCTION RECORD	FIELD BOOK
STARTING	
FOREMAN	
AS-BUILT	
INSPECTOR	

SCALE:
BAR IS ONE INCH ON ORIGINAL DRAWING
IF NOT ONE INCH IN THIS SHEET, SCALE IS ACCORDINGLY

RECORD DRAWING CERTIFICATE	
THESE DRAWINGS REFLECT RECORDED INFORMATION OBTAINED DURING CONSTRUCTION. INFORMATION PROVIDED HEREIN IS ACCURATE TO THE BEST OF MY KNOWLEDGE.	
NAME	DATE

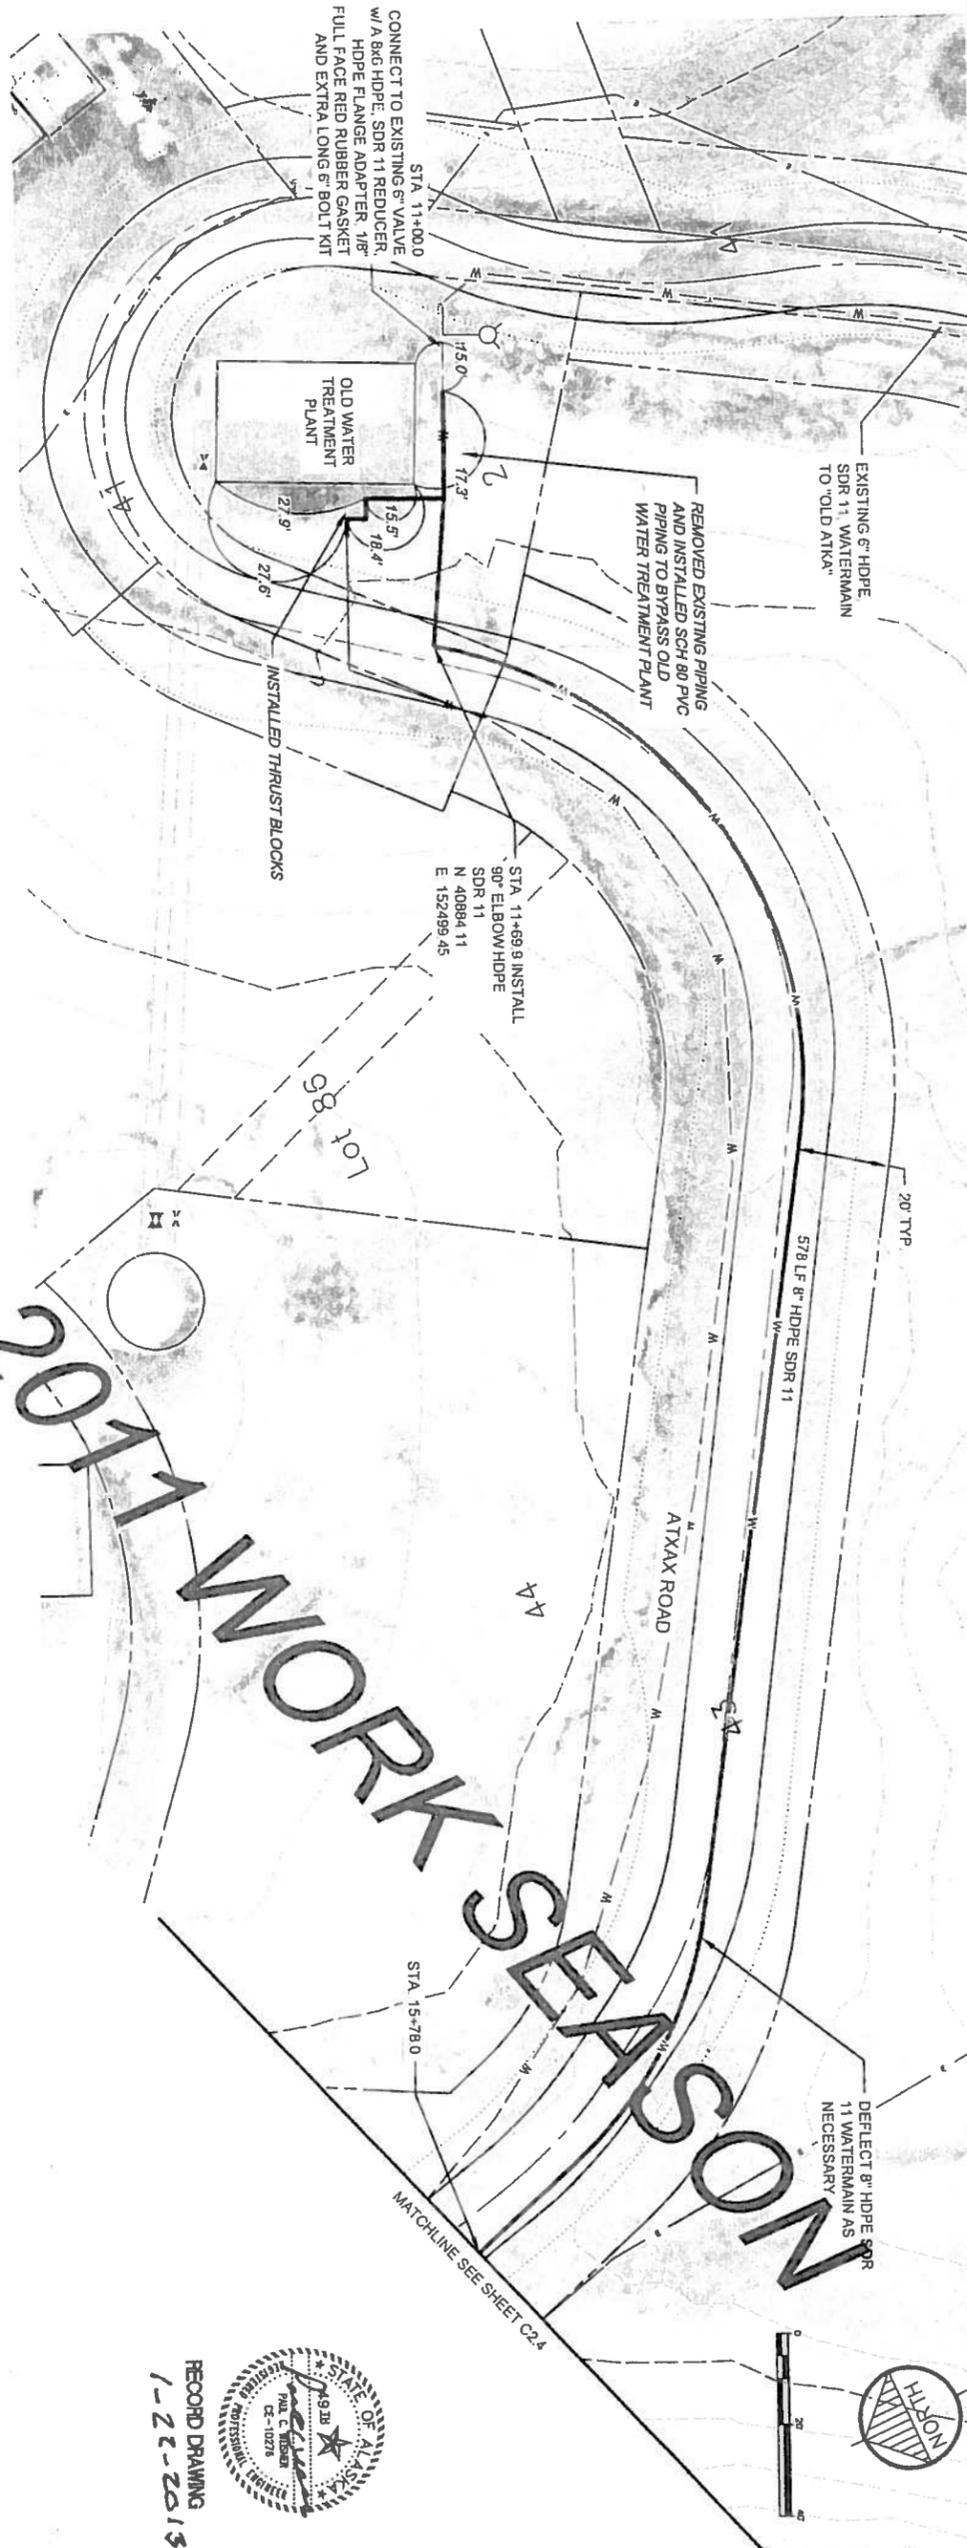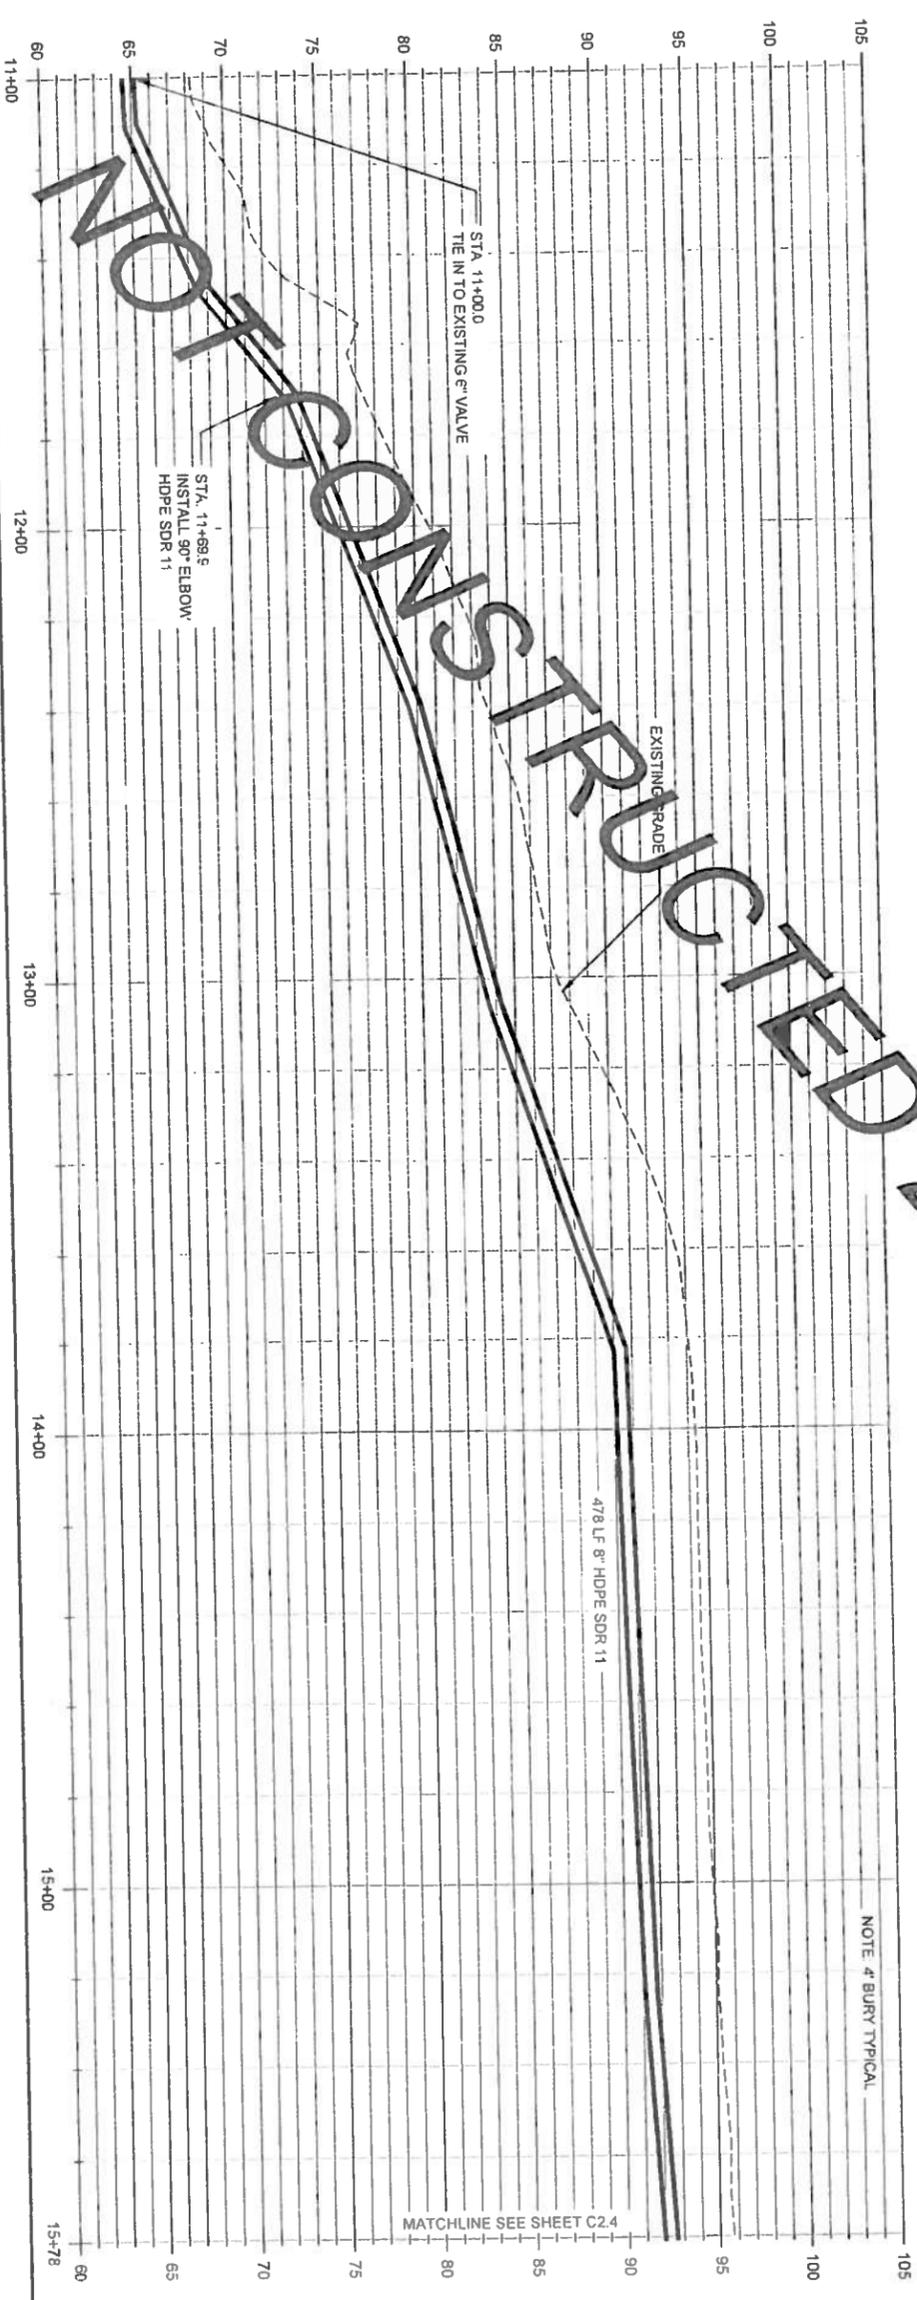

NOT FOR CONSTRUCTION

2011 WORK SEASON

RECORD DRAWING
1-22-2013



Sheet No. C2.3	Project No.	
	Date	MAY 2010
	Designed	LAP
	Drawn	CM
	Approved	LAP

CE₂

ENGINEERS, INC.

PO BOX 22946 ANCHORAGE, AK 99523 PH: 907-349-1910 FAX: 907-349-1915

2009 WATER SYSTEM UPGRADES

PLAN AND PROFILE

ATKA, ALASKA



CONSTRUCTION RECORD	FIELD BOOK
STAKING	
FOREMAN	
AS-BUILT	
INSPECTOR	

SCALE:


BAR IS ONE INCH ON ORIGINAL DRAWING

IF NOT ONE INCH ON THIS SHEET ADAPT SCALE ACCORDINGLY

RECORD DRAWING CERTIFICATE

THESE DRAWINGS REFLECT RECORDED INFORMATION OBTAINED DURING CONSTRUCTION. INFORMATION PROVIDED HEREIN IS ACCURATE TO THE BEST OF MY KNOWLEDGE.

NAME _____ DATE _____

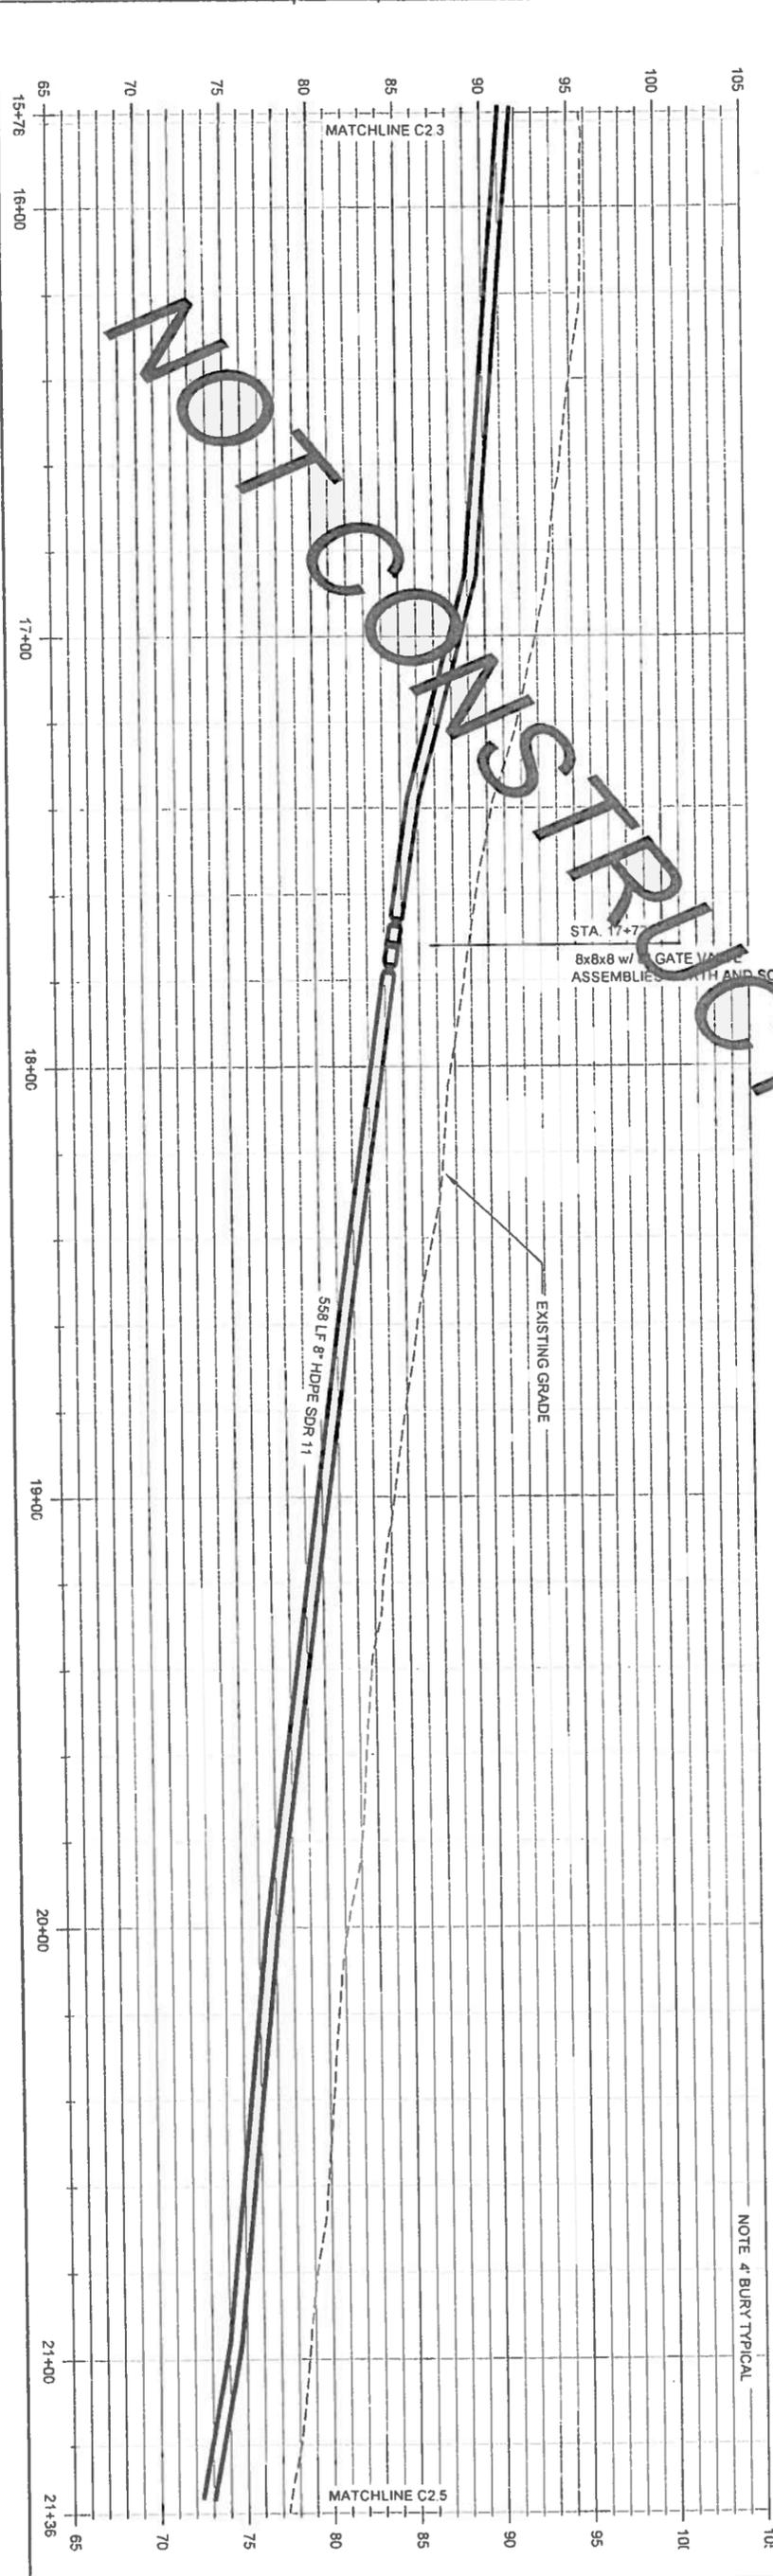

NOT FOR CONSTRUCTION

NOTE 4 BURY TYPICAL



Sheet No: C2.4	Project No. _____
	Date: <u>MAY 2010</u>
	Designed: <u>LAP</u>
	Drawn: <u>CM</u>
	Approved: <u>LAP</u>

REVISION	BY	DATE

CE₂

ENGINEERS, INC.

PO BOX 222946 ANCHORAGE, AK 99523 PH: 807-349-1010 FAX: 807-349-1015

2009 WATER SYSTEM UPGRADES

PLAN AND PROFILE


ATKA, ALASKA



CONSTRUCTION RECORD	
FIELD BOOK	
STAKING	
FOREMAN	
AS-BUILT	
INSPECTOR	

SCALE:
BAR IS ONE INCH ON ORIGINAL DRAWING
IF NOT THE "AS-BUILT" SCALE IS ACCORDANT

RECORD DRAWING CERTIFICATE	
THESE DRAWINGS REFLECT RECORDED INFORMATION OBTAINED DURING CONSTRUCTION INFORMATION PROVIDED HEREIN IS ACCURATE TO THE BEST OF MY KNOWLEDGE.	
NAME _____	DATE _____

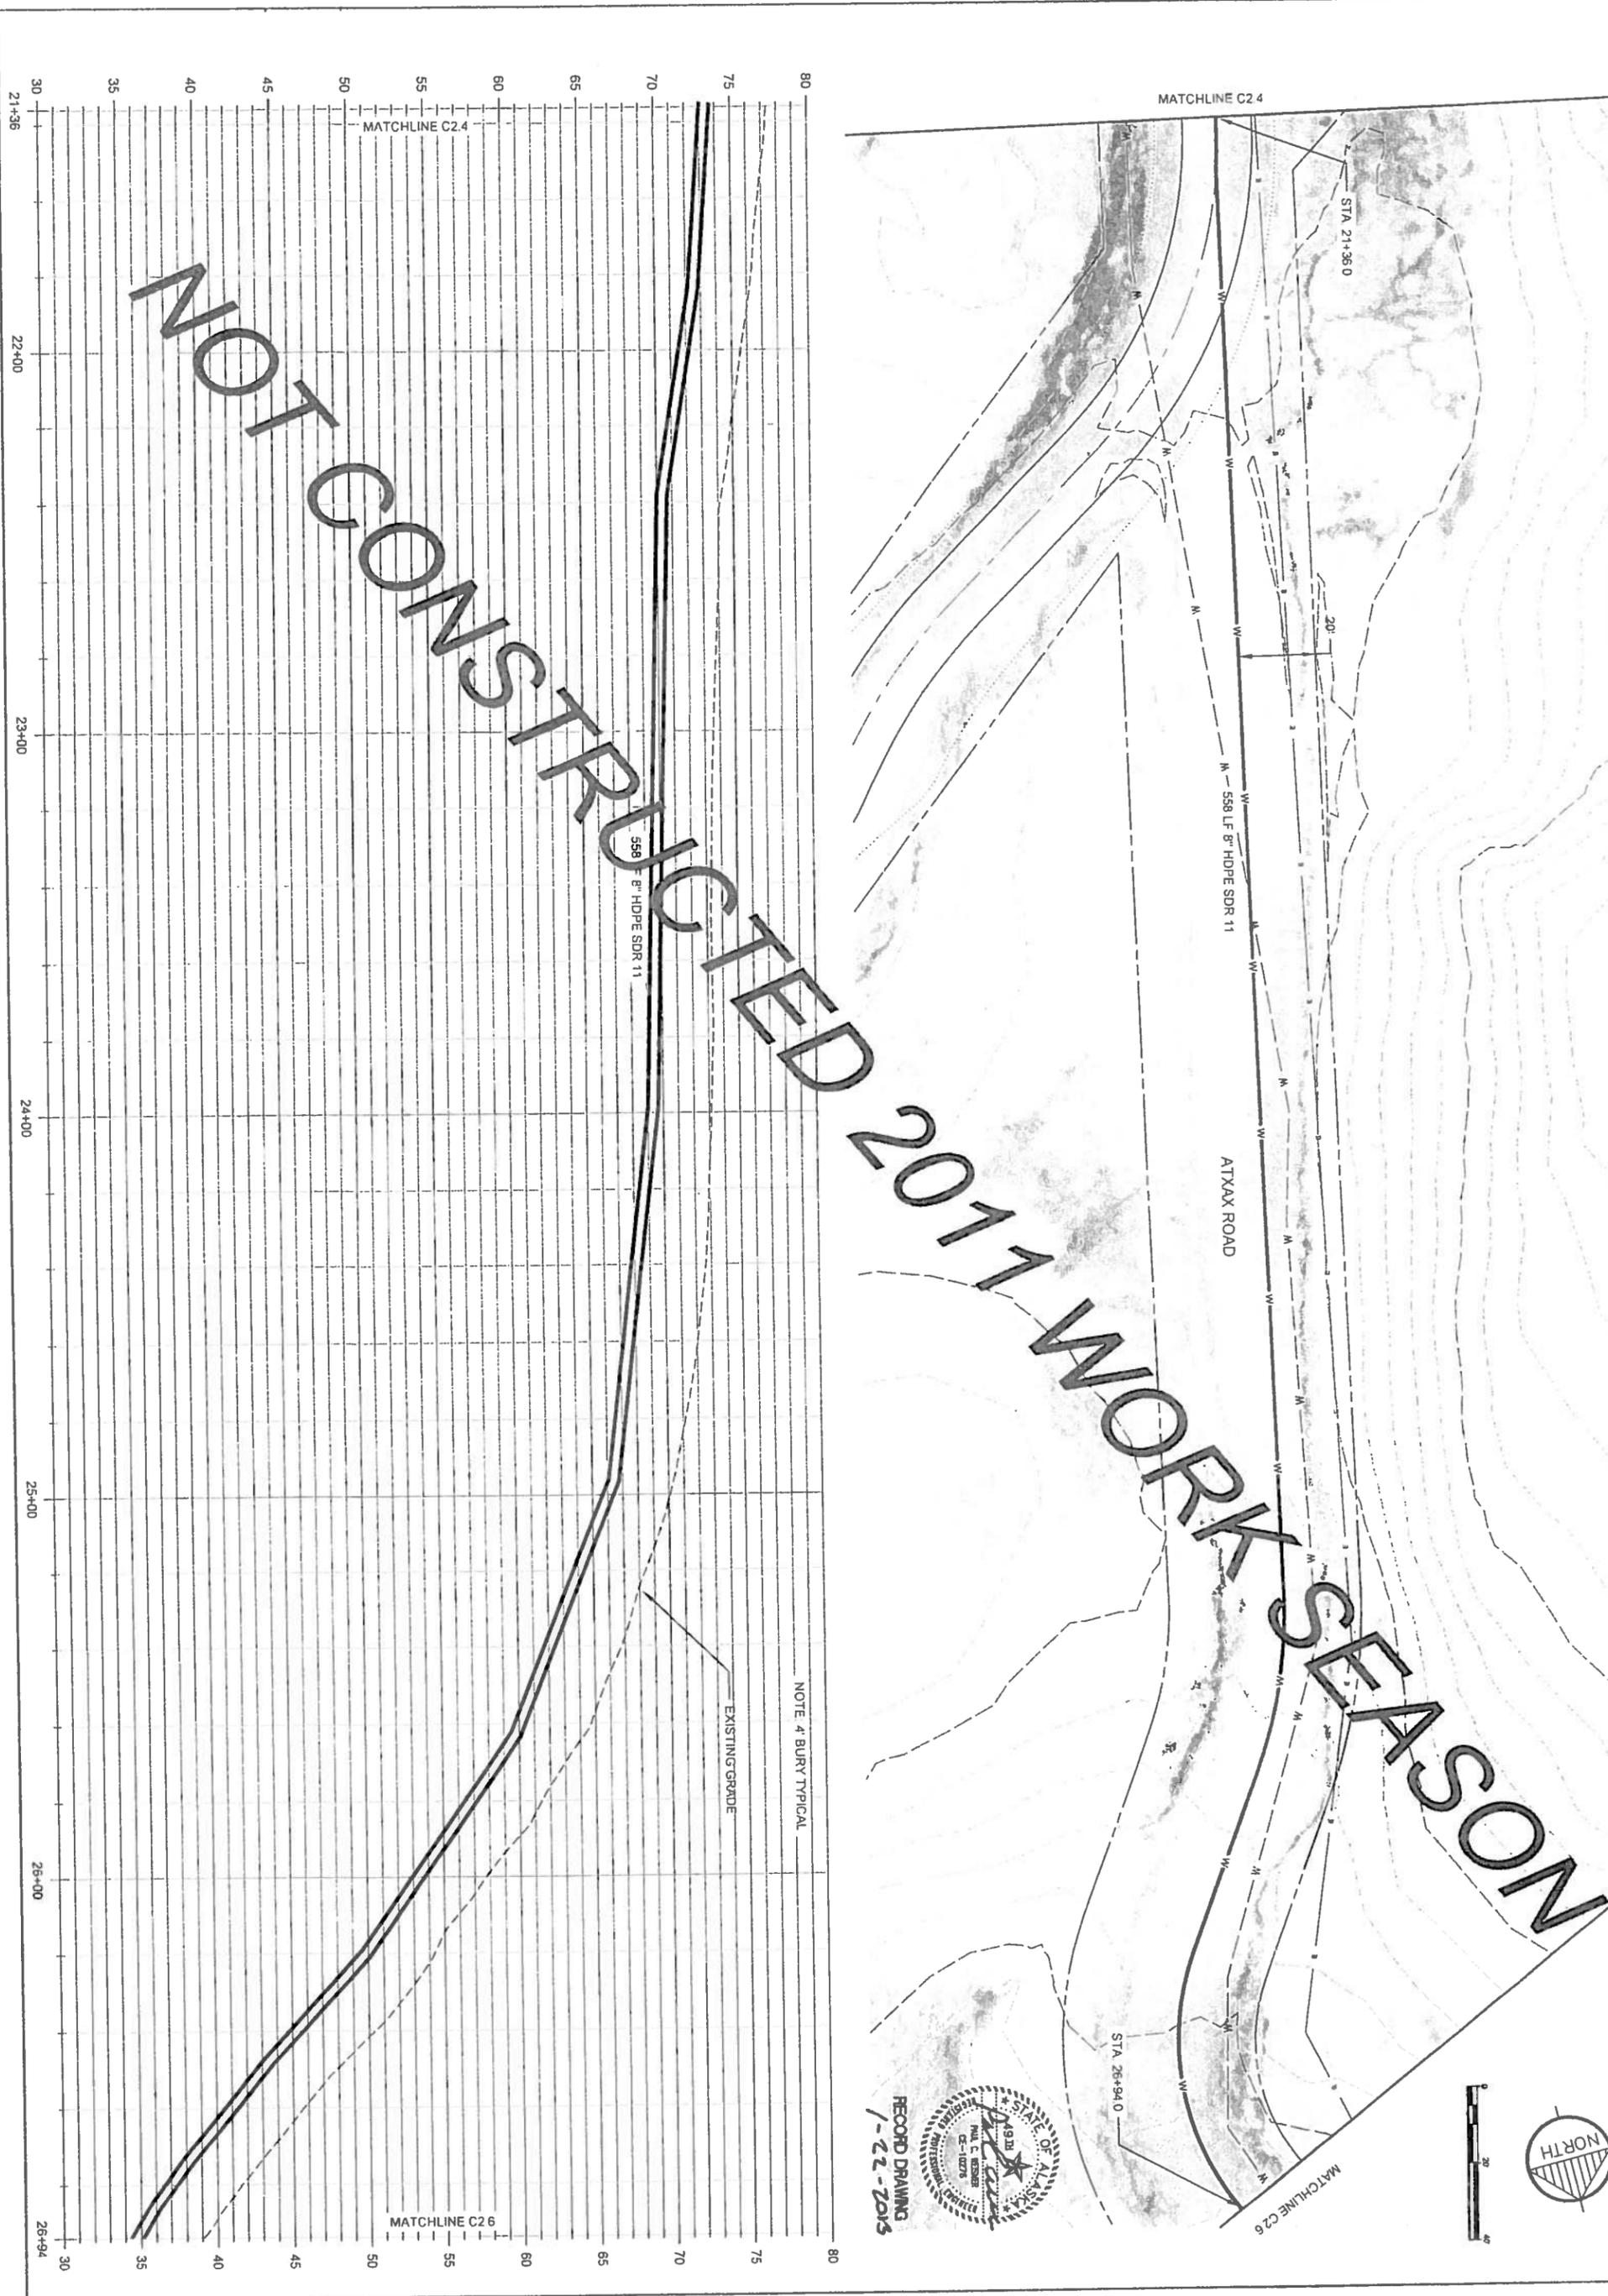

Sheet No. C2.5	Project No.
	Date MAY 2010
	Designed LAP
	Drawn CM
	Approved LAP

REVISION	BY	DATE

CE₂
ENGINEERS, INC.
 PO BOX 22296 ANCHORAGE, AK 99523 PH: 907-348-1010 FAX: 907-348-1015


2009 WATER SYSTEM UPGRADES
 PLAN AND PROFILE
 ATKA, ALASKA



CONSTRUCTION RECORD
FIELD BOOK
RTAKM
FOREMAN
AS-BUILT
INSPECTOR

SCALE:
 1" = 20'
 IF NOT ONE INCH ON THIS SHEET AGAIN SCALE IS ACCORDING

RECORD DRAWING CERTIFICATE	
THESE DRAWINGS REFLECT RECORDED INFORMATION OBTAINED DURING CONSTRUCTION INFORMATION PROVIDED HEREIN IS ACCURATE TO THE BEST OF MY KNOWLEDGE	
NAME	DATE

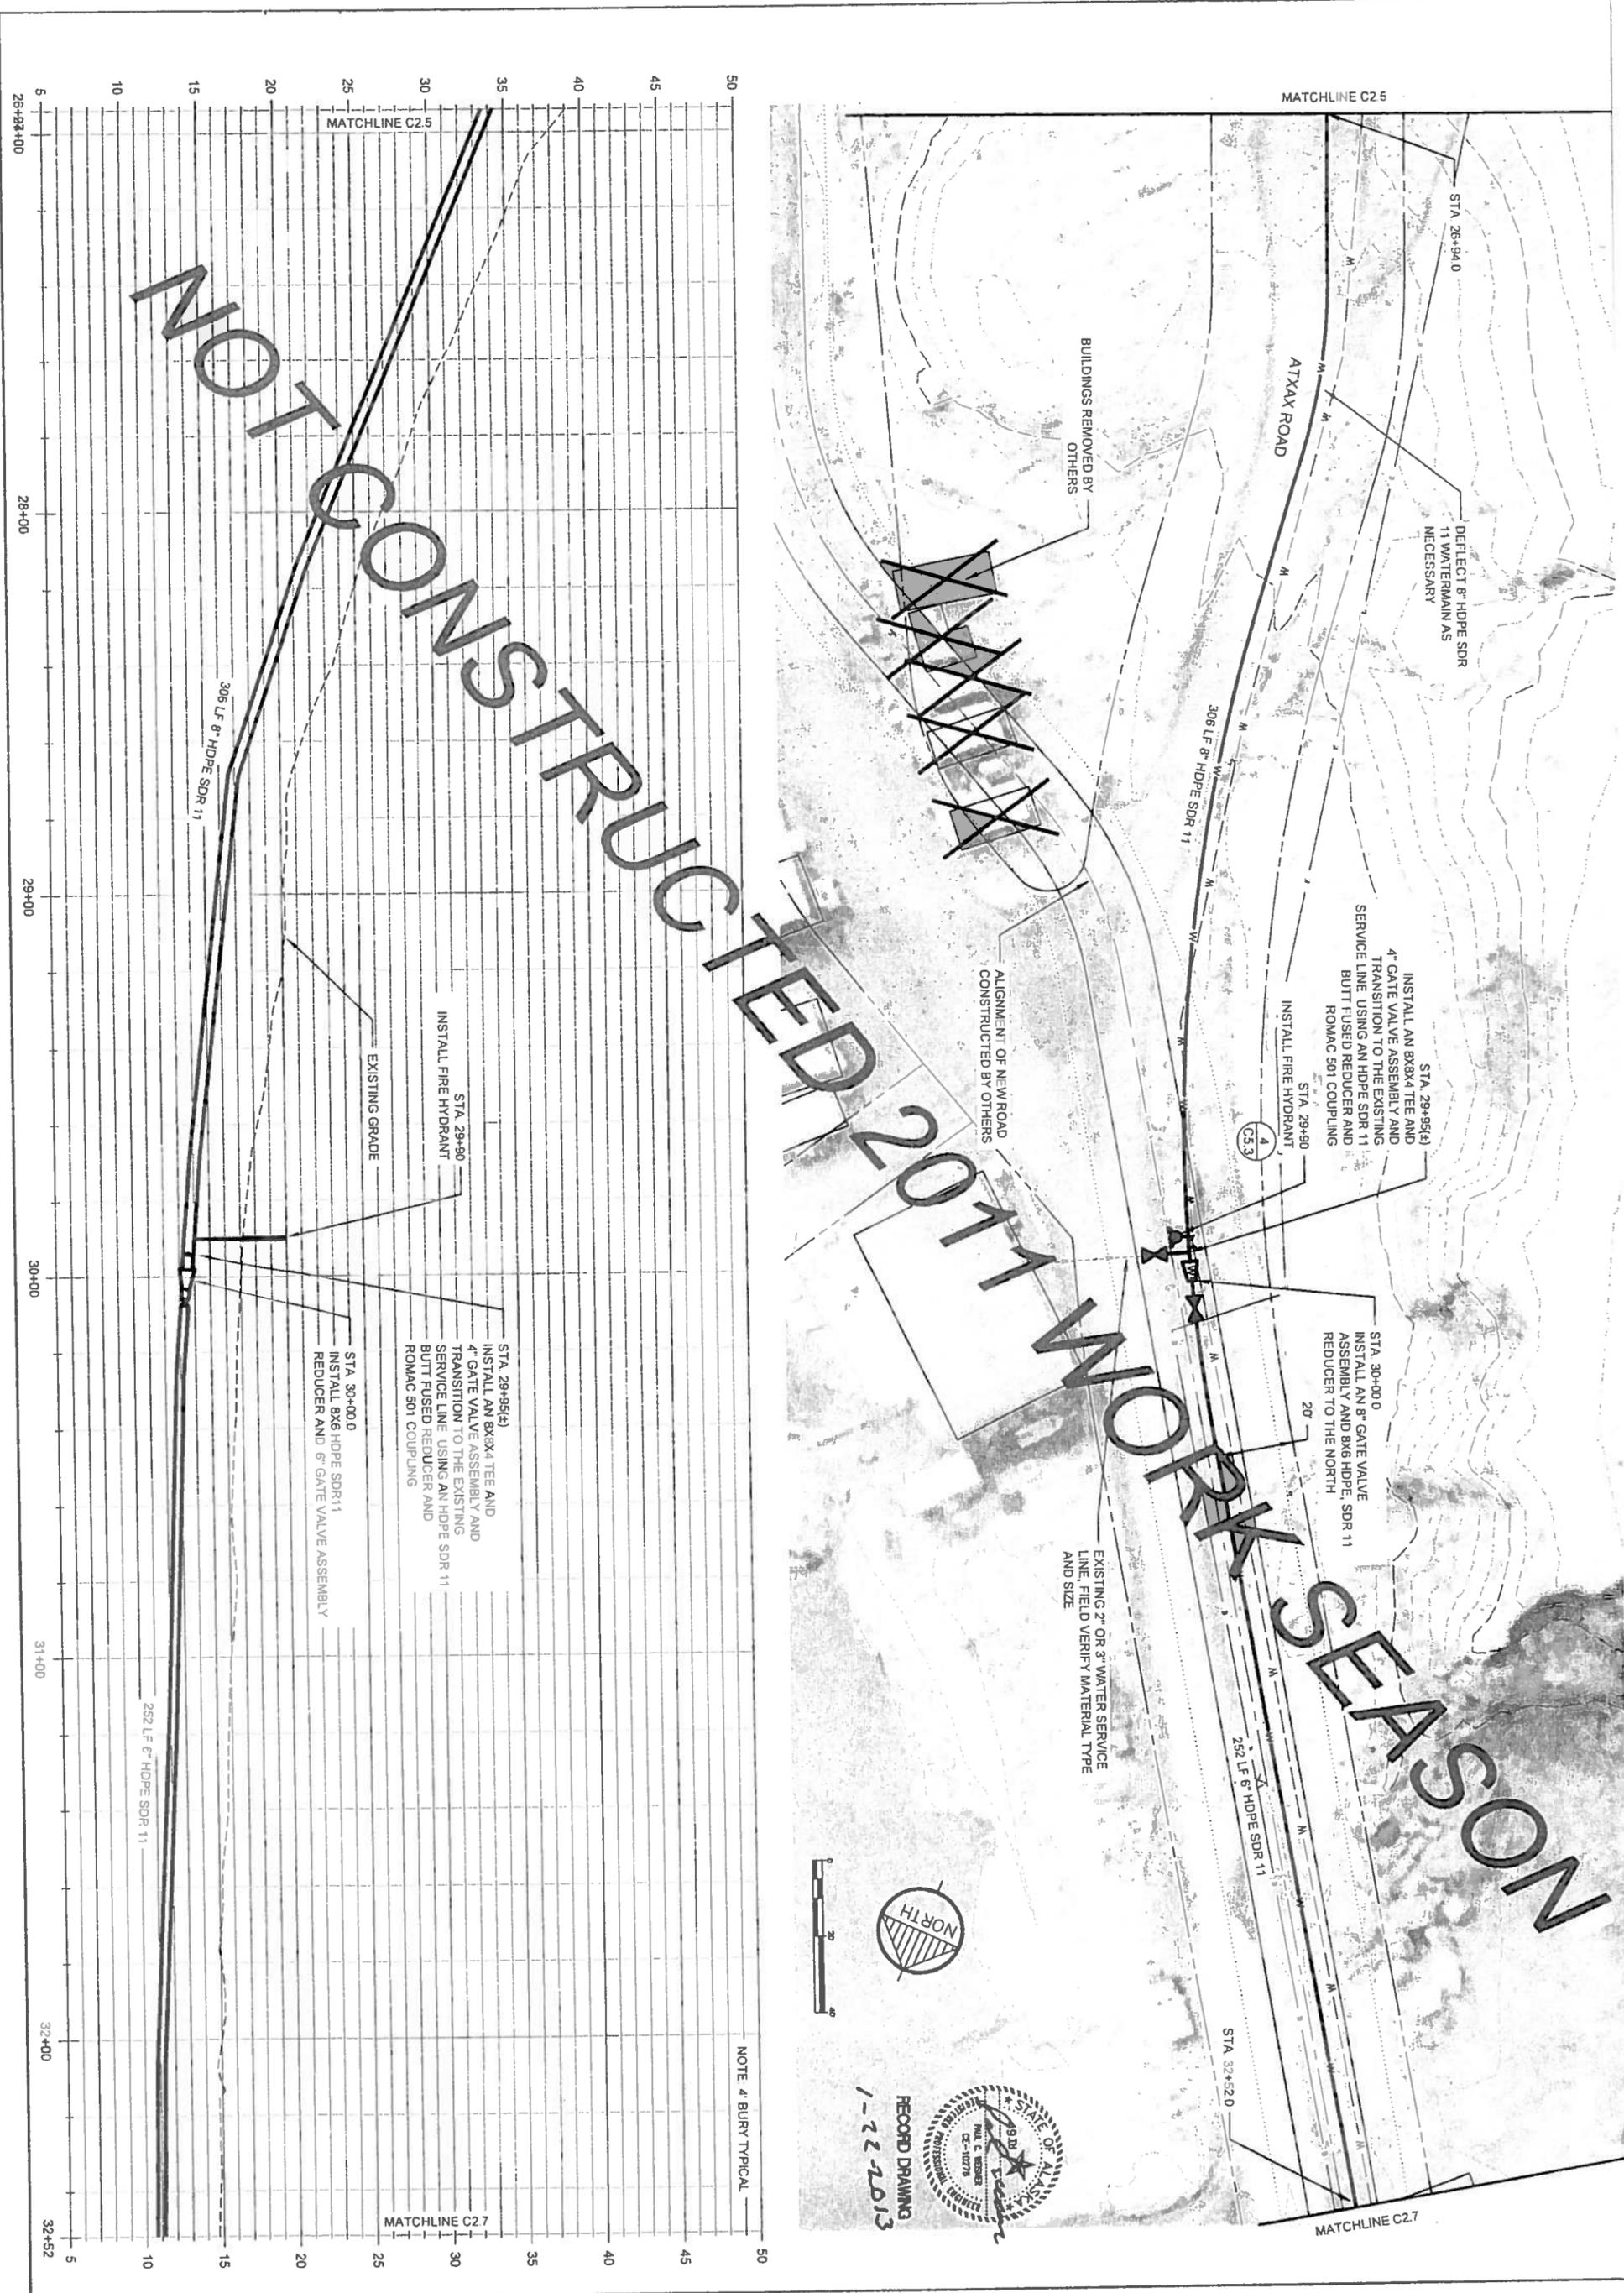

Project No.	
Date	MAY 2010
Designed	LAP
Drawn	CM
Approved	LAP

REVISION	BY	DATE

CE₂
ENGINEERS, INC.
 PO BOX 22946 ANCHORAGE, AK 99523 PR: 907-349-1010 FAX: 907-349-1015


2009 WATER SYSTEM UPGRADES
 PLAN AND PROFILE
 ATKA, ALASKA



CONSTRUCTION RECORD
FIELD BOOK
STAKING
FOREMAN
AS-BUILT
INSPECTOR

SCALE:
 1" = 40'

RECORD DRAWING CERTIFICATE	
THESE DRAWINGS REFLECT RECORDED INFORMATION OBTAINED DURING CONSTRUCTION. INFORMATION PROVIDED HEREIN IS ACCURATE TO THE BEST OF MY KNOWLEDGE.	
NAME	DATE

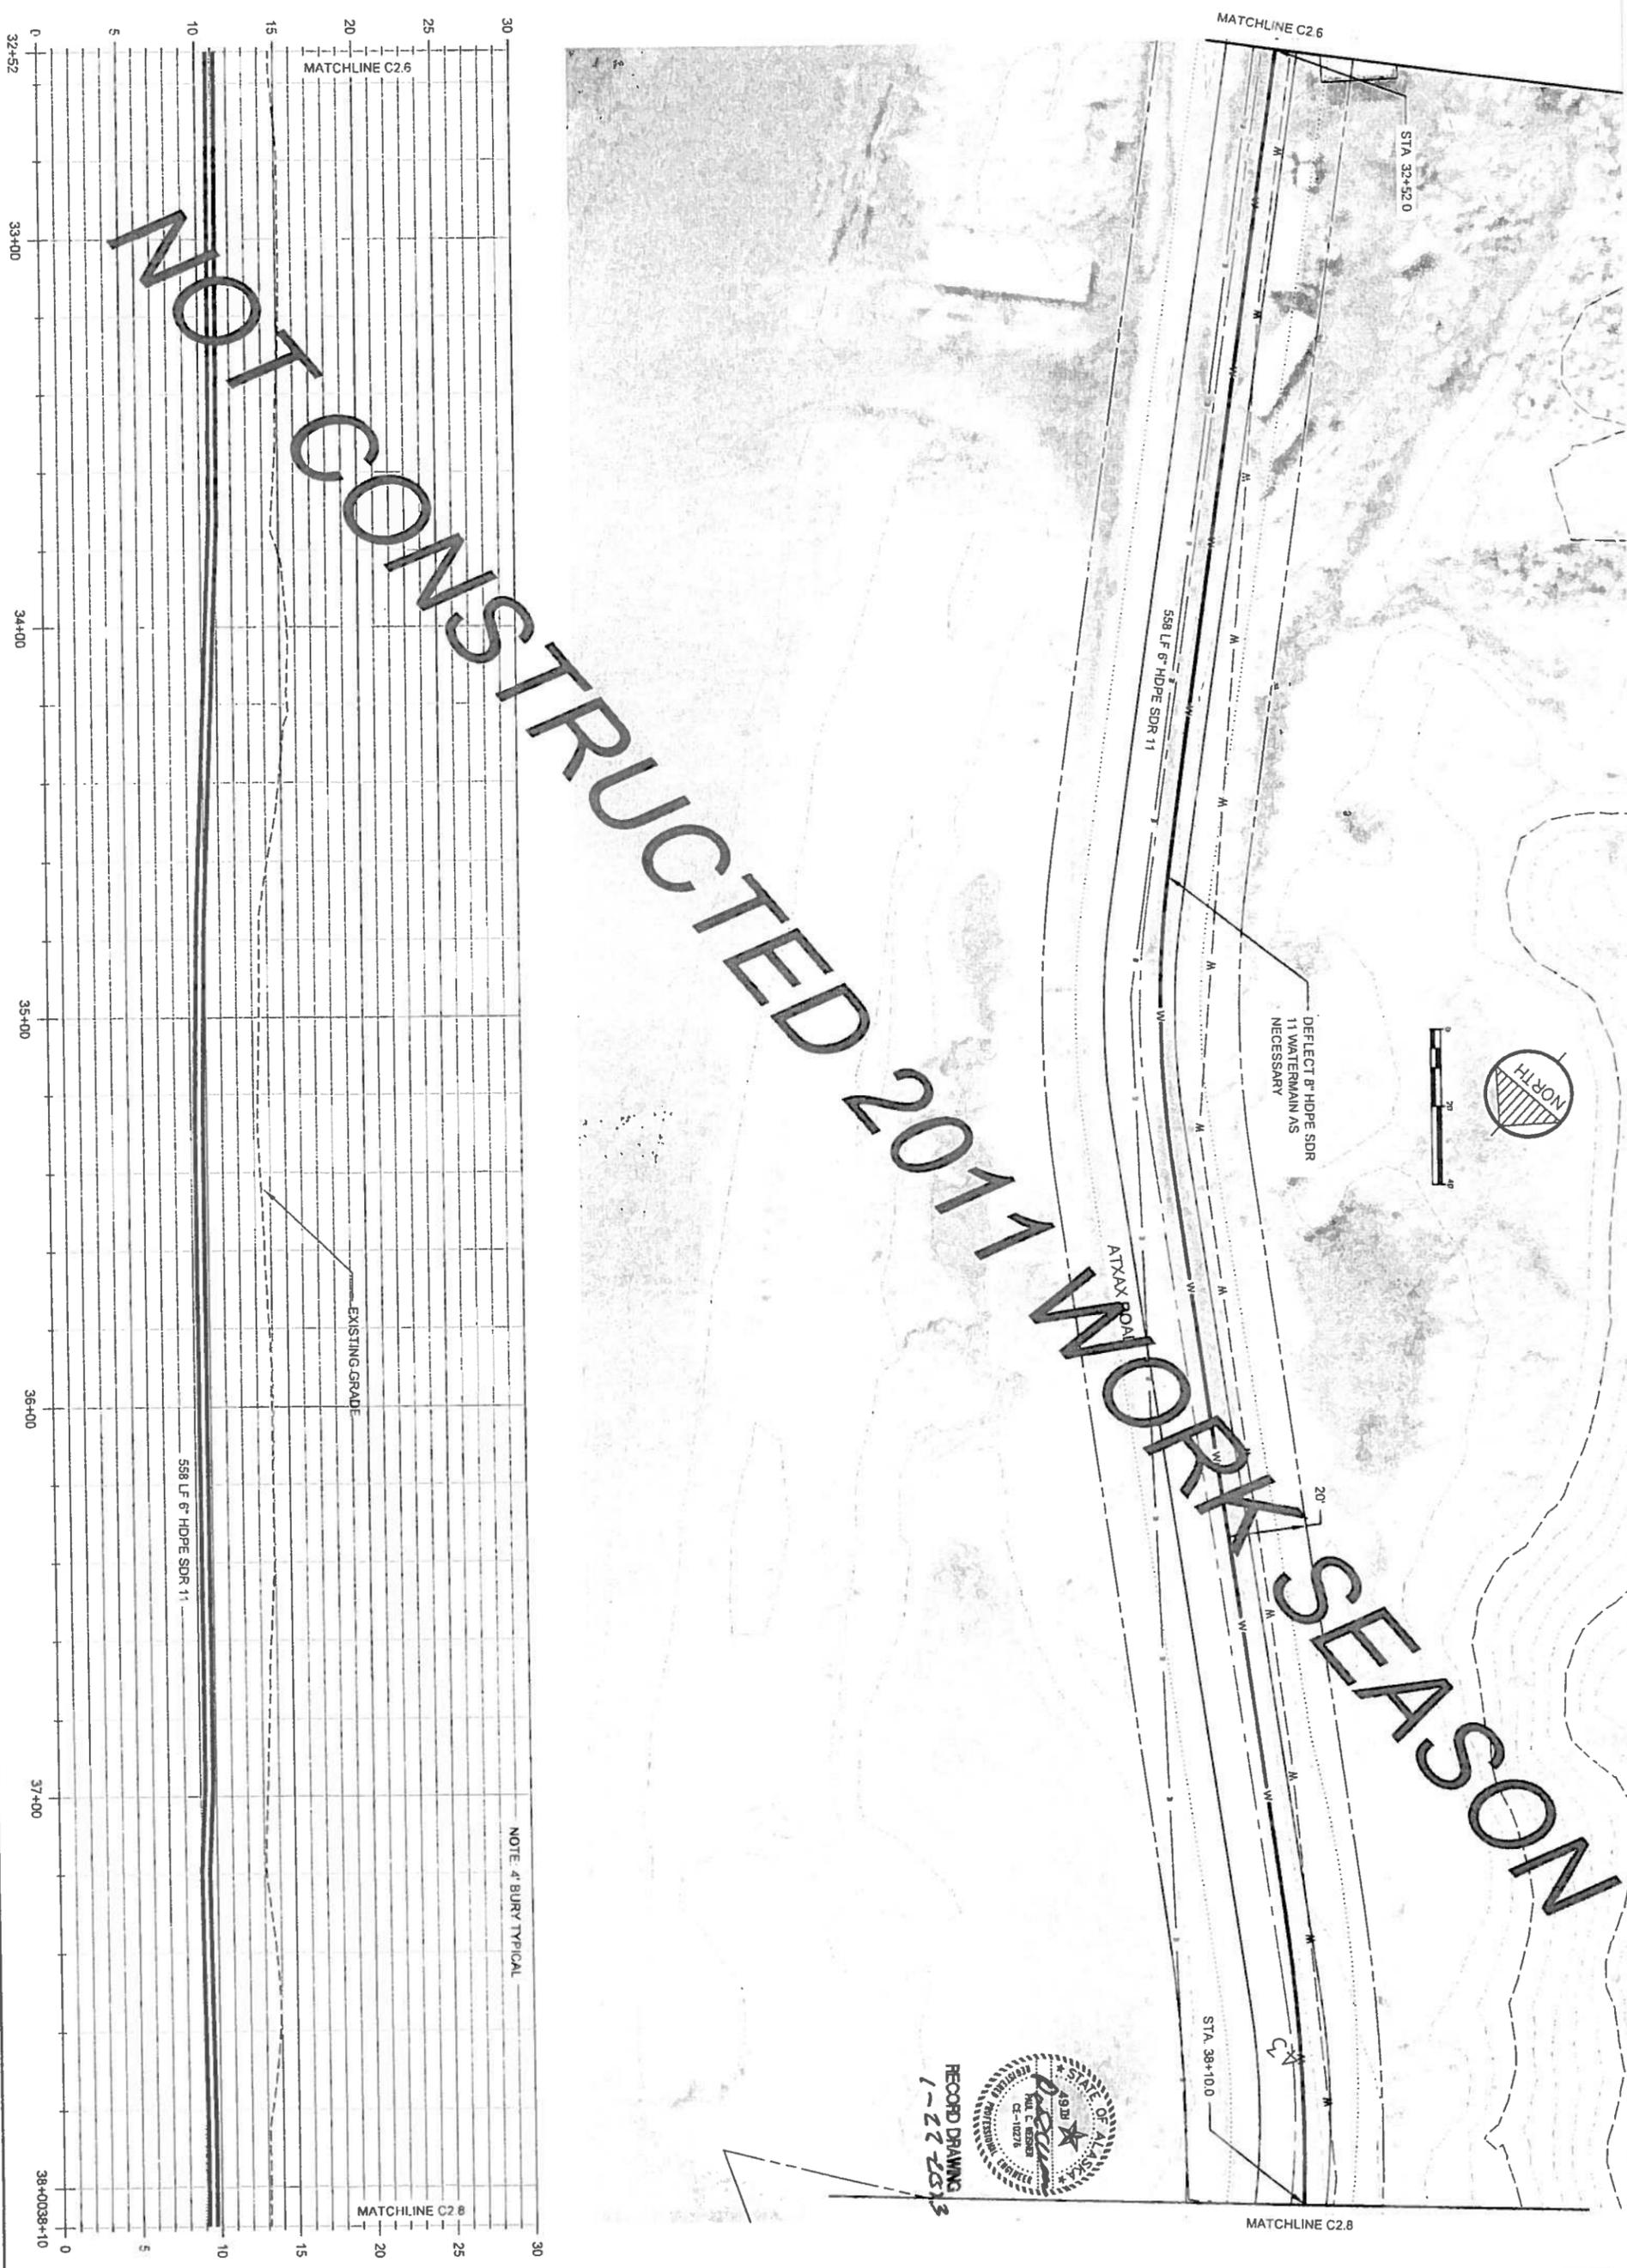

NOT TO BE CONSTRUCTED 2011 WINTER SEASON



Project No.	
Date	MAY 2010
Designed	LAP
Drawn	CM
Approved	LAP

REVISION	BY	DATE

CE₂

ENGINEERS, INC.

PO BOX 222948 ANCHORAGE, AK 99523 PH 807-343-1010 FAX 807-343-1015

2009 WATER SYSTEM UPGRADES

PLAN AND PROFILE

ATKA, ALASKA




CONSTRUCTION RECORD	FIELD BOOK
STAKING	
FOREMAN	
AS-BUILT	
INSPECTOR	

SCALE:

1" = 40'

IF NOT ONE INCH ON THIS SHEET, AS SHOWN ON ORIGINAL DRAWING.

RECORD DRAWING CERTIFICATE	
THESE DRAWINGS REFLECT RECORDED INFORMATION OBTAINED DURING CONSTRUCTION INFORMATION PROVIDED HEREIN IS ACCURATE TO THE BEST OF MY KNOWLEDGE.	
NAME	DATE

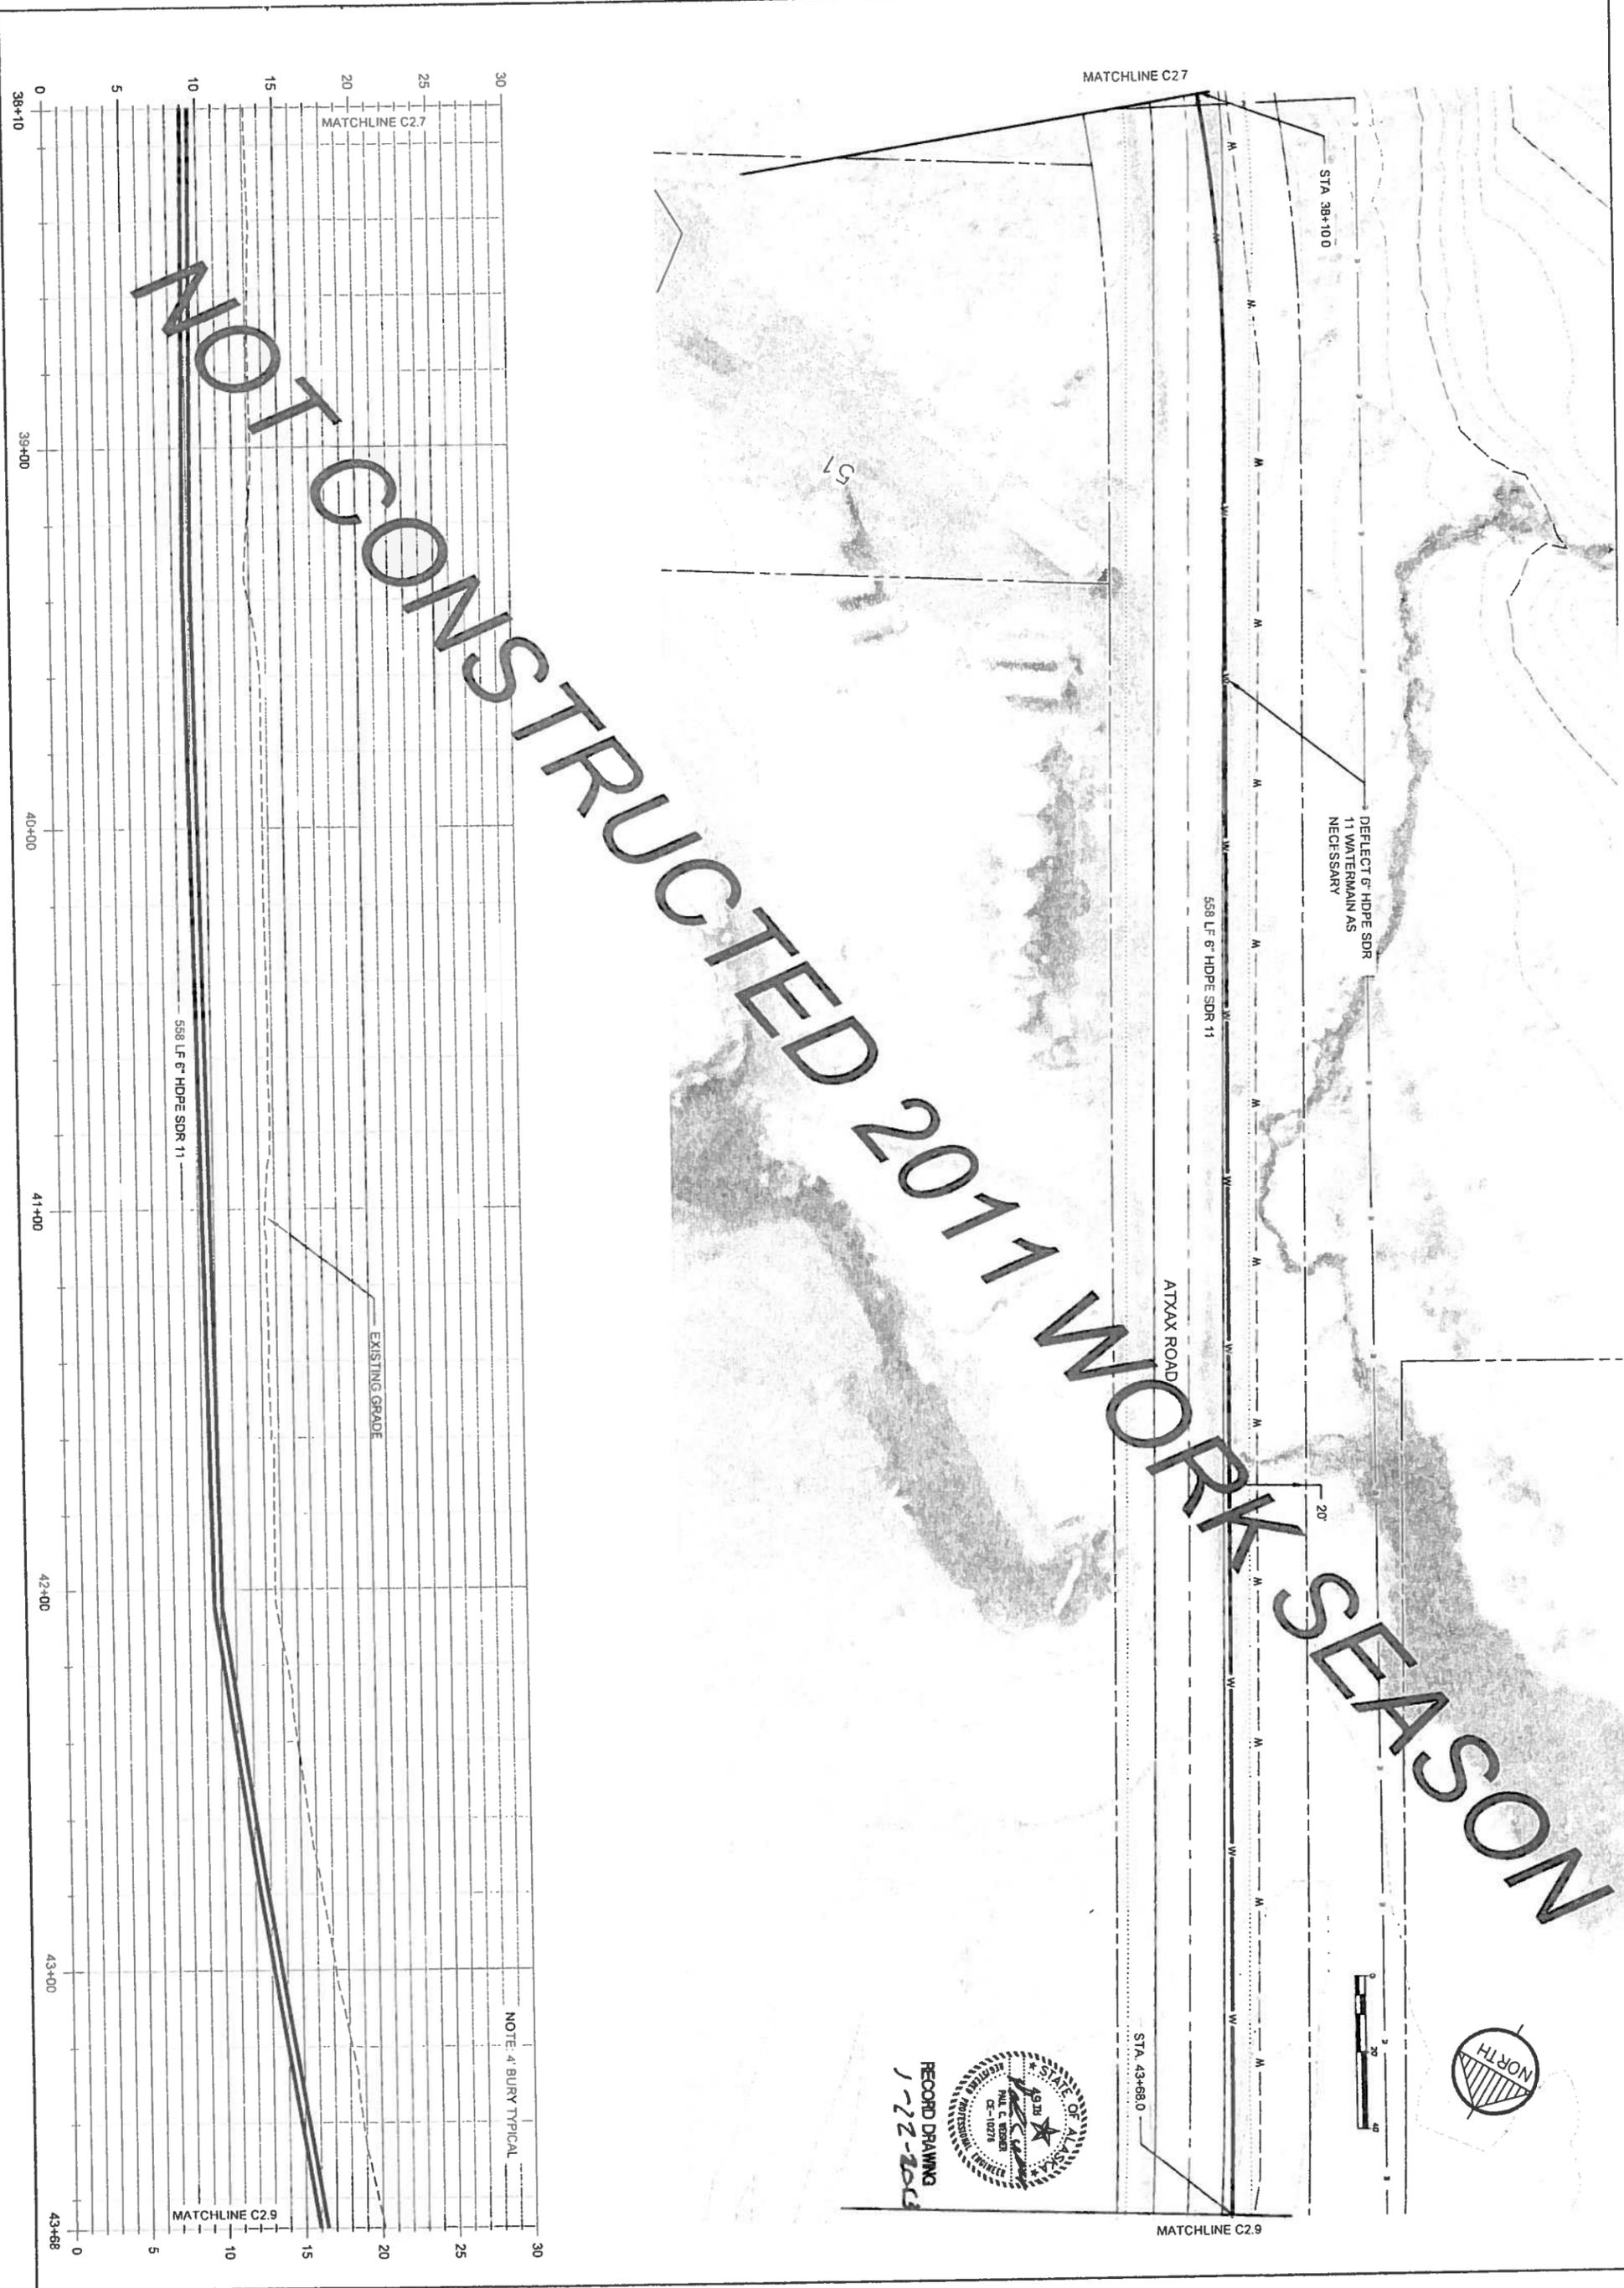

NOT TO BE CONSTRUCTED 2011 WINTER SEASON

RECORD DRAWING
1-22-2013



Sheet No. C2.8	Project No.
	Date MAY 2010
	Designed LAP
	Drawn CM
	Approved LAP

REVISION	BY	DATE

CE₂

ENGINEERS, INC.

PO BOX 232948 ANCHORAGE, AK 99523 PH: 907-348-1010 FAX: 907-348-1015

2009 WATER SYSTEM UPGRADES

PLAN AND PROFILE


ATKA, ALASKA



CONSTRUCTION RECORD	
FIELD BOOK	
STAKING	
FOREMAN	
AS-BUILT	
INSPECTOR	

SCALE	
1" = 40'	
1" = 20'	
1" = 10'	

RECORD DRAWING CERTIFICATE	
THESE DRAWINGS REFLECT RECORDED INFORMATION OBTAINED DURING CONSTRUCTION. INFORMATION PROVIDED HEREIN IS ACCURATE TO THE BEST OF MY KNOWLEDGE.	
NAME	DATE

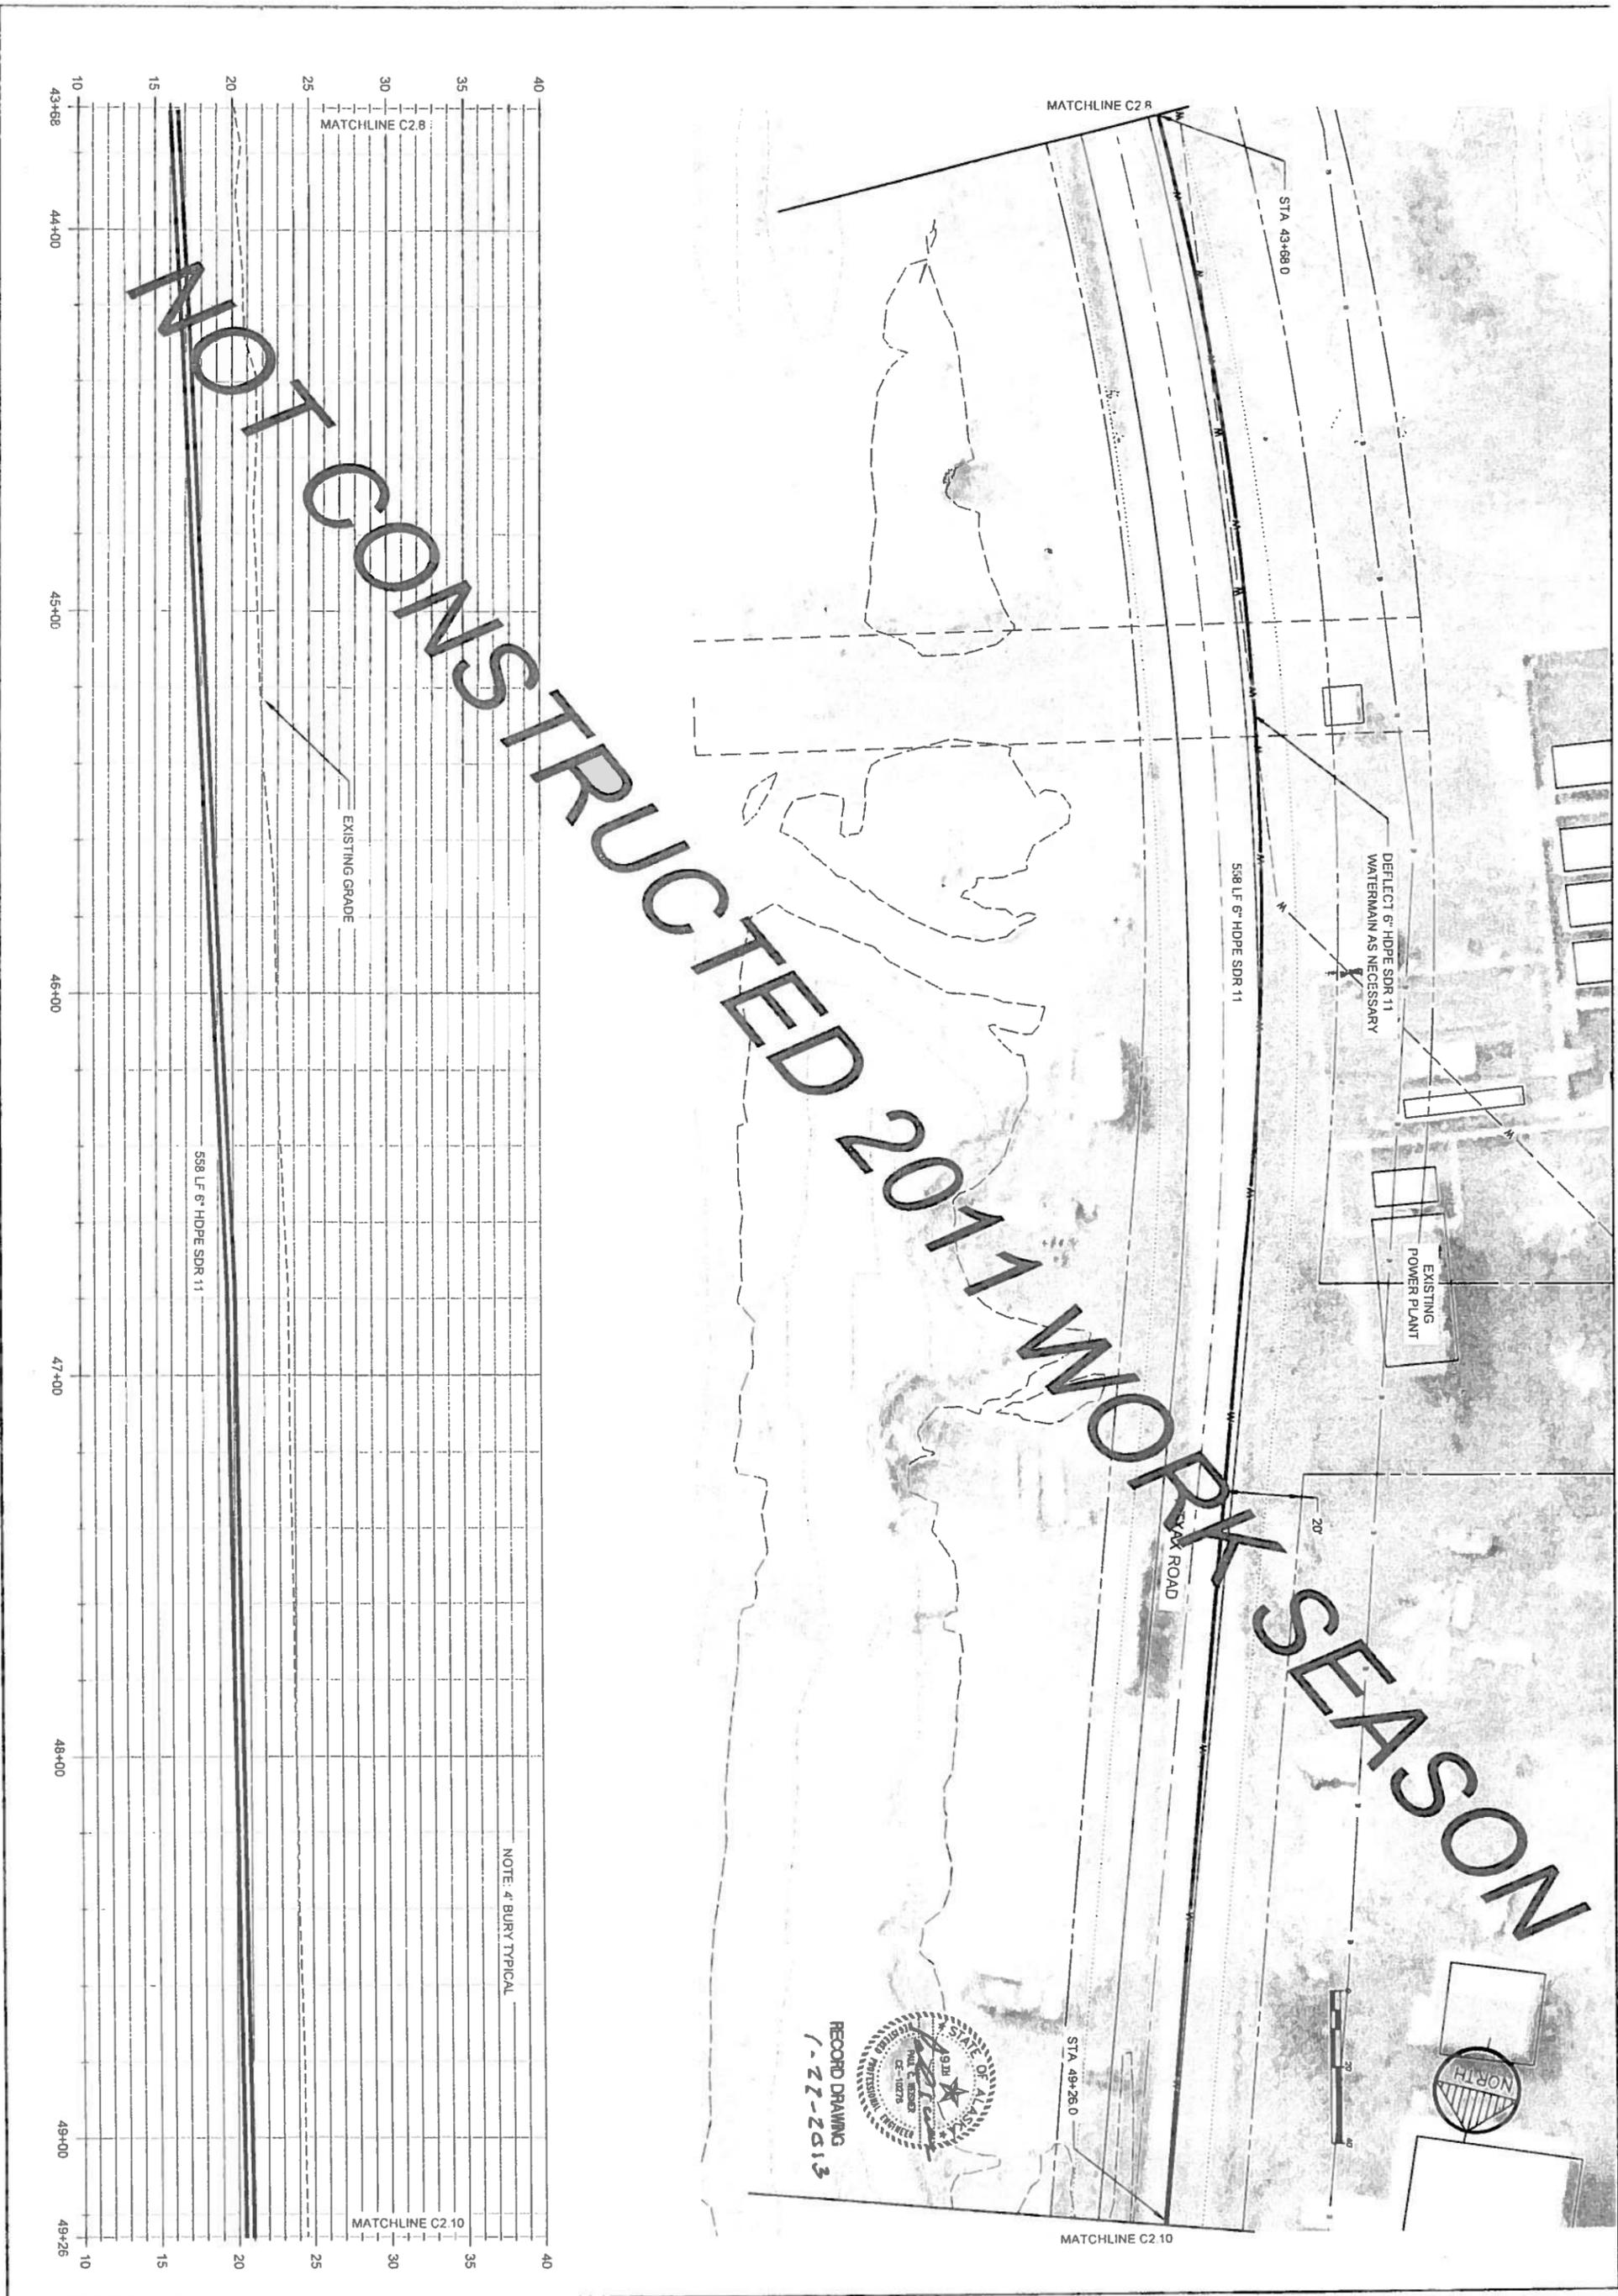

Project No.	
Date	MAY 2010
Designed	LAP
Drawn	CM
Approved	LAP

REVISION	BY	DATE

CE₂
ENGINEERS, INC.
 PO BOX 22296 ANCHORAGE, AK 99523 PR: 807-349-1010 FAX: 807-349-1015



2009 WATER SYSTEM UPGRADES
 PLAN AND PROFILE
 ATKA, ALASKA



CONSTRUCTION RECORD
FIELD BOOK
STAKING
FOREMAN
AS-BUILT
INSPECTOR


SCALE:
 BAR IS ONE INCH ON ORIGINAL DRAWING
 IF NOT ONE INCH ON THIS SHEET, ADJUST SCALES ACCORDINGLY

RECORD DRAWING CERTIFICATE
 THESE DRAWINGS REFLECT RECORDED INFORMATION OBTAINED DURING CONSTRUCTION. INFORMATION PROVIDED HEREIN IS ACCURATE TO THE BEST OF MY KNOWLEDGE.
 NAME _____ DATE _____

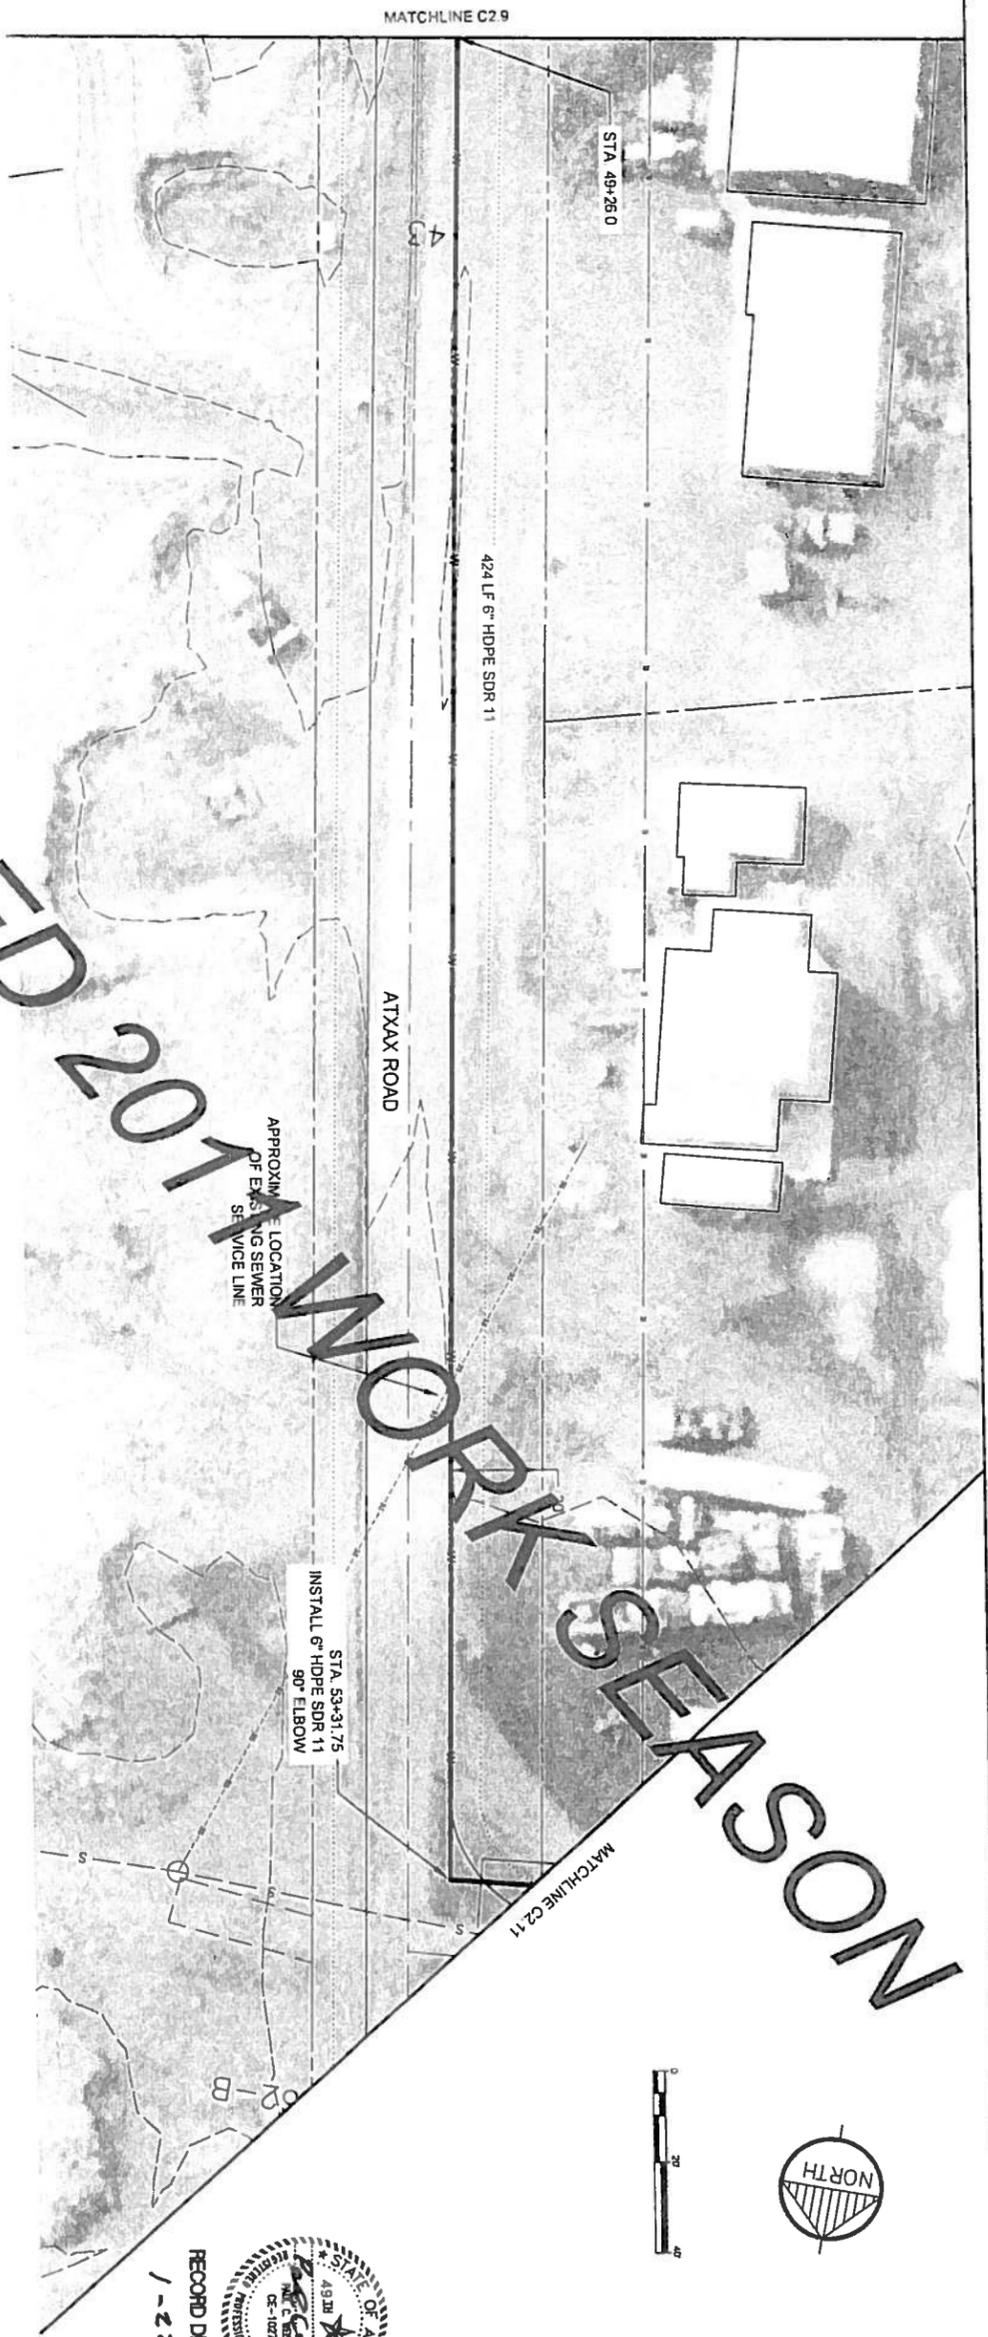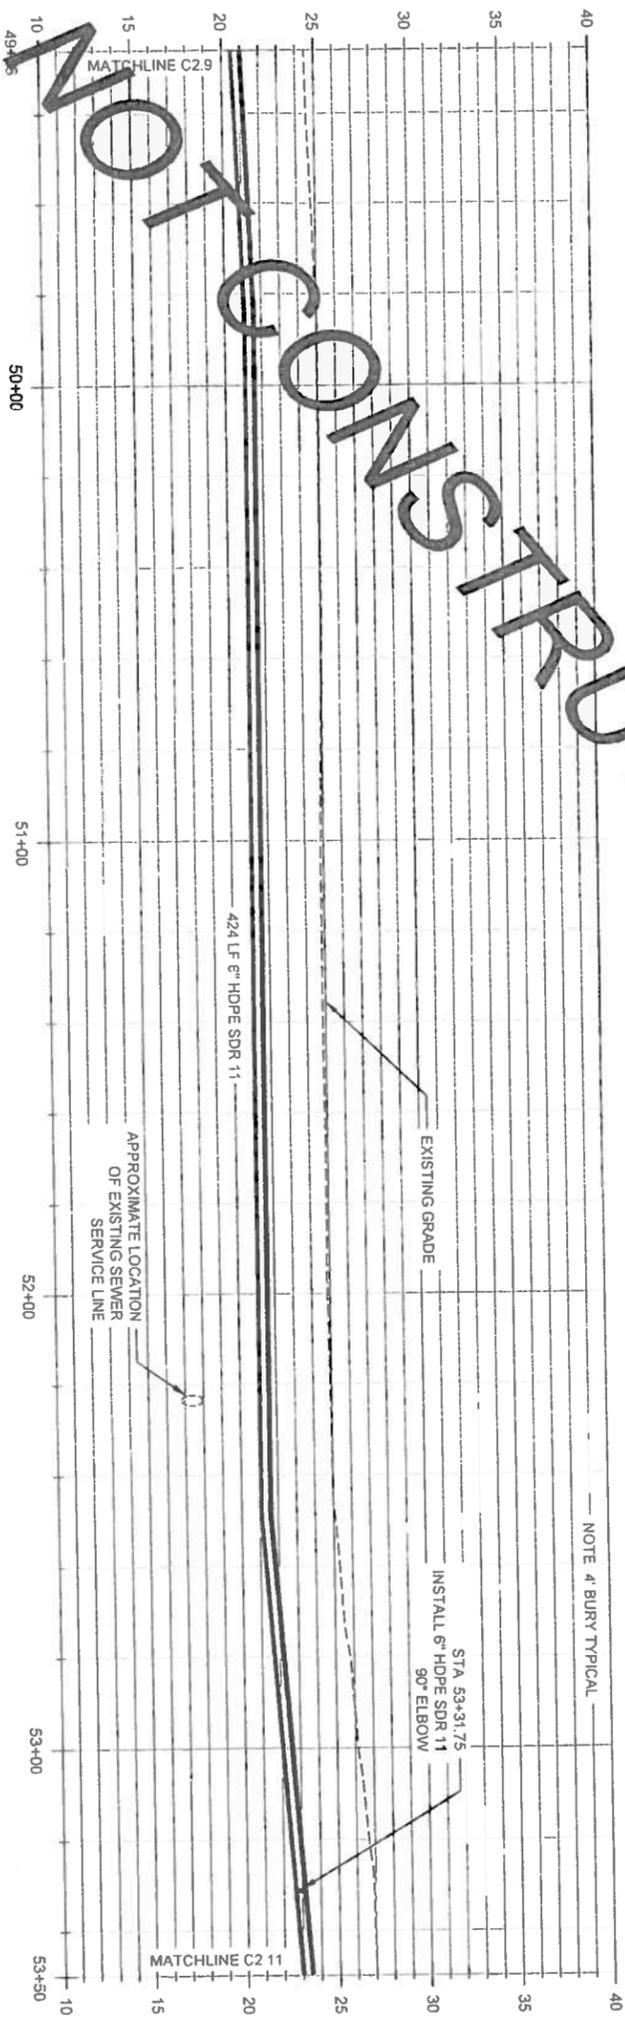


NOT TO BE CONSTRUCTED 2011 WORK SEASON

NOTE: 4' BURY TYPICAL

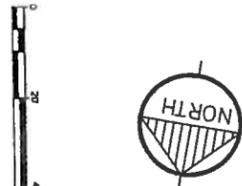


Sheet No. C2.10	Project No. Date MAY 2010 Designed LAP Drawn CM Approved LAP	<table border="1" style="width: 100%; border-collapse: collapse;"> <thead> <tr> <th>REVISION</th> <th>BY</th> <th>DATE</th> </tr> </thead> <tbody> <tr><td> </td><td> </td><td> </td></tr> <tr><td> </td><td> </td><td> </td></tr> <tr><td> </td><td> </td><td> </td></tr> </tbody> </table>	REVISION	BY	DATE										<p>CE₂ ENGINEERS, INC. PO BOX 232948 ANCHORAGE, AK 99523 PH: 907-343-1010 FAX: 907-348-1015</p>	2009 WATER SYSTEM UPGRADES PLAN AND PROFILE ATKA, ALASKA		<table border="1" style="width: 100%; border-collapse: collapse;"> <tr><th colspan="2">CONSTRUCTION RECORD</th></tr> <tr><td>FIELD BOOK</td><td> </td></tr> <tr><td>STAKING</td><td> </td></tr> <tr><td>FOREMAN AS BUILT</td><td> </td></tr> <tr><td>INSPECTOR</td><td> </td></tr> </table>	CONSTRUCTION RECORD		FIELD BOOK		STAKING		FOREMAN AS BUILT		INSPECTOR		SCALE: BAR IS ONE INCH ON ORIGINAL DRAWING IF NOT ONE INCH ON THIS SHEET, ADJUST SCALE'S ACCORDINGLY	<table border="1" style="width: 100%; border-collapse: collapse;"> <tr><th colspan="2">RECORD DRAWING CERTIFICATE</th></tr> <tr><td colspan="2">THESE DRAWINGS REFLECT RECORDED INFORMATION OBTAINED DURING CONSTRUCTION. INFORMATION PROVIDED HEREIN IS ACCURATE TO THE BEST OF MY KNOWLEDGE.</td></tr> <tr><td>NAME</td><td>DATE</td></tr> </table>	RECORD DRAWING CERTIFICATE		THESE DRAWINGS REFLECT RECORDED INFORMATION OBTAINED DURING CONSTRUCTION. INFORMATION PROVIDED HEREIN IS ACCURATE TO THE BEST OF MY KNOWLEDGE.		NAME	DATE
	REVISION	BY	DATE																																	
CONSTRUCTION RECORD																																				
FIELD BOOK																																				
STAKING																																				
FOREMAN AS BUILT																																				
INSPECTOR																																				
RECORD DRAWING CERTIFICATE																																				
THESE DRAWINGS REFLECT RECORDED INFORMATION OBTAINED DURING CONSTRUCTION. INFORMATION PROVIDED HEREIN IS ACCURATE TO THE BEST OF MY KNOWLEDGE.																																				
NAME	DATE																																			


- TRENCH NOTES**
1. PIPE ZONE MATERIAL SHALL BE TYPE A BACKFILL MEETING ADOT 6.07 STANDARD SPECIFICATIONS FOR HIGHWAY CONSTRUCTION. SEE SHEET G1.2 FOR PLACEMENT AND COMPACTION REQUIREMENTS.
 2. TRENCH ZONE MATERIAL SHALL NOT CONTAIN ORGANIC OR OTHER DELETERIOUS MATERIALS. SEE SHEET G1.2 FOR PLACEMENT AND COMPACTION REQUIREMENTS.
 3. TRENCH WALL SHALL BE SLOPED OR SHORED IN CONFORMANCE WITH ALL APPLICABLE SAFETY STANDARDS.
 4. REPLACE DISTURBED ROADWAY PER TYPICAL TRENCH SECTION.
 5. MINIMUM DEPTH OF BURY SHALL BE 4' (TYPICAL). IF 2' OF INSULATION BOARD IS INSTALLED, DEPTH OF BURY MAY BE REDUCED TO NOT LESS THAN 3'.

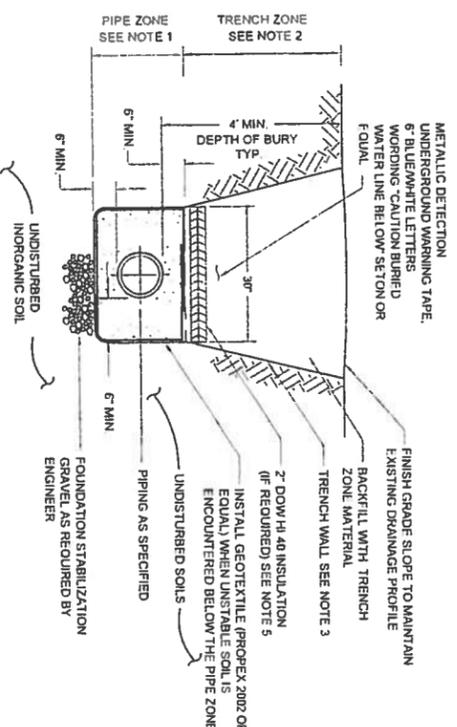


1 TYPICAL TRENCH SECTION
SCALE: NTS
C5.1

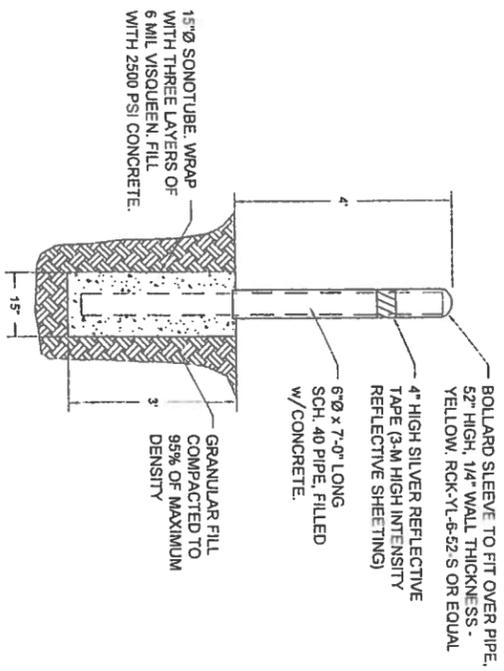

5 BOLLARD DETAIL
SCALE: NTS
C5.1

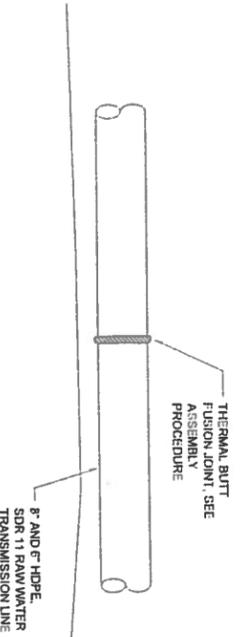


2 WATER AND FORCEMAIN BUTT FUSED PIPE JOINT DETAIL
SCALE: NTS
C5.1

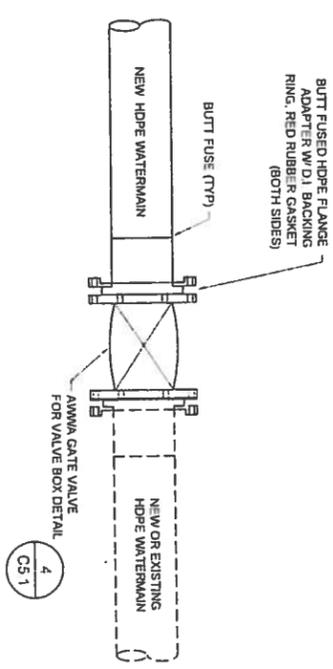

3 TYPICAL GATE VALVE JOINT DETAIL
SCALE: NTS
C5.1

- WATERMAIN JOINT ASSEMBLY PROCEDURE**
- TRANSPORTATION AND SETUP:**
1. EXTREME CARE SHOULD BE TAKEN WHEN BREAKING FACTORY BUNDLES AND TRANSPORTING PIPING TO THE PLACEMENT LOCATION. IF BOTH ENDS OF THE TUBER BEFORE MOVING, THE SECTION SHOULD BE SECURED TO PREVENT MOVING. THE SECTION SHOULD BE LOOSE LOADED, ONLY UNLIT THE GROUP OF PIPING TO BE LIFTED. CHAINS SHOULD NOT BE APPLIED DIRECTLY TO THE PIPE AND POINT LOADS SHOULD BE AVOIDED.
 2. DO NOT DRAG THE PIPE PRIOR TO FINAL PLACEMENT OF NEW PIPING.
 3. DO NOT DROP THE PIPING.
 4. PROVIDE ADEQUATE SUPPORTS NEAR THE FUSION STATION TO MATCH THE ALIGNMENT OF THE TWO PIPES TO BE FUSED.
 5. PRIOR TO INSTALLING ANY PIPE, INSPECT THE EXTERIOR FOR DAMAGE AND SWAB OUT THE INTERIOR TO REMOVE ANY LOOSE DEBRIS.
- THERMAL BUTT FUSION PROCEDURE**
- ALL THERMAL BUTT FUSION PROCEDURES USED SHALL BE IN ACCORDANCE WITH THE PLASTIC PIPE INSTITUTE AND THE HDPE PIPE MANUFACTURER'S RECOMMENDATIONS AND RECORDED ON THE ATTACHED HDPE JOINT FUSION LOG.
- THERMAL BUTT FUSION PROCEDURES GENERALLY INCLUDE:**
1. CLEAN, CLAMP AND ALIGN THE PIPE ENDS TO BE JOINED.
 2. FACE THE PIPE ENDS TO ESTABLISH CLEAN, PARALLEL SURFACES, PERPENDICULAR TO THE CENTERLINE.
 3. ALIGN THE PIPE ENDS.
 4. CONFIRM THE HEATER PLATE TEMPERATURE AT 430°F.
 5. MELT THE PIPE INTERFACES WHILE MAINTAINING FULL CONTACT WITH THE HEATER PLATE BUT NO PRESSURE. THE APPROXIMATE BEAD SIZE SHOULD BE 1/8" TO 3/16" DIAMETER.
 6. REMOVE THE HEATER PLATE AND QUICKLY INSPECT THE ENDS OF THE PIPE. IF A CONCAVE MELT SURFACE IS OBSERVED, DO NOT CONTINUE. ALLOW THE PIPE TO COOL AND START BEADING. TOO MUCH PRESSURE WAS USED AGAINST THE HEATER PLATE.
 7. JOIN THE TWO PIPE ENDS TOGETHER BY APPLYING THE PROPER FUSION FORCE FOR APPROXIMATELY 4 MINUTES.
 8. HOLD UNDER PRESSURE UNTIL THE JOINT IS FULLY COOL.
 9. VISUALLY INSPECT THE FUSION JOINT FOR PROPER ALIGNMENT AND PROPER FUSION BEADS.

6 WATERMAIN JOINT ASSEMBLY PROCEDURE
SCALE: NTS
C5.1

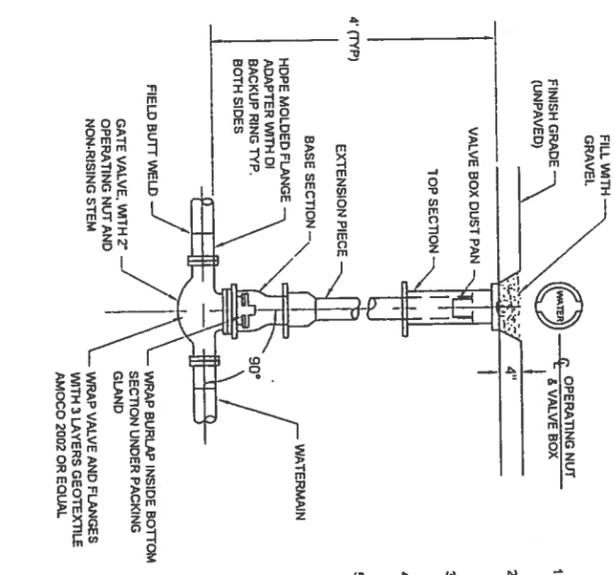

4 GATE VALVE CONNECTION DETAIL
SCALE: NTS
C5.1

HDPE Joint Fusion Log

Project: _____ Date: _____

Weather Observation: _____ Air Temp: _____

Location of Fused Joint: _____ Station or swig the location: _____

Pipe Size and SDR Rating: _____ Type Fusion Machine: _____

Task	CHECK LIST
Pipe fusion surfaces square, cleaned and faced?	✓
Observed heating cycle for even and uniform roll back of bead	
Note Hot Plate Temperature	
Pressure Gauge reading during fusion process	
Comments and Observations:	

Fusion Machine Operator: (write name legibly below signature)

Observed and Inspected By: (write name legibly below signature)

7 SAMPLE FUSION LOG
SCALE: NTS
C5.1

GATE VALVE NOTES:

1. LID AND TOP SECTION TO BE OLYMPIC FOUNDRY TYPE C OR EQUIVALENT.
2. EXTENSION PIECE TO BE OLYMPIC FOUNDRY TYPE A, OR 5\"/>

RECORD DRAWING CERTIFICATE


THESE DRAWINGS REFLECT RECORDED INFORMATION OBTAINED DURING CONSTRUCTION. INFORMATION PROVIDED HEREIN IS ACCURATE TO THE BEST OF MY KNOWLEDGE.

NAME _____ DATE _____




RECORD DRAWING
1-23-2015


CE2 ENGINEERS, INC. PO BOX 23294 ANCHORAGE, AK 99523 PH: 907-349-1010 FAX: 907-349-1015	2009 WATER SYSTEM UPGRADES TRENCH SECTION AND PIPE DETAILS ATKA, ALASKA	CONSTRUCTION RECORD FIELD BOOK STAKING FOREMAN AS-BUILT INSPECTOR	SCALE: AS SHOWN 1" = 1'	RECORD DRAWING CERTIFICATE THESE DRAWINGS REFLECT RECORDED INFORMATION OBTAINED DURING CONSTRUCTION. INFORMATION PROVIDED HEREIN IS ACCURATE TO THE BEST OF MY KNOWLEDGE.						
	Project No. _____ Date: MAY 2010 Designed: LAP Drawn: DDR Approved: LAP	REVISION <table border="1"> <tr> <th>REVISION</th> <th>BY</th> <th>DATE</th> </tr> <tr> <td> </td> <td> </td> <td> </td> </tr> </table>	REVISION	BY	DATE				STATE OF ALASKA 49 TH Lyle A. Perrow No. CE 902 REGISTERED PROFESSIONAL ENGINEER	IF NOT ONE INCH ON THIS SHEET ADJUST SCALES ACCORDINGLY.
REVISION	BY	DATE								

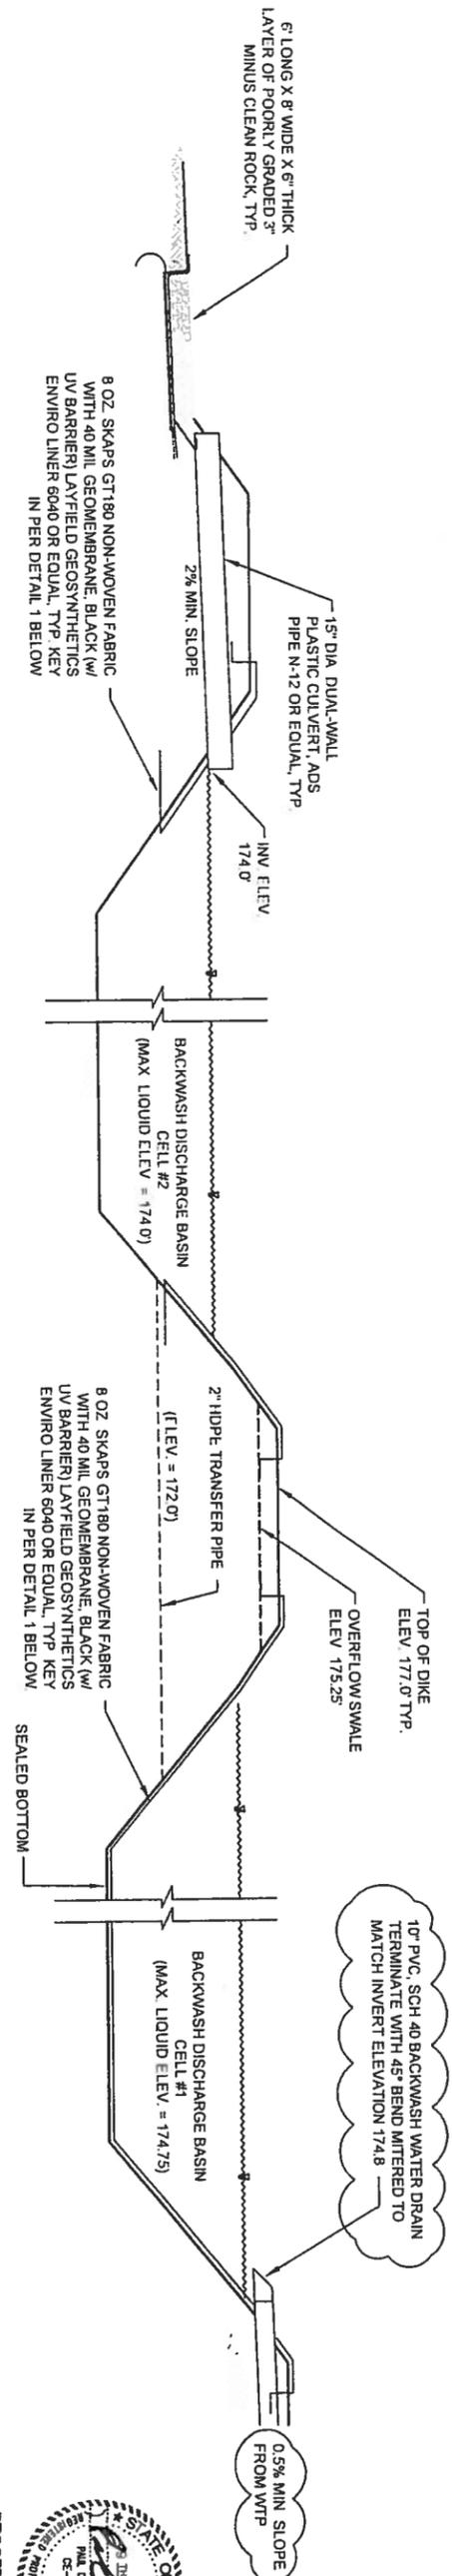


A SECTION A: BACKWASH WATER DISCHARGE BASIN - CENTERLINE THROUGH DRAIN STRUCTURE
SCALE: NO SCALE

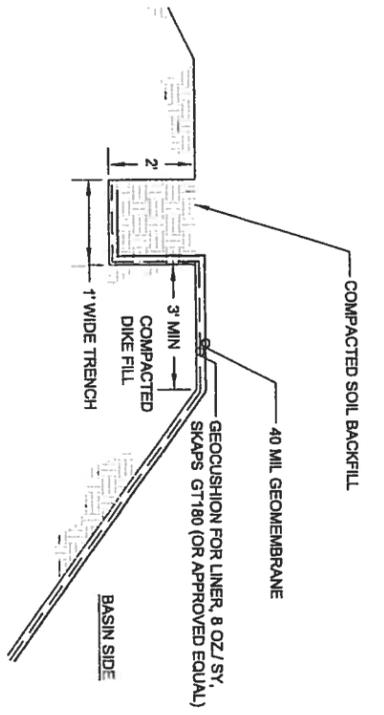


1 LINER KEY DETAIL
SCALE: NTS

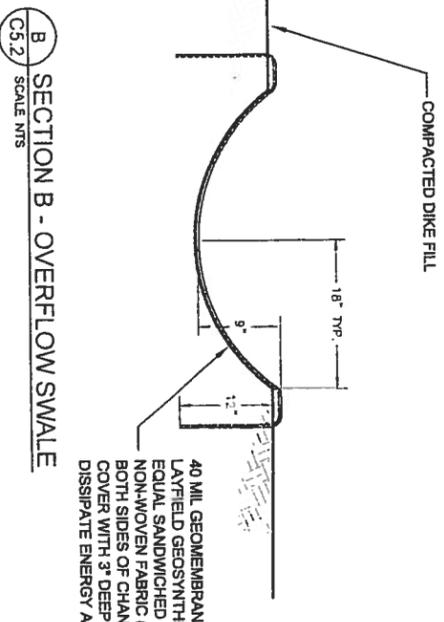


B SECTION B - OVERFLOW SWALE
SCALE: NTS

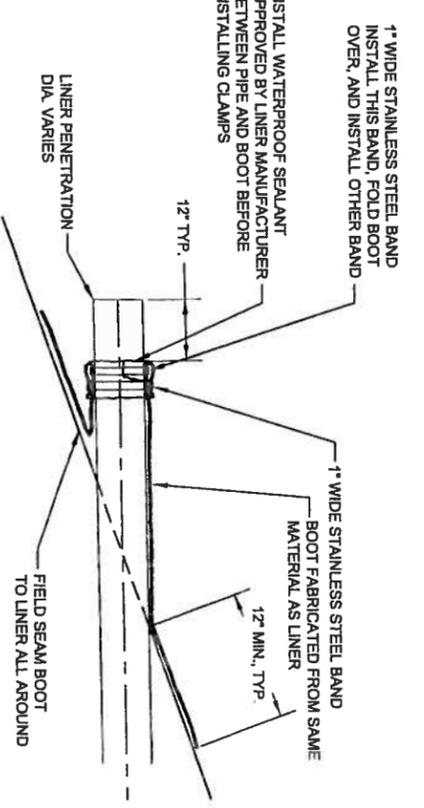

2 BOOT DETAIL
SCALE: NTS

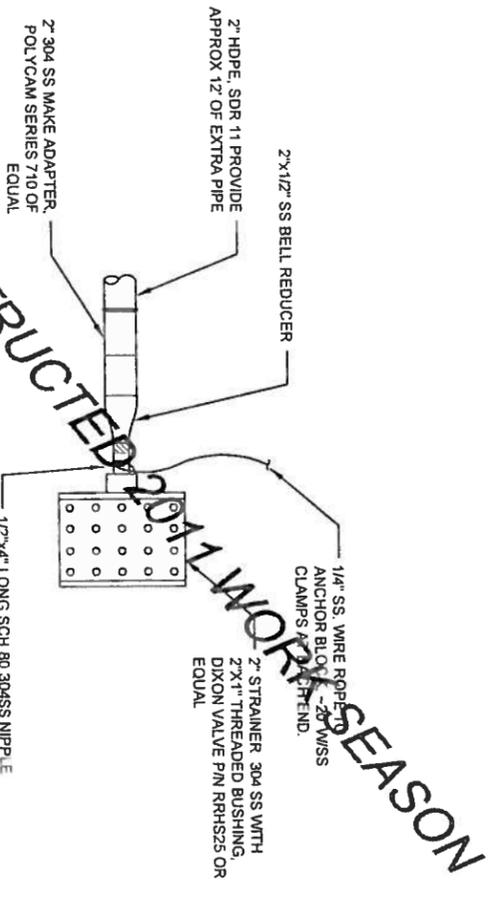

3 TRANSFER SCREEN ASSEMBLY
SCALE: NTS

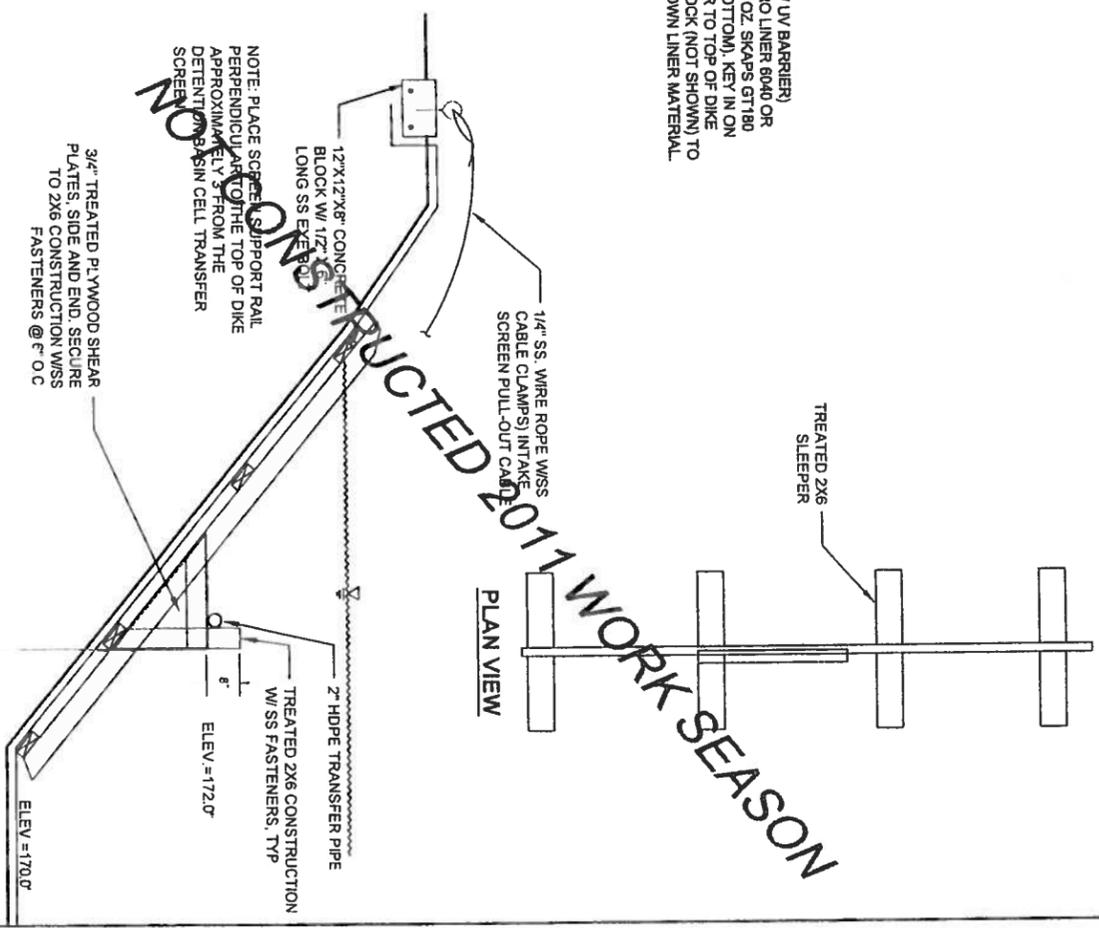


4 INTAKE SCREEN SUPPORT RAIL ASSEMBLY
SCALE: NTS

NOT CONSTRUCTED 2011 WORK SEASON

RECORD DRAWING
1-22-2013


Project No. _____ Date: MAY 2010 Designed: LAP Drawn: RZ Approved: LAP	REVISION CHANGED DRAIN PIPE INVERT & SLOPE BY: MRE DATE: 8/11	 PO BOX 222846 ANCHORAGE, AK 99523 PH: 907-348-1910 FAX: 907-348-1015	2009 WATER SYSTEM UPGRADES LAGOON DRAIN DETAILS WATER TREATMENT SITE ATKA, ALASKA		CONSTRUCTION RECORD FIELD BOOK _____ STAKING _____ FOREMAN _____ AS-BUILT _____ INSPECTOR _____	SCALE: 1" = 10' IF NOT ONE INCH ON THIS SHEET, QUALITY SCALE IS ACCORDINGLY	RECORD DRAWING CERTIFICATE THESE DRAWINGS REFLECT RECORDED INFORMATION OBTAINED DURING CONSTRUCTION. INFORMATION PROVIDED HEREIN IS ACCURATE TO THE BEST OF MY KNOWLEDGE. NAME: _____ DATE: _____
--	--	--	--	--	--	---	---

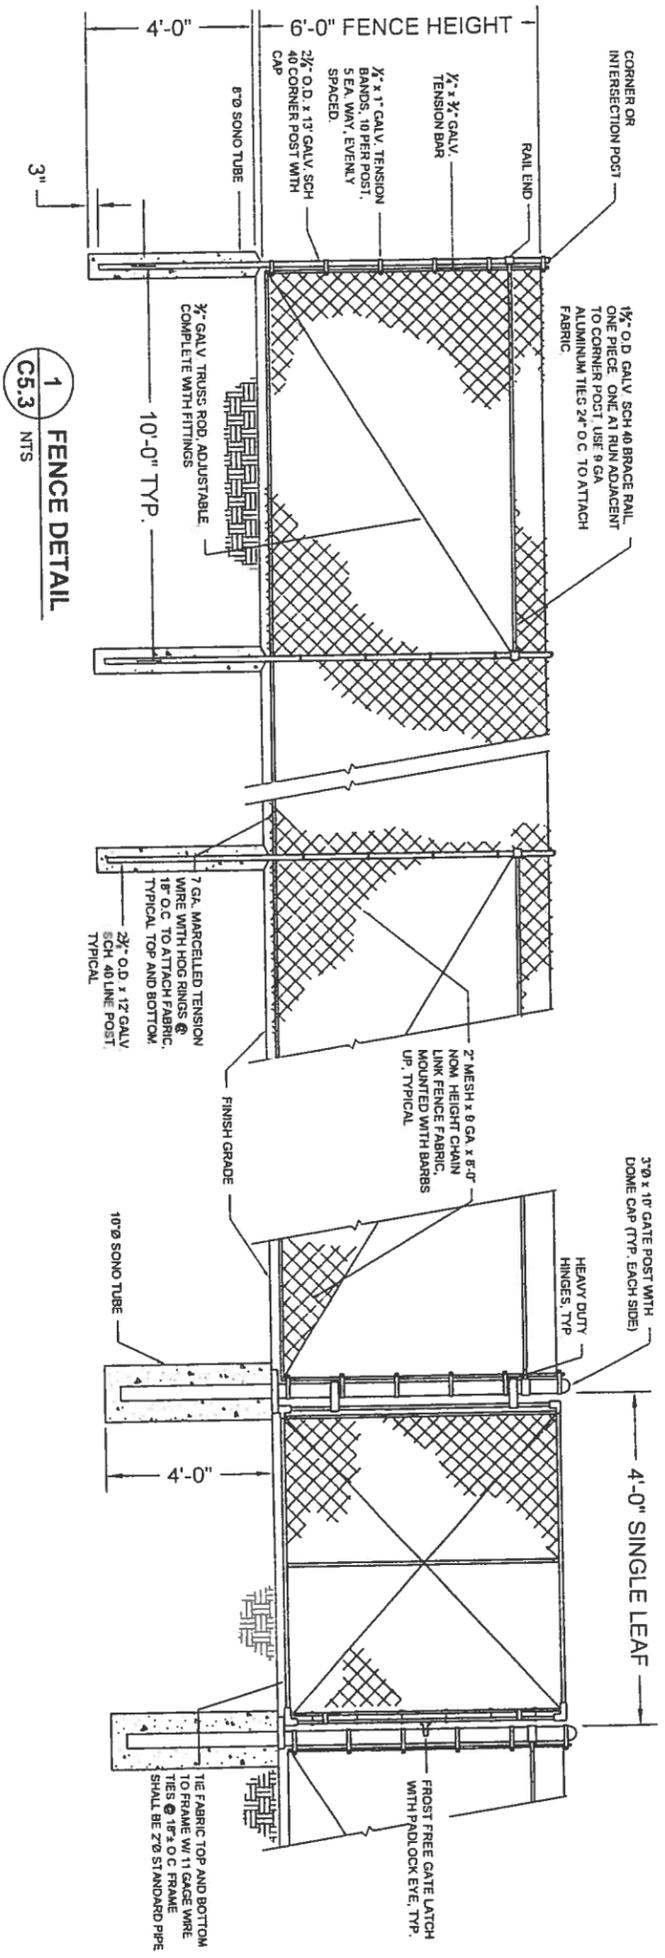

1 FENCE DETAIL
C5.3 NTS


2 GATE DETAIL
C5.3 NTS

- FENCE INSTALLATION NOTES:**
1. A STRING LINE SHALL BE USED TO PROMOTE TRUE ALIGNMENT AND FLOWING GRADE CHANGES. POST TOPS MAY BE TRIMMED AS REQUIRED FOR GOOD APPEARANCE.
 2. DETAILS SHOWN ARE TO INDICATE GENERAL DESIGN ONLY. DIMENSIONS MAY VARY SLIGHTLY.
 3. GATE FABRIC SHALL BE OF THE SAME DESIGN AND HEIGHT AS LINE FENCE FABRIC. ALL SPLICES IN THE FENCING FABRIC SHALL BE MADE BY WEAVING THE STRANDS OF FABRIC TOGETHER IN A VERTICAL SEAM.
 4. GATE FRAMES MAY BE FABRICATED BY WELDING OR RIVETING AND SHALL BE BRACED TO ELIMINATE SAGGING. HINGES, LATCHES, AND OTHER GATE APPURTENANCES SHALL BE OF SUFFICIENT STRENGTH AND DESIGN TO ASSURE EASY, TROUBLE FREE OPERATION.
 5. POSTS SHALL BE SPACED EQUAL DISTANCES APART. MAXIMUM SPACING SHALL BE 10 FEET UNLESS DIRECTED OTHERWISE BY THE ENGINEER. POST TOPS SHALL BE SECURELY FASTENED TO POST AND SHALL BE STRETCHED TO A SMOOTH UNIFORM APPEARANCE.
 6. FABRIC SHALL BE STRETCHED TO A SMOOTH UNIFORM APPEARANCE.
 7. LINE POST SHALL BE SET IN 5 SACK, 2000 PSI CONCRETE UNLESS SHOWN OTHERWISE ON THE PLANS.
 8. WIRE FENCING SHALL BE PLACED ON SIDE OF POST FACING OUTWARD. THE WIRES SHALL BE 9 GAUGE ALUMINUM.
 9. ALL WIRE, POSTS AND HARDWARE SHALL BE GALVANIZED. WEIGHTS AND GAGES SPECIFIED ARE MINIMUMS BEFORE GALVANIZING.

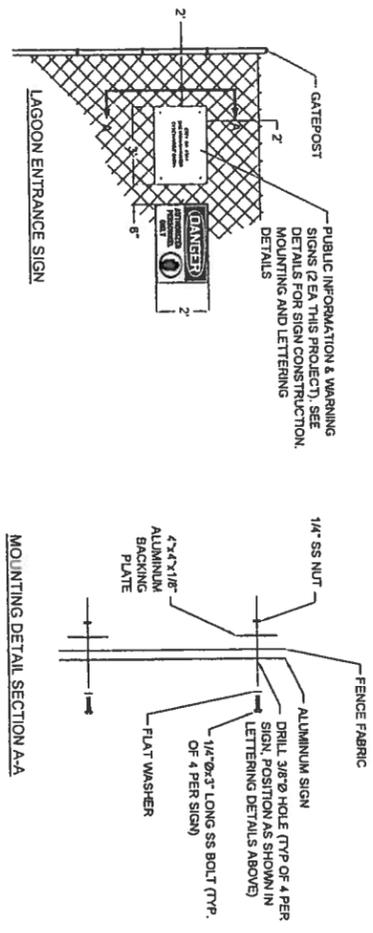

- SIGNS TO BE CONSTRUCTED AS FOLLOWS:**
- CLEAR, UV RESISTANT TOP PLY
 - BLACK BLOCK LETTERS AND LINE ART
 - WHITE REFLECTIVE BACKING
 - 1/8" ALUMINUM SHEETING

NOTE: ALL LETTERS SHALL BE BLACK AND LEGIBLE TO BE READ FROM A MINIMUM DISTANCE OF 30 FEET.

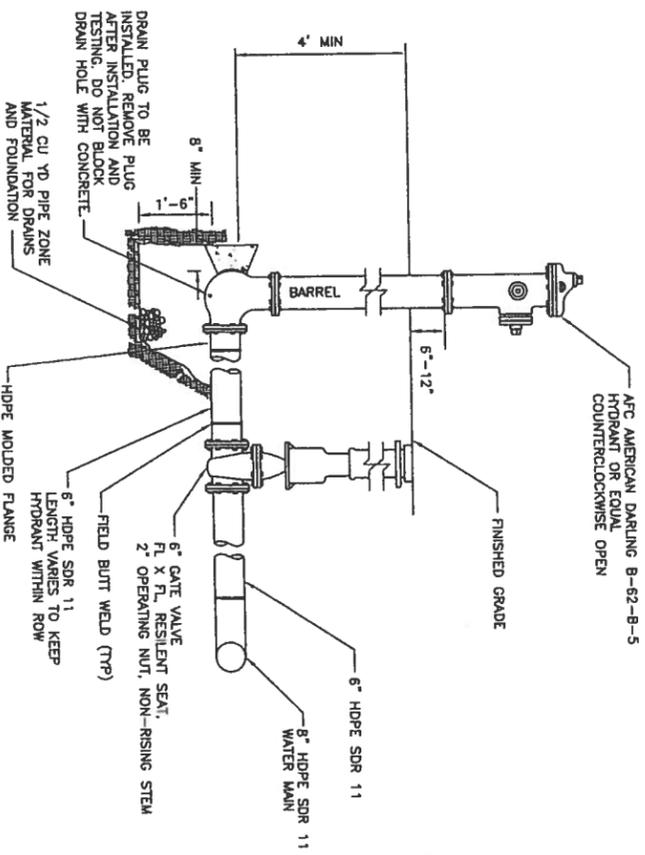


- NOTES:**
1. FIELD INSTALL HYDRANTS WHERE SHOWN ON PLANS.
 2. INSTALL BOLLARDS TO PROTECT HYDRANTS FROM DAMAGE. SEE C2.5.

4 FIRE HYDRANT DETAIL
C5.3 SCALE NTS


RECORD DRAWING
J-22-2013




Project No. _____ Date: MAY 2010 Designed: LAP Drawn: DDR Approved: LAP	REVISION BY DATE	 PO BOX 232846 ANCHORAGE, AK 99523 PR# 807-348-1010 FAX: 807-348-1015	2009 WATER SYSTEM UPGRADES FENCE DETAILS ATKA, ALASKA		CONSTRUCTION RECORD FIELD BOOK STAKING FOREMAN AS-BUILT INSPECTOR	SCALE: AS SHOWN DRAWING THICK LINE 1" = 10'-0" IF NOT ONE WORK ON THIS DRAWING, THE SCALE SHALL BE AS SHOWN.	RECORD DRAWING CERTIFICATE THESE DRAWINGS REFLECT RECORDED INFORMATION OBTAINED DURING CONSTRUCTION. INFORMATION PROVIDED HEREIN IS ACCURATE TO THE BEST OF MY KNOWLEDGE. NAME _____ DATE _____
	Sheet No. C5.3		Project No. _____ Date: MAY 2010 Designed: LAP Drawn: DDR Approved: LAP	PO BOX 232846 ANCHORAGE, AK 99523 PR# 807-348-1010 FAX: 807-348-1015	ATKA, ALASKA	CONSTRUCTION RECORD FIELD BOOK STAKING FOREMAN AS-BUILT INSPECTOR	SCALE: AS SHOWN DRAWING THICK LINE 1" = 10'-0" IF NOT ONE WORK ON THIS DRAWING, THE SCALE SHALL BE AS SHOWN.

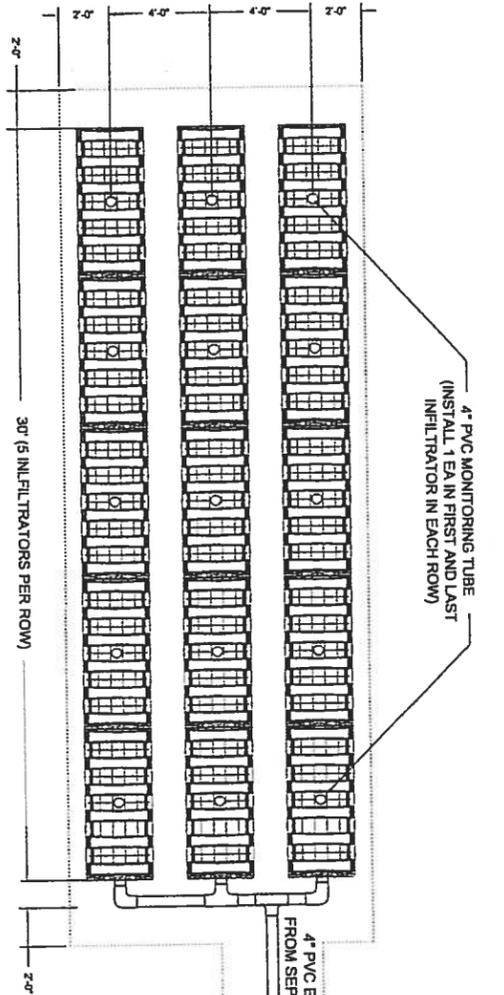


1 ABSORPTION BED PLAN
C5.4 SCALE NTS

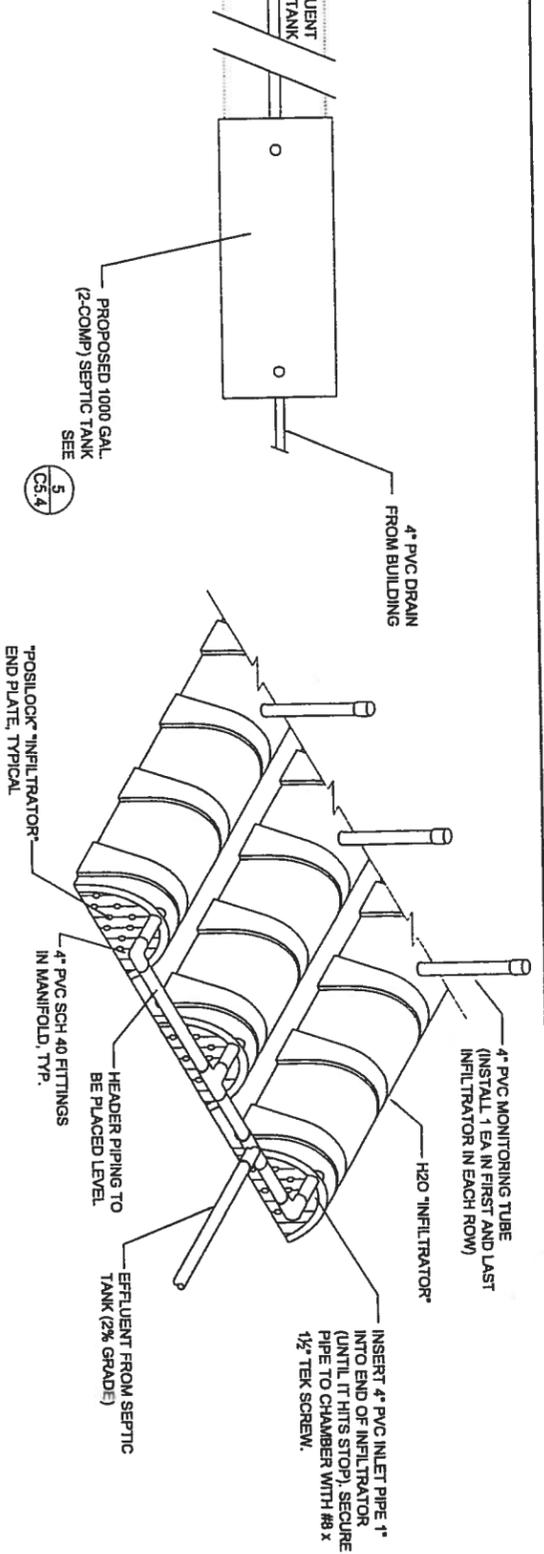

2 ABSORPTION BED MANIFOLD DETAIL (3 ROW)
C5.4 SCALE NTS

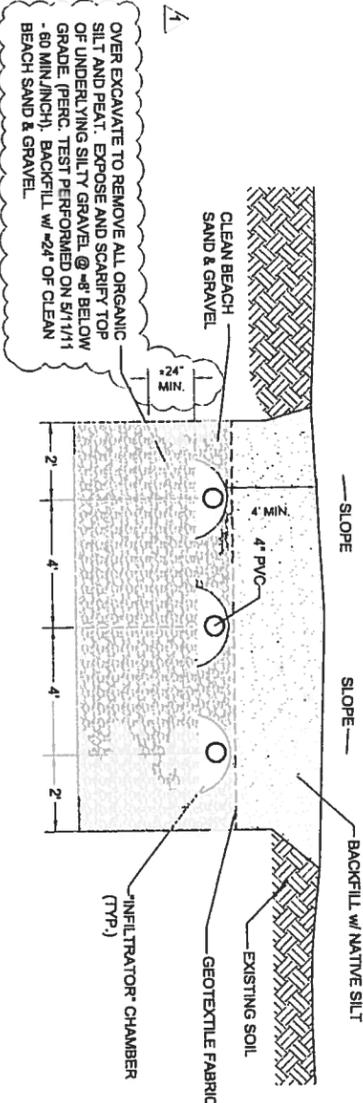


3 ABSORPTION FIELD CROSS SECTION
C5.4 SCALE NTS

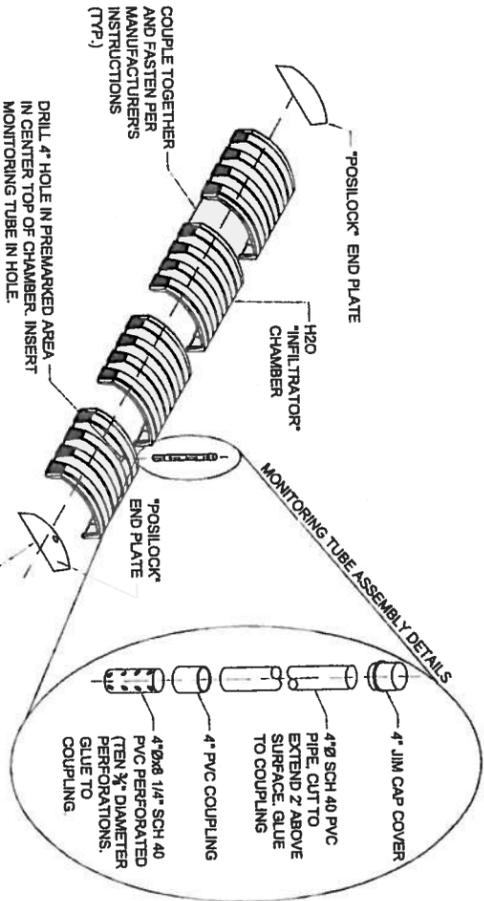

4 TYPICAL INFILTRATOR ASSEMBLY
C5.4 SCALE NTS

- NOTES:
1. STEEL 1000 GALLON - DOUBLE COMPARTMENT ANCHORAGE TANK & WELDING #AT1000S OR EQUAL.
 2. EXCAVATION TO BE 18'-24" LARGER THEN TANK ALL SIDES.
 3. INSTALL RISER EXTENSIONS BEFORE BACK FILLING.
 4. BACKFILL IN COMPACTED 8' LIFTS WITH SAND/ GRAVEL MATERIAL LESS THAN 1.5" DIA.
 5. SEPTIC TANK AND INFILTRATOR CHAMBERS SHALL BE SET AT A LEVEL GRADE.
 6. TANK BOTTOM SHALL BE SET ON INSTU. TILL OR COMPACTED SELECT PIT-RUN GRANULAR MATERIAL EXCAVATE ALL MUSKEG BENEATH TANK.

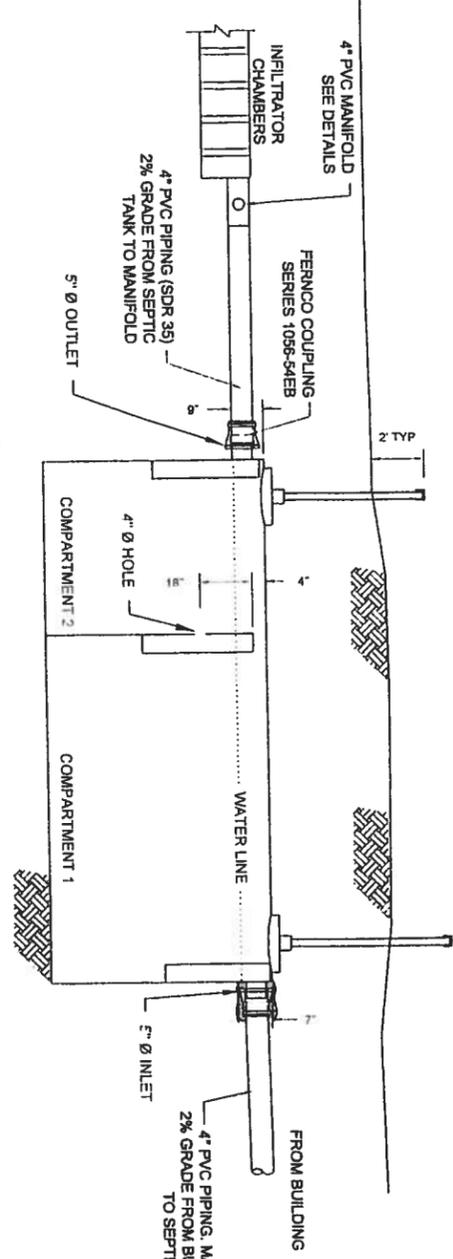

5 SEPTIC TANK DETAIL
C5.4 SCALE NTS

RECORD DRAWING
1-22-2012



CONSTRUCTION RECORD		SCALE:		RECORD DRAWING CERTIFICATE	
FIELD BOOK		AS SHOWN		THESE DRAWINGS REFLECT RECORDED INFORMATION OBTAINED DURING CONSTRUCTION. INFORMATION PROVIDED HEREIN IS ACCURATE TO THE BEST OF MY KNOWLEDGE.	
STAKING		1" = 10' ONE INCH ON ORIGINAL DRAWING		NAME	DATE
FOREMAN		1" = 40' ONE INCH ON THIS SHEET ADJUST SCALE ACCORDINGLY			
AS-BUILT					
INSPECTOR					


2009 WATER SYSTEM UPGRADES
ON-SITE WASTEWATER DISPOSAL
ATKA, ALASKA




REVISION	BY	DATE
1	CM	5/11

Project No.	
Date	MAY 2010
Design	LAP
Drawn	LAW
Approved	LAP
Sheet No.	C5.4


CODE ANALYSIS			
REFERENCED INTERNATIONAL BUILDING CODE		2006 EDITION (IBC 2006), AS ADOPTED BY THE STATE OF ALASKA	
OCCUPANCY CLASSIFICATION: GROUP B BUSINESS GROUP		(REF: IBC 2006, SEC. 304.1)	
TYPE OF CONSTRUCTION: TYPE V-B		(REF: IBC 2006, TABLE 601) (REF: IBC 2006, SEC. 602.5)	
HEIGHT AND NUMBER OF STORIES: ALLOWED AREAS		(REF: IBC 2006, TABLE 503)	
GROUP F-1: PROVIDED 10'-0" ALLOWED 40'-0"	1 STORY	8,500 S.F. / STORY	886 S.F. (REF: IBC 2006, TABLE 503) 8,500 S.F.
AREA MODIFICATIONS: FRONTAGE INCREASE	(NOT NEEDED)	0 S.F.	(REF: IBC 2006, SEC. 506.2)
AREA INCREASE	(NOT NEEDED)	0 S.F.	(REF: IBC 2006, SEC. 506.3) (REF: IBC 2006, SEC. 506.1)
BUILDING REQUIREMENTS	TYPE V-B (NOT SPRINKLERED)		(REF: IBC 2006, TABLE 601)
STRUCTURAL FRAME	OHR FIRE SEPERATION DISTANCE >10'-30 FT		(REF: IBC 2006, TABLES 601 & 602)
EXTERIOR BEARING WALLS	OHR FIRE SEPERATION DISTANCE >10'-30 FT		(REF: IBC 2006, TABLES 601 & 602)
INTERIOR BEARING WALLS	OHR FIRE SEPERATION DISTANCE >10'-30 FT		(REF: IBC 2006, TABLES 601 & 602)
INTERIOR NON-BEARING WALLS	OHR		
FLOOR CONSTRUCTION	OHR		
ROOF CONSTRUCTION	OHR		
EXTERIOR DOOR AND WINDOWS	UNPROTECTED = NO LIMIT		(REF: IBC 2006, TABLE 704.B)
CALCULATED OCCUPANT LOAD			(REF: IBC 2006, TABLE 1004.1.1)
GROUP F-1: 886 S.F. / (100 S.F. / OCCUPANT) = 9 OCCUPANTS MAXIMUM (INDUSTRIAL AREAS)			

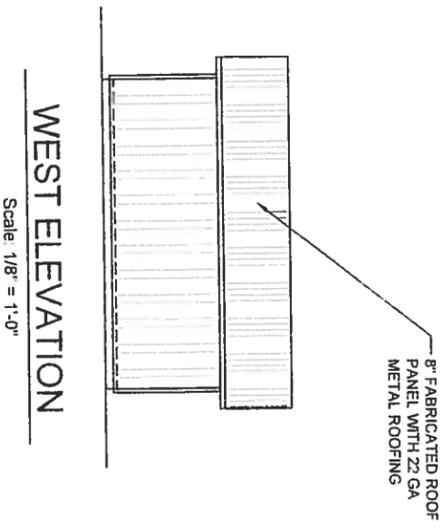


WEST ELEVATION
Scale: 1/8" = 1'-0"

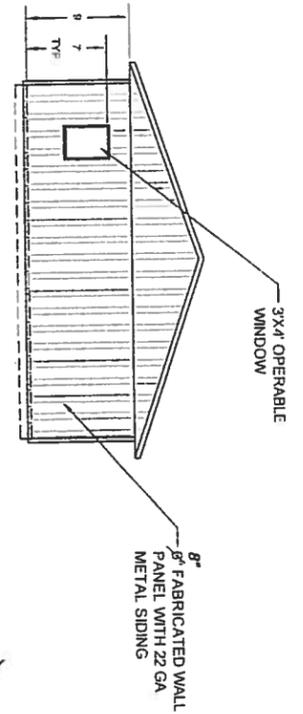

NORTH ELEVATION
Scale: 1/8" = 1'-0"

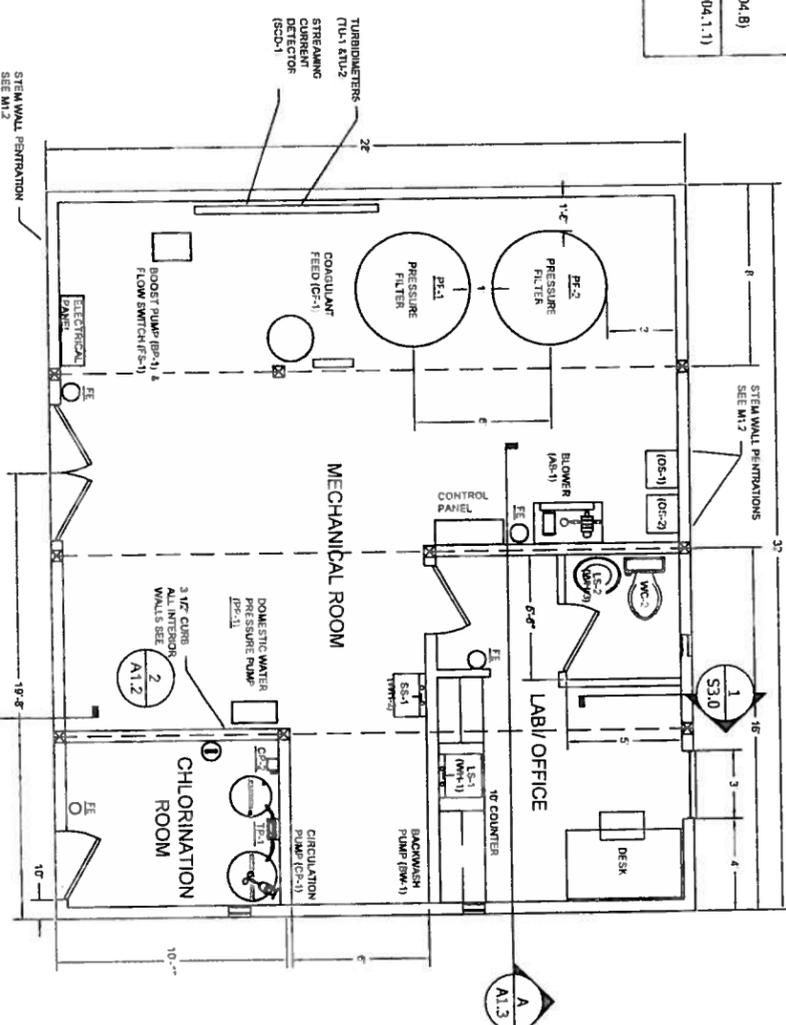

FLOOR PLAN
Scale: 1/4" = 1'-0"

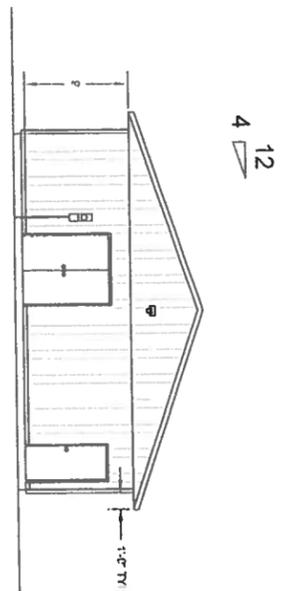

SOUTH ELEVATION
Scale: 1/8" = 1'-0"



EAST ELEVATION
Scale: 1/8" = 1'-0"

SHEET NOTES


1. THE SELECTED BUILDING PACKAGE MUST INCLUDE:
 - ENGINEERING CALCULATIONS SEALED BY A PROFESSIONAL ENGINEER REGISTERED IN THE STATE OF ALASKA, SHOWING THAT THE PROPOSED BUILDING PACKAGE IS IN COMPLIANCE WITH THE SPECIFIED DESIGN LOADS.
 - DETAILED ERECTION DRAWINGS AND PROCEDURES FOR ASSEMBLY OF THE COMPLETE BUILDING PACKAGE.
 - ALL REQUIRED FRAMING, ROOFING, TRIM METAL SIDING AND OTHER FLASHING FOR PENETRATIONS SHOWN.
 - 125% OF ALL FASTENERS REQUIRED TO ERECT THE STRUCTURE.
2. THE DIMENSIONS PROVIDED ARE APPROXIMATE. ROUGH OPENINGS, ALL WALL PANEL PENETRATIONS SHALL BE FIELD CUT UNLESS OTHERWISE SPECIFIED.
3. PROVIDE CURB BLOCKOUTS AT ALL DOOR LOCATIONS.
4. 3 1/2" RAISED CONCRETE CURB TO BE POURED AT ALL INTERIOR WALLS.
5. THE INTERIOR OF THE BUILDING MUST BE SEPARATED FROM THE FOAM INSULATION PANELS BY AN APPROVED THERMAL BARRIER OF 1/2" GYPSUM WALL BOARD.

FE
WALL MOUNTED
2A20 B.C. PORTABLE FIRE EXTINGUISHER
TOP OF EXTINGUISHER SHALL BE 4" ABOVE FLOOR

RECORD DRAWING
1-22-2013



CONSTRUCTION RECORD		RECORD DRAWING CERTIFICATE	
FIELD BOOK	STAKING	THESE DRAWINGS REFLECT RECORDED INFORMATION OBTAINED DURING CONSTRUCTION. INFORMATION PROVIDED HEREIN IS ACCURATE TO THE BEST OF MY KNOWLEDGE.	
FOREMAN	AS-BUILT	NAME	DATE
INSPECTOR			

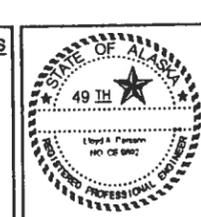

2009 WATER SYSTEM UPGRADES
WTP ELEVATIONS & FLOOR PLAN
ATKA, ALASKA



REVISION	BY	DATE

Project No.	
Date	MAY 2010
Designer	LAP
Drawn	LAW
Approved	LAP
Sheet No.	A1.1

ROOM FINISH SCHEDULE

ALL COLOR FINISHES TO BE SELECTED BY OWNER

ROOM NUMBER	INTERIOR	EXTERIOR	CEILING	FLOOR	CEILING HEIGHT AFF
R-101	1/2" CDX & FRP PANELS	1/2" GWB & FRP PANELS	12" GWB PAINTED	SEALED CONCRETE	8'-0" MAX
R-102	1/2" CDX & FRP PANELS	1/2" GWB & FRP PANELS	12" GWB PAINTED	SEALED CONCRETE	12'-1" MAX
R-103	1/2" CDX & FRP PANELS	1/2" GWB & FRP PANELS	12" GWB PAINTED	SEALED CONCRETE	14' 9" MAX
R-104	1/2" CDX & FRP PANELS	1/2" GWB & FRP PANELS	12" GWB PAINTED	SEALED CONCRETE	8'-0"

DOOR SCHEDULE

NUMBER	SIZE		THK	LABEL	TYPE	MATL	FINISH	HIDV ANSI FUNCTION	REMARKS
	WIDTH	HEIGHT							
R-101	3'-0"	7'-0"	1 3/4"		F	HM	PAINTED		WITH AUTO CLOSER
R-102	3'-0"	7'-0"	1 3/4"		F	HM	PAINTED		WITH AUTO CLOSER
R-103	6'-0"	7'-0"			RO	HM	FACTORY FINISH		WITH AUTO CLOSER
R-104	3'-0"	7'-0"	1 3/4"		F	HM	PAINTED		WITH AUTO CLOSER


NOTES

- ALL DOORS SHALL BE CURRIES 7075 SERIES, PRIMED AND PREPARED FOR HARDWARE AS SPECIFIED.
- ALDOOR FRAMES AND HARDWARE ARE TO BE TREATED AS COMPLETE ASSEMBLIES.
- DOORS SHALL BE BEST SERIES OR WITH BEST STYLE AT KEYS STAMPED WITH APPROPRIATE CODE KEY.
- CLOSERS SHALL BE LNU CLOSERS MOD 4013 WITH ALUMINUM FINISH.
- HINGES SHALL BE STANLEY FB9 LINE BALL BEARING HINGES.


WINDOW SCHEDULE

NUMBER	SIZE		REMARKS	SPECIFICATION
	WIDTH	HEIGHT		
(W1)	3'-0"	4'-0"	TOP OF WINDOW 7'-0" ABOVE TOC SLAB	CAPROL GLASS, NORTHERN TRIPLE PANE LOWE, CASEMENT, OR EQUAL


ROOM AND DOOR SCHEDULE

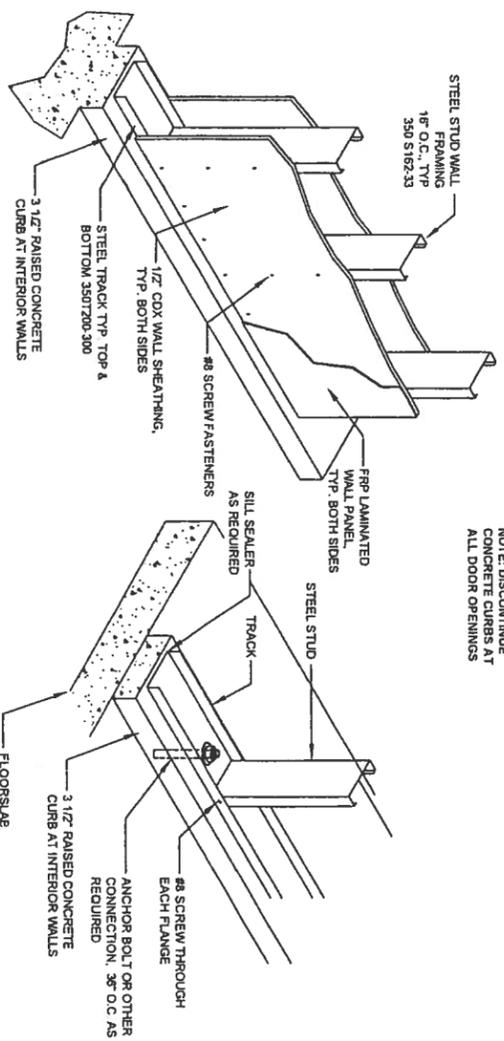

2 INTERIOR WALL DETAILS
SCALE: N.T.S.

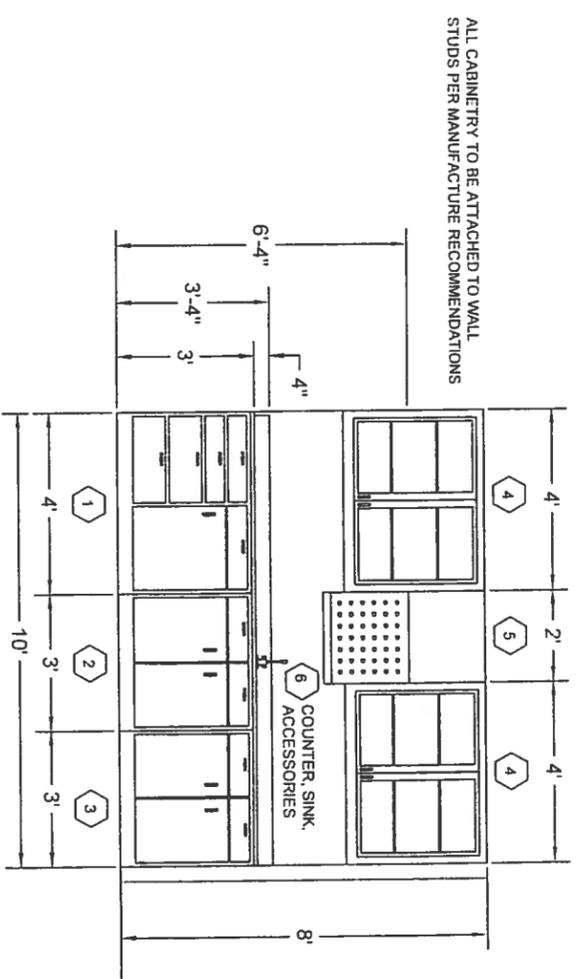

2 CABINET ELEVATION
SCALE: 1" = 1'-0"

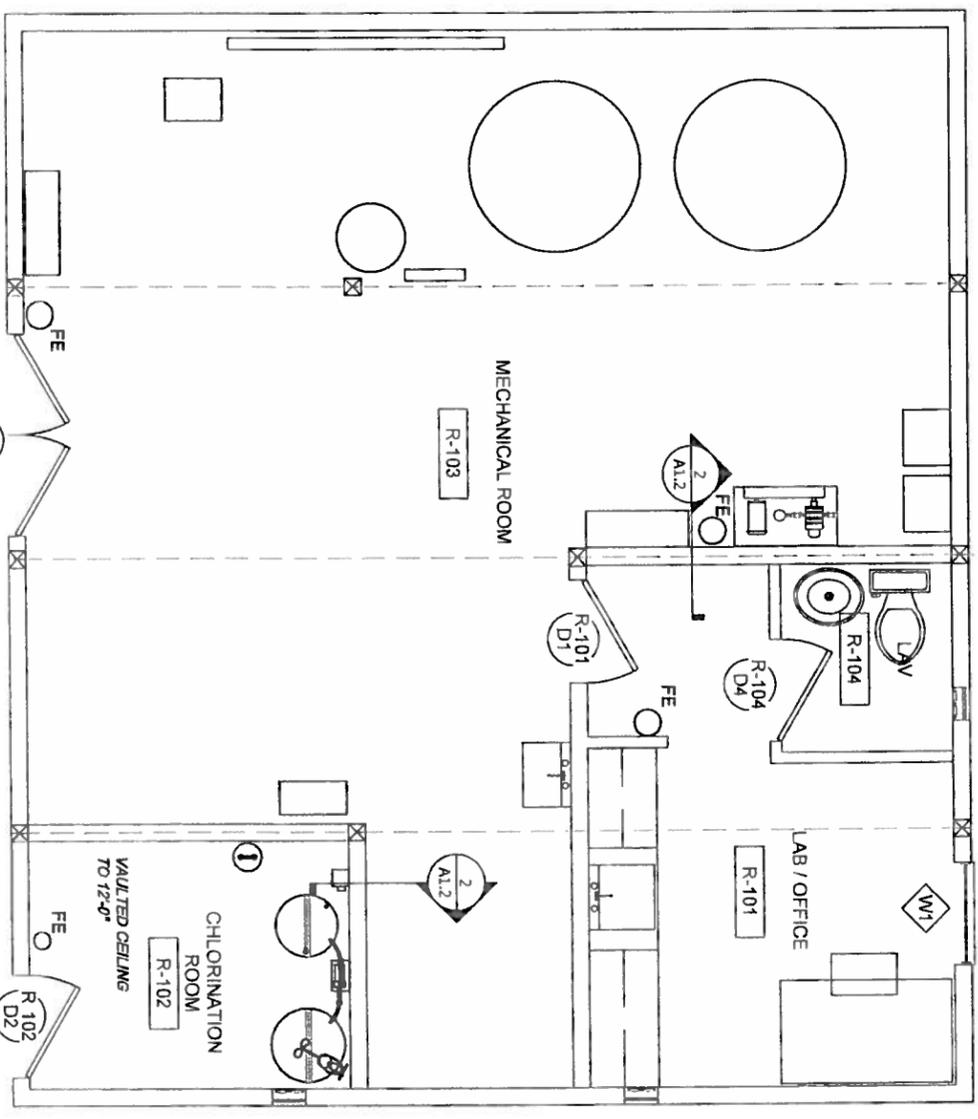

1 ROOM AND DOOR PLAN
SCALE: 3/8" = 1'-0"

ATKA WTP LABORATORY CASEMENT SCHEDULE

- 2) 4 1/2" HIGH DRAWERS SIDE BY SIDE ABOVE 1 DRAWER 4 1/2" HIGH ABOVE 2 DRAWERS, 7 1/2" RH CUPBOARD 35 1/2" x 48" HINGED CUPBOARD 35 1/2" x 48"
- SINK SOLID HINGED DOUBLE DOOR 35 1/2" x 48"
- #11558320 SINK CABINET LHM HINGED CUPBOARD 35 1/2" x 36"
- 2) 4 1/2" DRAWERS ABOVE CUPBOARD DOORS 35 1/2" x 36"
- #24858320 STORAGE CABINET 2 UPPER DRAWERS, LHM HINGED CUPBOARDS 35 1/2" x 36"
- 2) FRAMED GLASS SWINGING DOOR W/2 SHELVES EACH 31" TALL x 16" DEEP x 48" WIDE
- #72883800 WALL MOUNT CABINETS X2, LHM FRAMED GLASS DOORS 31" X 16" D/48" W
- PEG BOARD WITH DRIP THROUGH 22 1/2" x 24"
- #52137800 BLACK PEG BOARD 22 1/2" x 24" W/THROUGH
- COUNTER, SINK, ACCESSORIES
- #52137800 BLACK PEG BOARD 22 1/2" x 24" W/THROUGH
- #52137800 BLACK PEG BOARD 22 1/2" x 24" W/THROUGH
- #20144800 BLACK EPOXY RESIN SINGLE COMPARTMENT SINK, 16" X 24"
- #20144800 BLACK EPOXY RESIN COUNTERTOP, CONFIGURATION "B", BUTT CUT, STANDARD EDGE, 10" X 36"
- #20131910 16" X 24" SINK CUTOUT
- #20131900 FIXTURE CUTOUT FOR FAUCET (#20122300)
- #20131900 SINK OUTLET W/ASKET, 4 1/2" OVERALL DIAMETER, 1 1/2" OUTLET
- #31304800 WALL CASE MOUNTING BRACKET, 48" LONG, 2 FOR BOTH CASES 3 DRAWN SIDES OF EPOXY RESIN FOR THE EXTRA EPOXY RESIN ADHESIVE FOR FIELD APPLICATION OF END SPLASHES.


NOTES

- BOX TEXT CONTAINS TAKEOFFS USING FISCHER CABINET NUMBERS
- BLANK OF BLACK EPOXY RESIN FOR FIELD FABRICATION OF END SPLASHES

RECORD DRAWING
1-22-2013



<p>Project No. _____ Date: MAY 2010 Designed: LAP Drawn: DDR Approved: LAP</p>	<table border="1"> <thead> <tr> <th>REVISION</th> <th>BY</th> <th>DATE</th> </tr> </thead> <tbody> <tr> <td>ROOM FINISH SCHEDULE, NOTE FIRE HYDRANTS AND WARNING SIGNS</td> <td>LAW</td> <td>4/11</td> </tr> </tbody> </table>	REVISION	BY	DATE	ROOM FINISH SCHEDULE, NOTE FIRE HYDRANTS AND WARNING SIGNS	LAW	4/11	 CE2 ENGINEERS, INC. PO BOX 222948 ANCHORAGE, AK 99521 PH: 907-349-1910 FAX: 907-349-1015	2009 WATER SYSTEM UPGRADES ROOM SCHEDULES ATKA, ALASKA		<p>CONSTRUCTION RECORD</p> <table border="1"> <tr><td>FIELD BOOK</td></tr> <tr><td>STAKING</td></tr> <tr><td>FOREMAN</td></tr> <tr><td>AS-BUILT</td></tr> <tr><td>INSPECTOR</td></tr> </table>	FIELD BOOK	STAKING	FOREMAN	AS-BUILT	INSPECTOR	<p>SCALE:</p> <p>BAR IS ONE INCH ON ORIGINAL DRAWING</p> <p>IF NOT ONE INCH ON THIS SHEET, SCALE IS ACCORDINGLY</p>	<p>RECORD DRAWING CERTIFICATE</p> <p>THESE DRAWINGS REFLECT RECORDED INFORMATION OBTAINED DURING CONSTRUCTION. INFORMATION PROVIDED HEREIN IS ACCURATE TO THE BEST OF MY KNOWLEDGE.</p> <p>NAME _____ DATE _____</p>
REVISION	BY	DATE																
ROOM FINISH SCHEDULE, NOTE FIRE HYDRANTS AND WARNING SIGNS	LAW	4/11																
FIELD BOOK																		
STAKING																		
FOREMAN																		
AS-BUILT																		
INSPECTOR																		

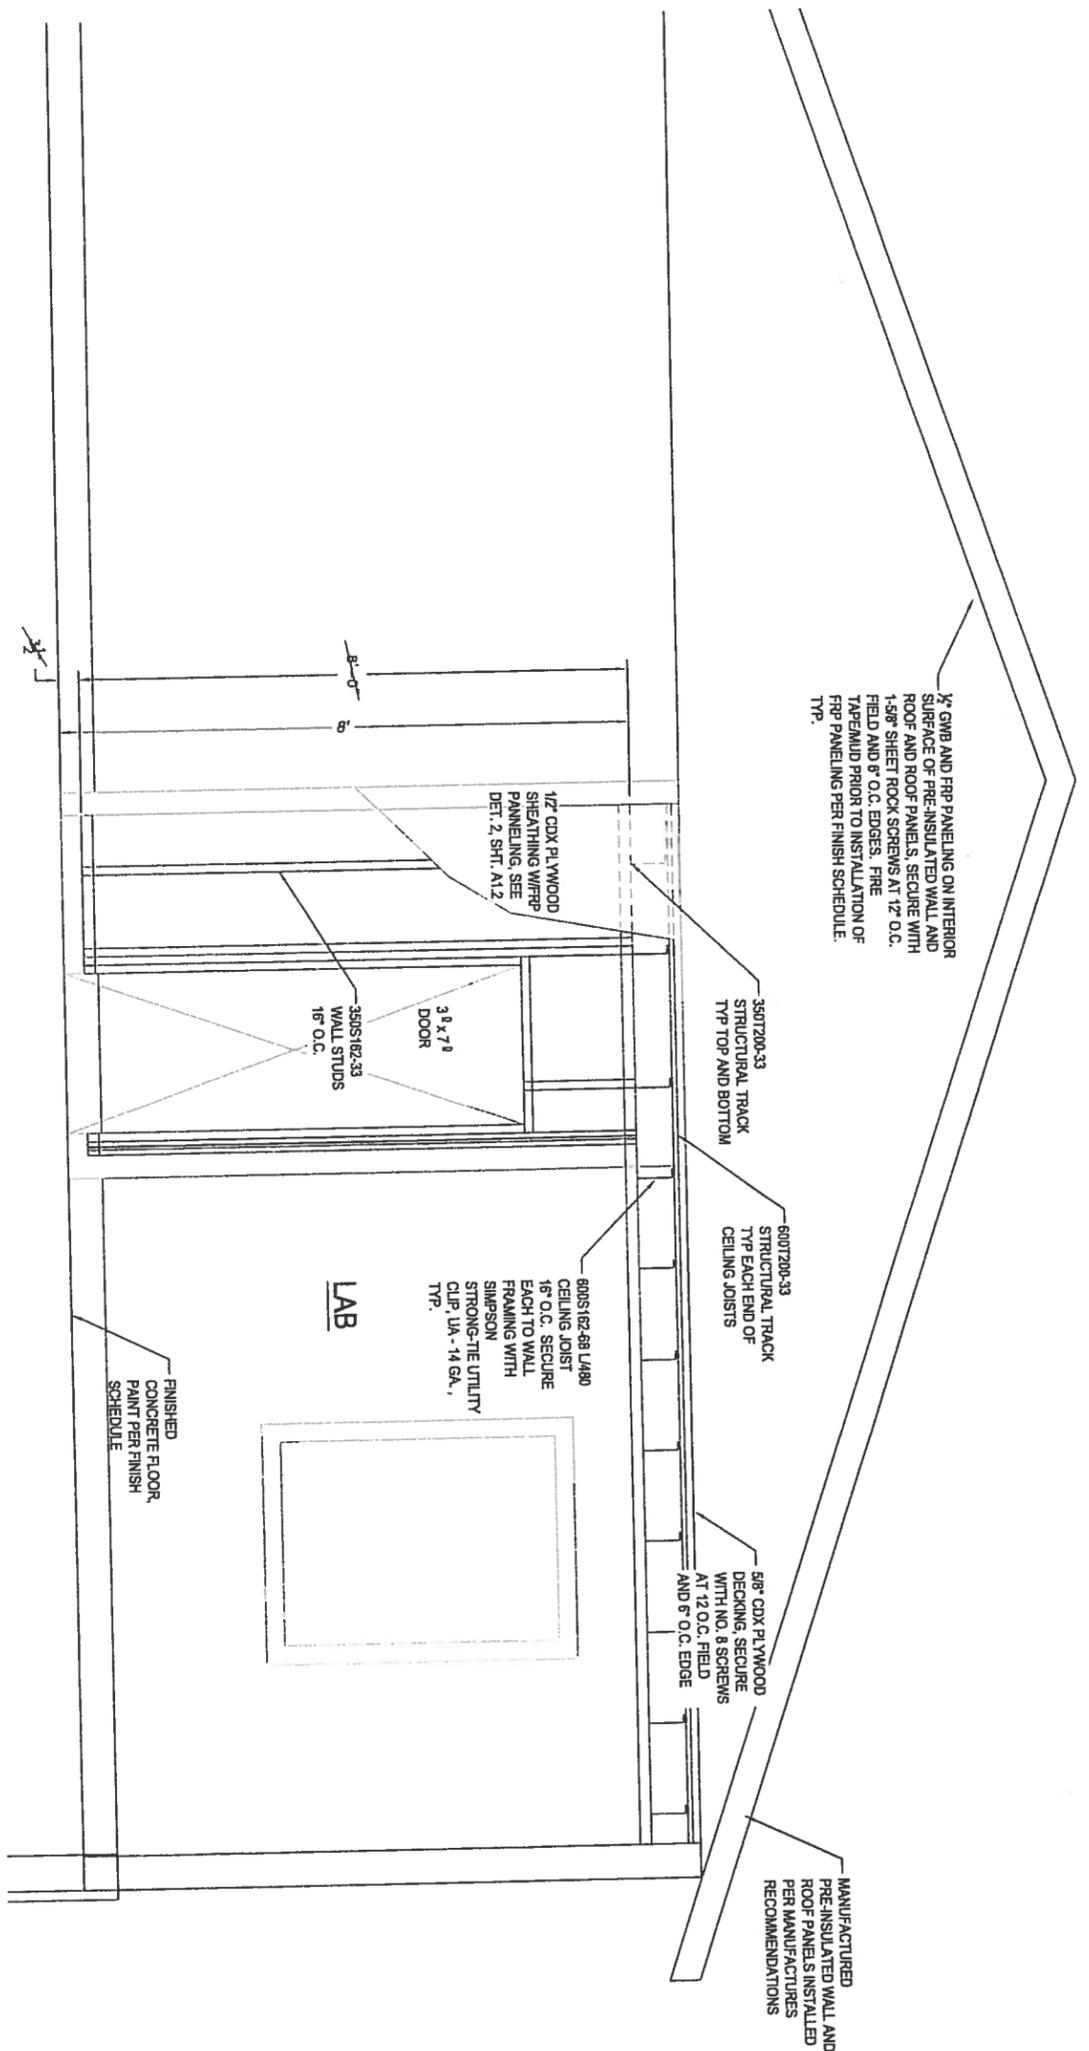

A LABORATORY AND RESTROOM CEILING FRAMING DETAIL
 A1.3 SCALE 3/4\"/>

1 CHLORINATION ROOM WARNING SIGNS
 A1.3 SCALE 3/4\"/>



INSTALL WARNING SIGNS ON DOOR INTO CHLORINATION ROOM. PLACE SIGNS AT EYE LEVEL ON OUTSIDE OF DOOR.



RECORD DRAWING
 1-22-2013

Project No.	
Date	MAY 2010
Designed	LAPCW
Drawn	LAW
Approved	LAPCW
Sheet No.	A1.3


REVISION	BY	DATE

CE₂
ENGINEERS, INC.
 PO BOX 22298 ANCHORAGE, AK 99523 PH: 807-349-1810 FAX: 807-349-1015

2009 WATER SYSTEM UPGRADES

LABORATORY AND RESTROOM CEILING DETAIL

ATKA, ALASKA

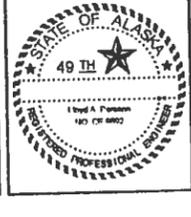

CONSTRUCTION RECORD
FIELD BOOK
STAKING
FOREMAIL
AS BUILT
INSPECTOR

SCALE:	AS SHOWN
1" = 1'-0"	

RECORD DRAWING CERTIFICATE	
THESE DRAWINGS REFLECT RECORDED INFORMATION OBTAINED DURING CONSTRUCTION. INFORMATION PROVIDED HEREIN IS ACCURATE TO THE BEST OF MY KNOWLEDGE	
NAME	DATE

GENERAL STRUCTURAL NOTES

THE FOLLOWING NOTES APPLY TO BUILDING CONSTRUCTION:

CODE 2006 INTERNATIONAL BUILDING CODE (IBC) UNLESS NOTED OTHERWISE

1. LOADS
GROUND SNOW LOAD = 30 PSF
FLAT ROOF SNOW, P_f = 30 PSF
SNOW LOAD IMPORTANCE FACTOR, I = 1.1
THERMAL FACTOR, C_t = 1.0
WIND = 150 MPH, EXPOSURE D
IMPORTANCE FACTOR: I = 1.15, BUILDING CATEGORY III
SEISMIC DESIGN CATEGORY III
S_s = 1.75 SITE CLASS D S₁ = 0.75
I = 1.25 S_{Ds} = 1.17
2. CONTRACTOR TO INSPECT THE EXISTING SITE PRIOR TO BIDDING. ALL DEFICIENCIES FROM CONTRACT INFORMATION THAT ARE EXPOSED TO VIEW ARE ASSUMED ACCEPTABLE AT THE TIME OF THE BID.
3. ALL DIMENSIONS MUST BE VERIFIED BY THE CONTRACTOR PRIOR TO START OF ANY WORK.
4. GENERAL CONTRACTOR SHALL BE RESPONSIBLE FOR COORDINATING ALL WORK BETWEEN SOILS TESTING LAB AND FOUNDATION CONTRACTOR.
5. FOUNDATION ALLOWABLE SOIL PRESSURE IS 3000 PSF. SEE GEOTECHNICAL REPORT FROM BY DIANNE MILLER ASSOCIATES LLC, DATED NOVEMBER 30, 2009.
THE ORGANIC SOILS, PEAT AND ORGANIC SILT SHOULD BE REMOVED FROM THE BUILDING AREA AND BE REPLACED WITH PROPERLY COMPACTED, INORGANIC FILL MATERIAL. THE REMOVAL OF WEAK SOILS SHOULD EXTEND HORIZONTALLY AT LEAST FIVE FEET BEYOND PERIMETER OF THE BUILDING. THE BOTTOM OF THE OVER-EXCAVATION SHOULD EXPOSE THE SILT WITH ROCK FRAGMENT. THE DEPTH OF EXCAVATION SHOULD BE AT LEAST FIVE FEET. THE BOTTOM OF THE EXCAVATION SHOULD BE PROOF-ROLLED AND IF SOFT SPOTS ARE FOUND, THE EXCAVATION SHOULD BE DEEPENED.
THE MATERIAL USED TO BACKFILL THE EXCAVATION SHOULD BE A MIXTURE OF SAND AND GRAVEL. THE MATERIAL SHOULD BE PLACED IN THIN LIFTS, AND EACH LIFT SHOULD BE COMPACTED TO AT LEAST 95% OF THE MAXIMUM DENSITY OF THE MATERIAL AS DETERMINED BY THE ASTM D1557 TEST PROCEDURE.
6. CONCRETE
f_c = 4000 PSI FOR FOOTINGS, SLABS AND FOUNDATION WALLS.
ULTIMATE STRENGTH DESIGN METHOD USED. MIXING AND PLACING OF ALL CONCRETE AND SELECTION OF MATERIALS SHALL BE IN ACCORDANCE WITH THE IBC AND ACI CODE 318-02.
MINIMUM MIX DESIGN FOR AIR-ENTRAINED CONCRETE
SLUMP = 3-IN. TO 4-IN.
WATER CEMENT RATIO = 0.50
MAXIMUM SIZE OF AGGREGATE = 1 1/2"
AIR CONTENT = 5% ± 1%
WATER = 265 LB. PER CU. YD. OF CONCRETE
CEMENT = 530 LB. PER CU. YD. OF CONCRETE
FINE SAND, FINENESS MODULUS = 2.50
FINE AGGREGATE:
= 32% OF TOTAL AGGREGATE
= 980 LB. PER CU. YD. OF CONCRETE
COARSE AGGREGATE = 2110 LB. PER CU. YD. OF CONCRETE.
PROVIDE 1/2" CHAMFER TO ALL EXPOSED CONCRETE EDGES.
KEYED CONSTRUCTION JOINTS SHALL BE USED IN ALL CASES. ALL CONSTRUCTION JOINTS SHALL BE THOROUGHLY CLEANED AND ALL LANTAGE SHALL BE REMOVED. ALL VERTICAL JOINTS SHALL BE THOROUGHLY WETTED AND SLUSHED WITH A COAT OF HEAT CEMENT. USE DOWNED EXPANSION/CONTROL JOINTS PER TYPICAL DETAILS.
ANCHOR BOLTS, DOWELS AND OTHER EMBEDDED ITEMS SHALL BE SECURELY TIED IN PLACE BEFORE CONCRETE IS POURED.
NO HEATING SHALL BE ALLOWED FOR BENDING OF REINFORCING STEEL UNLESS APPROVED BY ENGINEER.
7. FIELD GROUTING
GROUT IS TO BE NON-METALLIC MASTER BUILDERS MASTERFLOW 713 NON-SHRINK GROUT OR ENGINEER APPROVED EQUAL. f_c = 6,000 PSI UNLESS APPROVED BY ENGINEER.
8. REINFORCING STEEL
ALL CONCRETE REINFORCING STEEL SHALL BE EPOXY COATED BARS A775 GRADE 60 (f_y = 60,000 PSI), EXCEPT ALL #4 SLAB REINFORCEMENT AND DOWELS SHALL BE GRADE 40 (f_y = 40,000 PSI). LAP CONTINUOUS REINFORCING BARS 40 BAR DIAMETERS 24" MIN. UNLESS INDICATED OTHERWISE. CORNER BARS (24" BEND) WILL BE PROVIDED FOR ALL HORIZONTAL REINFORCEMENT. LAPS SHALL BE WELL STAGGERED. DETAIL STEEL IN ACCORDANCE WITH A31 MANUAL OF STANDARD PRACTICE OF DETAILING CONCRETE STRUCTURES.
WELDED WIRE FABRIC (WWF) TO CONFORM WITH ASTM A185. REINFORCING HOOKS TO COMPLY WITH A31 STANDARD MINIMUM COVER BOTTOM OF FOOTINGS.....
FORMED SURFACES---EXPOSED TO WEATHER, EARTH OR CORROSIVE ENVIRONMENT

9. LUMBER
PROVIDE LAMINATED WOOD BEAMS AS SHOWN ON PLANS AND DETAILS.
DOUG-FIR #2 MEMBERS (P-T. POSTS) SHALL HAVE THE FOLLOWING ALLOWABLE STRESSES:
F_b = 900 psi - BENDING
F_v = 180 psi - SHEAR
F_c = 1350 psi - COMPRESSION PARALLEL TO GRAIN
F_c = 625 psi - COMPRESSION PERPENDICULAR TO GRAIN
E = 1600 ksi - MODULUS OF ELASTICITY
GULAM BEAMS (OF 24F-E13) SHALL HAVE THE FOLLOWING ALLOWABLE STRESSES:
F_b = 2400 psi - BENDING
F_v = 240 psi - SHEAR
F_c = 1700 psi - COMPRESSION PARALLEL TO GRAIN
F_c = 650 psi - COMPRESSION PERPENDICULAR TO GRAIN
E = 1800 ksi - MODULUS OF ELASTICITY
GENERAL CONTRACTOR SHALL COORDINATE AND INSURE THAT MATERIALS NEEDED TO CONNECT FABRICATIONS TO SUBSTRATE ARE FURNISHED.
USE KILN DRIED GRADED LUMBER STORED IN A CONTINUOUS COVERED CONDITION. PRESSURE TREATED WOOD MUST BE USED WHEN IN CONTACT W/ CONCRETE OR WHEN EXPOSED TO WEATHER. USE SIMPSON STRONGTIE CONNECTORS OR EQUIVALENT. USE GALVANIZED FASTENERS AS PER MANUFACTURER'S RECOMMENDATIONS.
WOOD AND TIMBER CONSTRUCTION SHALL CONFORM TO PROJECT SPECIFICATIONS AND AMERICAN INSTITUTE OF WOOD CONSTRUCTION (AIWC) STANDARDS
WOOD CONSTRUCTION SHALL CONFORM TO CHAPTER 23 OF THE INTERNATIONAL BUILDING CODE (UNLESS OTHERWISE NOTED). ALL NAILING SHALL CONFORM TO TABLE FOR "NAILING SCHEDULE" OF THE INTERNATIONAL BUILDING CODE UNLESS OTHER REQUIREMENTS NOTED ON THE PLAN ARE MORE STRICT. HOLES IN SAWN LUMBER SHALL BE AS SPECIFIED IN THE INTERNATIONAL BUILDING CODE.
FRAMING LUMBER SHALL CONFORM WITH THE PROVISIONS OF THE AMERICAN SOFTWOOD LUMBER STANDARD PS-20-70 AND EACH PIECE SHALL BEAR THE GRADE STAMP OF A GRADING AGENCY APPROVED BY THE AMERICAN LUMBER STANDARDS COMMITTEE. ALL FRAMING LUMBER 2" AND LESS IN THICKNESS SHALL BE SEASONED TO A MOISTURE CONTENT OF 19% OR LESS PRIOR TO SURFACING WITH THE INDICATION "S-DRY" ON THE GRADE STAMP.
DIMENSION LUMBER SHALL BE NUMBER 2 HF UNLESS INDICATED OTHERWISE ON THE PLANS.
ROOF BEAMS AND GIRDERS SHALL HAVE FULL HORIZONTAL BEARING OF THE MEMBER OVER SUPPORT UNLESS OTHERWISE SHOWN, DO NOT OVERCUT.
NO NOTCHING OF STUDS, RATTERS, OR BEAMS IS PERMITTED WITHOUT THE ENGINEER'S APPROVAL. HOLES BORED IN THE STUD OR RATTERS SHALL BE IN THE MIDDLE ONE-THIRD OF THE DEPTH AND THE DIAMETER OF ANY SUCH HOLE SHALL NOT EXCEED ONE-FOURTH THE DEPTH.
THE CONTRACTOR SHALL PROVIDE TEMPORARY DIAGONAL LATERAL AND CROSS BRACING UNTIL ROOF SHEATHING, CEILING AND PERMANENT BRACING CAN BE APPLIED AND SHEAR WALLS COMPLETED.
10. SPECIAL CONDITIONS
CONTRACTOR SHALL VERIFY ALL DIMENSIONS IN FIELD AND SHALL PROVIDE ADEQUATE SHORING AND BRACING OF ALL STRUCTURAL MEMBERS DURING CONSTRUCTION IN ACCORDANCE WITH ALL NATIONAL, STATE AND LOCAL SAFETY ORDINANCE. ANY DEVIATION MUST BE SHALL NOTIFY ENGINEER OF ALL FIELD CHANGES PRIOR TO INSTALLATION.
11. INSPECTION, TESTING, AND OBSERVATION
SPECIAL INSPECTION AND TESTING REQUIRED PER IBC CHAPTER 17 AND BY AN INDEPENDENT TESTING LAB OR QUALIFIED LICENSED ENGINEER FOR THE FOLLOWING:
FOUNDATIONS: REINFORCEMENT VERIFY THAT ALL REINFORCING IS PLACED IN ACCORDANCE WITH APPROVED PLANS. CHECK FOR REQUIRED COVER, SIZE AND GRADE.
ANCHOR BOLTS LOCATION, EMBEDMENT, SIZE, TYPE.
CONCRETE: REINFORCEMENT PLACEMENT PRIOR TO CONCRETE DELIVERY. DURING TAKING OF SPECIMENS: PRIOR TO GROUTING, STRESSED SKIN PANEL ANCHORS AND THE DOWN ANCHORS AND HOLDOWN INSTALLATION. INSPECT DIAMETER, EMBEDMENT, LOCATION, NUT/PLATE ON EMBEDDED END.
WOOD LATERAL SYSTEM: PRIOR TO COVER. ROOF NAILING, TOP PLATE STRESSED SKIN PANEL NAILING, BOTTOM PLATE NAILING, TOP PLATE CONNECTIONS, ANCHOR BOLTS SPACING, WASHERS, STRAPS & TEDDOW ANCHORS, SILL PLATES, FRAMING @ ABUTTING PANEL EDGES WHERE REQUIRED IN PANELS.

12. ROOF AND WALL PANELS SHALL BE STRESSED-SKIN PANELS AS APPROVED BY THE MANUFACTURER. PANEL MANUFACTURER MUST BE IN BUSINESS FOR AT LEAST 5 YEARS.
MANUFACTURER MUST PROVIDE AN ISO9000 EVALUATION REPORT FOR THE PANELS THAT INCLUDES ALLOWABLE LOADS AND STRESSES, FIRE RATING, INSULATING VALUES, ETC.
MANUFACTURER MUST PROVIDE STRUCTURAL CALCULATIONS STAMPED BY AN ENGINEER REGISTERED IN THE STATE OF ALASKA. PROVIDE CALCULATIONS AND SHOP DRAWINGS TO ENGINEER OF RECORD FOR REVIEW.
STRESSED SKIN PANELS MUST BE FACTORY-ASSEMBLED PANELS CONSISTING OF PRESSURE-TREATED PLYWOOD FACINGS AND A FOAMED-IN-PLACE EXPANDED POLYURETHANE CORE OR APPROVED EQUAL. PANELS MUST BE INSPECTED PER ISO REQUIREMENTS.
MATERIALS:
CORE: POLYURETHANE FOAM PLASTIC CORE MATERIAL PER ISO REPORT. FOAM PLASTIC MUST HAVE A MAXIMUM FLAME-SPREAD RATING AND SMOKE-DEVELOPED RATING IN ACCORDANCE W/ IBC STANDARDS.
MINIMUM R-VALUES: 6" PANELS = R44, 8" PANELS = R60
INSTALLATION PER MANUFACTURER AND ISO REQUIREMENTS:
THE PANELS ARE FIELD-JOINED TOGETHER TO FORM A SOLID WALL OR ROOF BY BEAMS OF THE TONGUE-AND-GROOVE LONGITUDINAL PANEL-EDGE SYSTEM, WHICH ALLOWS EACH PANEL TO BE POSITIVELY ATTACHED INTO THE ADJACENT PANEL THROUGH ATTACHMENT OF THE FRAMING MATERIAL OF EACH ADJOINING PANEL TO THE FRAMING MEMBERS EMBEDDED IN THE FOAM CORE. ALL FASTENERS MUST HAVE SUFFICIENT LENGTH TO PENETRATE AT LEAST 1" INTO THE MAIN MEMBER.
FIELD-INSTALLED TOP AND BOTTOM PLATES ARE DIMENSIONAL LUMBER, SIZED TO MATCH THE CORE THICKNESS AND FASTENED TO THE PANEL FACING USING THE MINIMUM SIZE FASTENERS AND SPACING SPECIFIED A COMPATIBLE GULF OR PANEL ADHESIVE IS APPLIED ALONG BUTTING POLYURETHANE FOAM CORE SURFACES AND ANY DIMENSIONAL LUMBER SURFACES, AND ALONG THE BOTTOM OF THE PANEL BASE PLATE BEFORE PANEL PLACEMENT.
OPENINGS: OPENINGS MUST CONSIST OF LUMBER HEADERS AND ASSOCIATED FRAMING DESIGNED BY MANUFACTURER'S ENGINEER IN ACCORDANCE WITH THE IBC.
BUILDING INSULATION AND VENTILATION MUST BE PROVIDED BY THE BUILDING SHELL MANUFACTURER IN ACCORDANCE WITH IBC AND LOCAL BUILDING CODES.
SEE ARCHITECTURAL DRAWINGS FOR INTERIOR AND EXTERIOR FINISHES AND ROOFING.
FASTENERS: USE GALVANIZED FASTENERS AS PER MANUFACTURER'S RECOMMENDATIONS OR PER ISO EVALUATION REPORT.

HOLDOWN SCHEDULE		
SIZE	POST/CHORD	MIN. EMBEDMENT INTO CONC.
	ANCHOR D.I.A.	

SEE "ATKA BUILDING PAK DRAWINGS" BY BIG SKY INSULATIONS, INC., BELGRADE, MONTANA, PROJECT NO. 314173.

ABBREVIATIONS:

- AT PLATE
- F FEET
- EA INCHES EACH
- OC ON CENTER
- TYP TYPICAL
- W/ WITH
- DWG DRAWING
- UNO UNLESS NOTED OTHERWISE
- P.T. PRESSURE TREATED
- THK THICK

500 W 5TH AVE. SUITE A
ANCHORAGE, ALASKA 99501
WWW.BCE-ALASKA.COM

PHONE (907) 573-0304
FAX (907) 573-2511
ANCHORAGE, ALASKA

Project No. _____
Date: JAN. 2013
Designed: LAP
Drawn: MCB
Approved: LAP

Sheet No. S1.0

REVISION	BY	DATE
AS-BUILT	CCP	01/14/13

PO BOX 2294 ANCHORAGE, AK 99501 PH: 907-363-1010 FAX: 907-363-1015

2009 WATER SYSTEM UPGRADES

GENERAL STRUCTURAL NOTES

ATKA, ALASKA



CONSTRUCTION RECORD	
FIELD BOOK	
STAGING	
ERECTOR	
AS-BUILT	
INSPECTOR	


SCALE:
1" = 1'-0" UNLESS OTHERWISE NOTED

RECORD DRAWING CERTIFICATE


THESE RECORD DRAWINGS REFLECT INFORMATION AS CONSTRUCTED, AND ARE BASED ON PERIODIC FIELD OBSERVATIONS BY CE2 ENGINEERS, WHO PROVIDED THE INFORMATION TO BCE, INC.

1-14-13


NAME _____ DATE _____

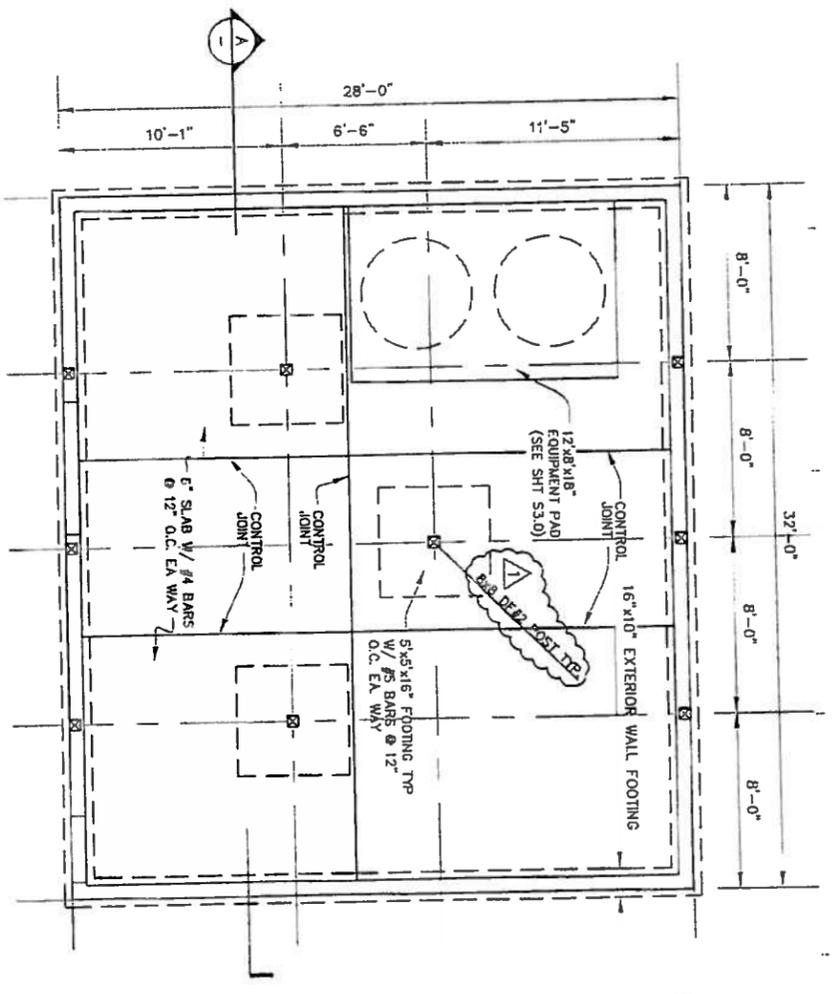

1 FOUNDATION PLAN
SCALE: 1/4" = 1'-0"

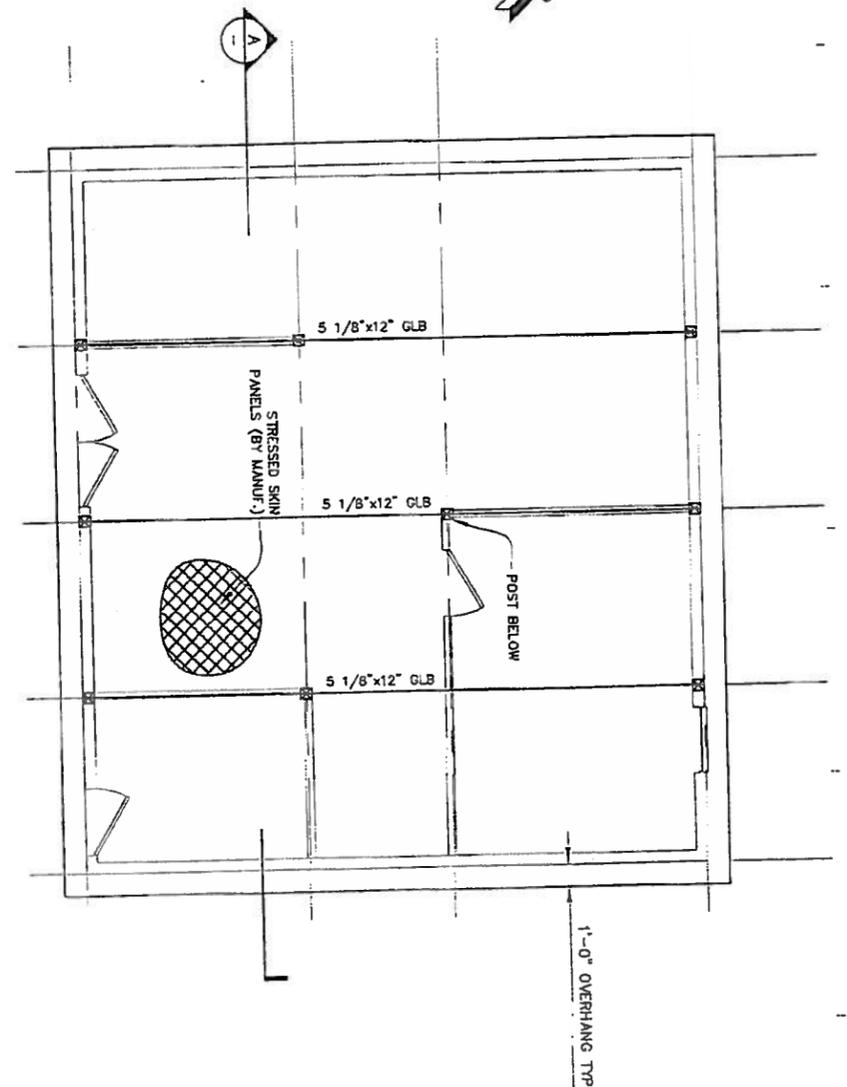

2 ROOF FRAMING PLAN
SCALE: 1/4" = 1'-0"

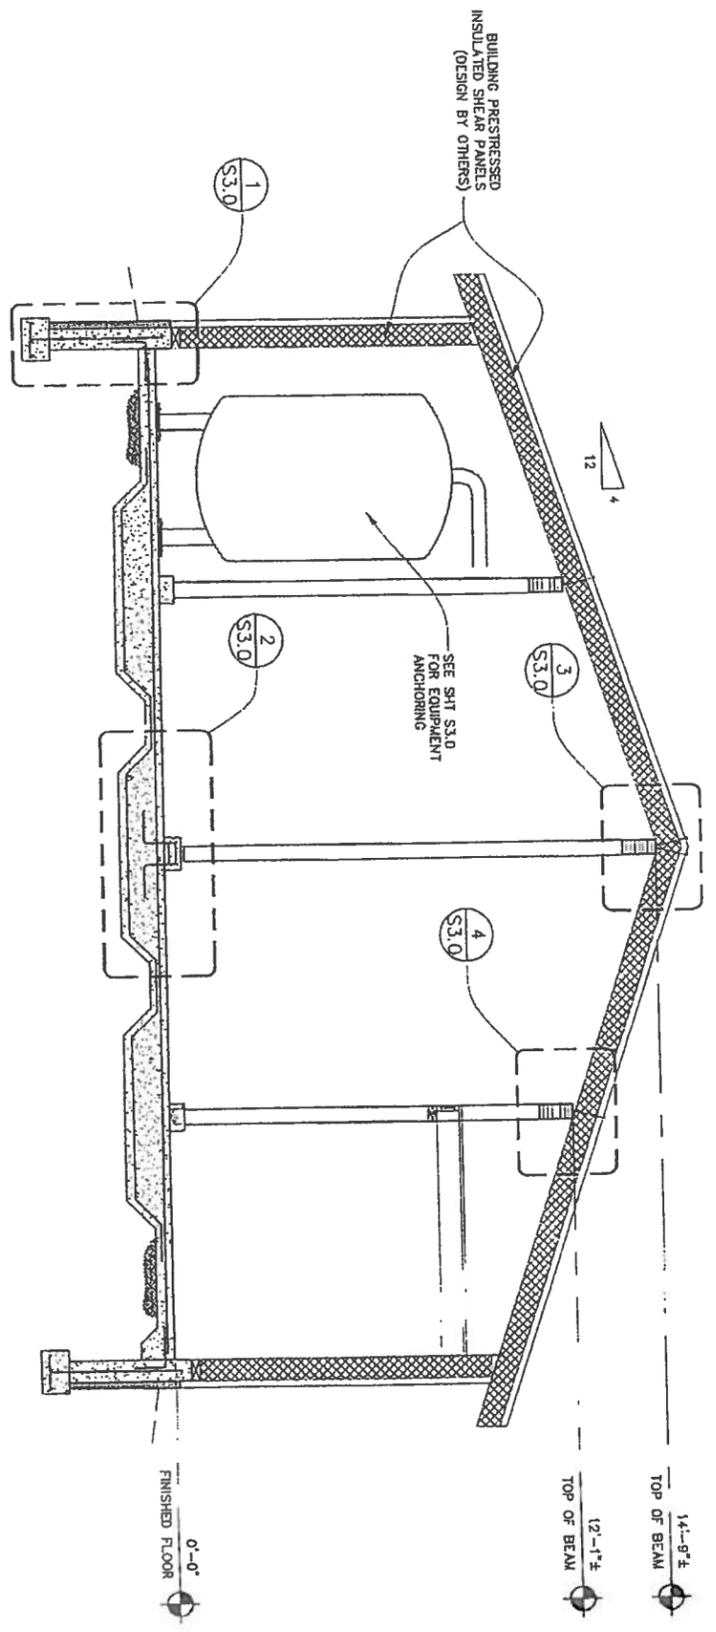

A BUILDING SECTION
SCALE: 3/8" = 1'-0"


CEZ ENGINEERS, INC.
 600 N 25th Ave, Suite 100
 Anchorage, Alaska 99503
 PHONE (907) 371-5284
 FAX (907) 371-5284
 www.cez-engineers.com

Project No.	
Date	JAN. 2013
Designed	LAP
Drawn	MCR
Approved	LAP
Sheet No.	S2.0

REVISION	BY	DATE
AS-BUILT	CCP	011413

CE2 ENGINEERS, INC.
 PO BOX 22848 ANCHORAGE, AK 99523 PH: 907-348-1010 FAX: 907-348-1015


2009 WATER SYSTEM UPGRADES
 PLANS AND SECTION
 ATKA, ALASKA

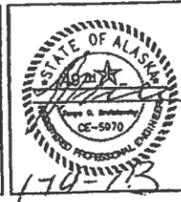


CONSTRUCTION RECORD	FIELD BOOK
STAGING	
FOREMAN	
AS-BUILT	
INSPECTOR	

SCALE:
 BAR IS ONE INCH ON ORIGINAL DRAWING
 IF NOT ONE INCH ON THIS SHEET, HOUST SCALE ACCORDINGLY


RECORD DRAWING CERTIFICATE
 THESE RECORD DRAWINGS REFLECT INFORMATION AS CONSTRUCTED, AND ARE BASED ON PERIODIC FIELD OBSERVATIONS BY CEZ ENGINEERS, WHO PROVIDED THE INFORMATION TO BCE, INC.
 NAME: *[Signature]* DATE: 1-14-13

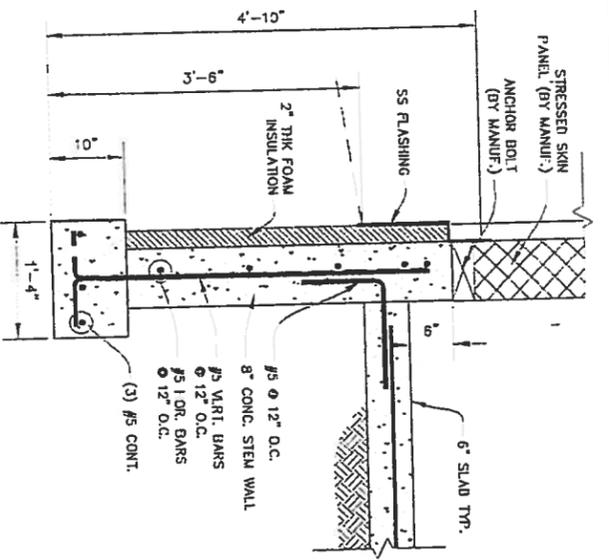


1 WALL FOOTING DETAIL
SCALE: 1" = 1'-0"

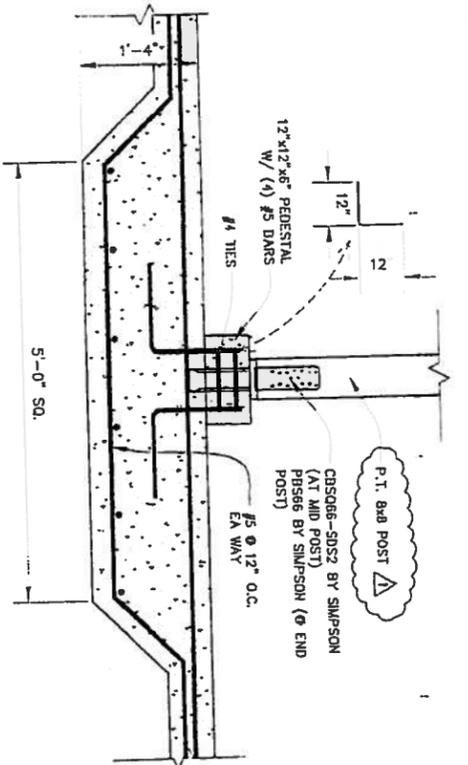


2 INTERIOR FOOTING DETAIL
SCALE: 1" = 1'-0"

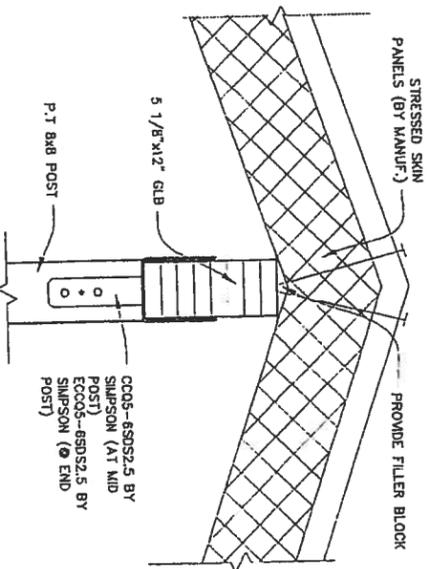


3 FRAMING DETAIL
SCALE: 1 1/2" = 1'-0"

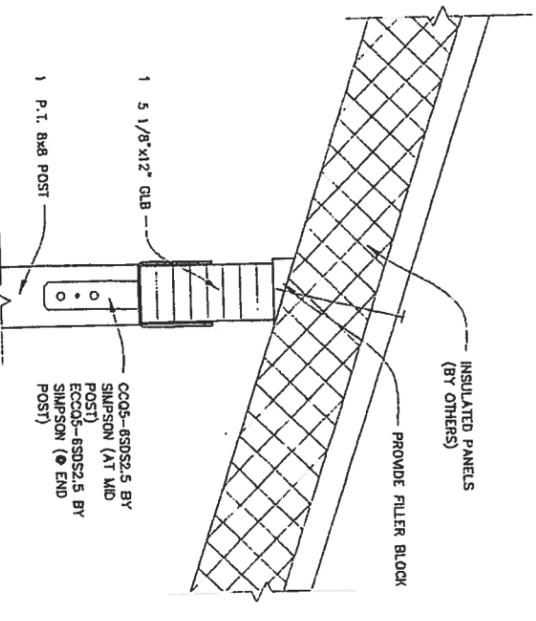


4 FRAMING DETAIL
SCALE: 1 1/2" = 1'-0"

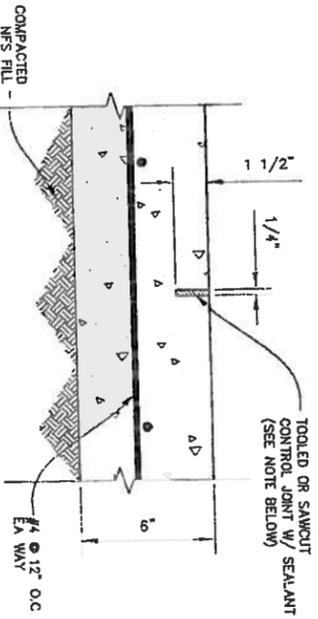

5 CONTROL JOINT DETAIL
NOT TO SCALE

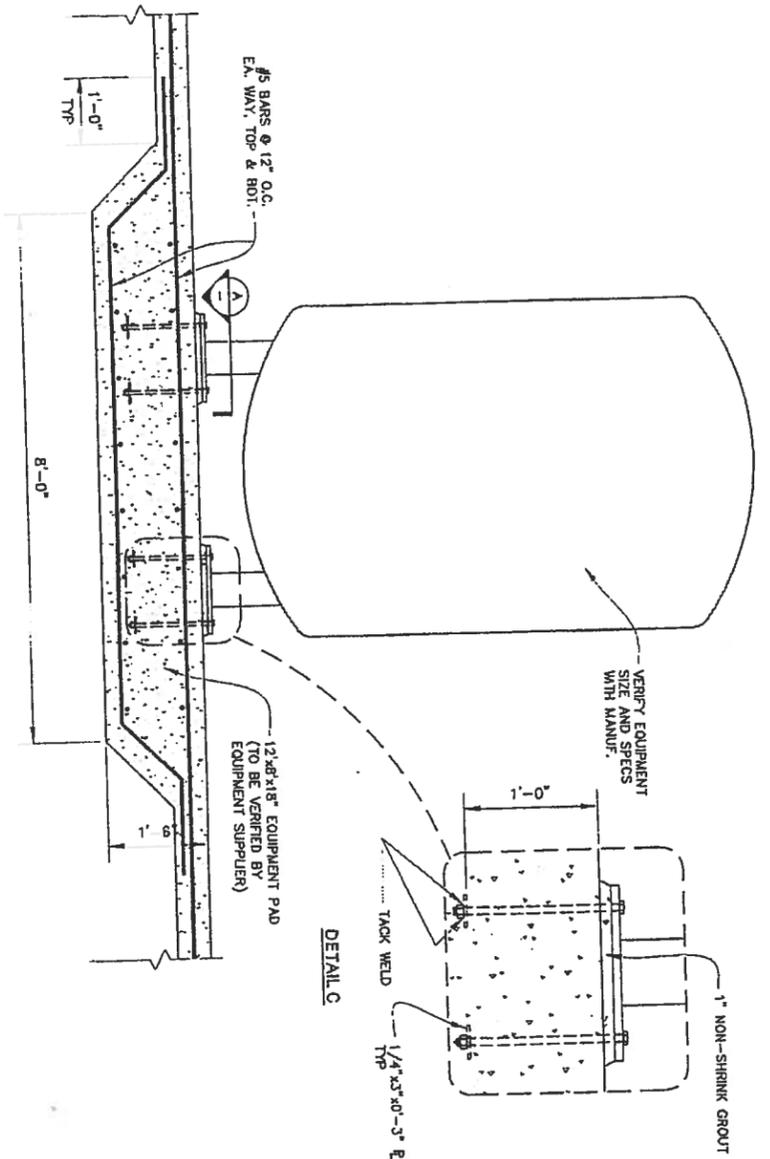

6 EQUIPMENT SUPPORT DETAIL
SCALE: 3/4" = 1'-0"

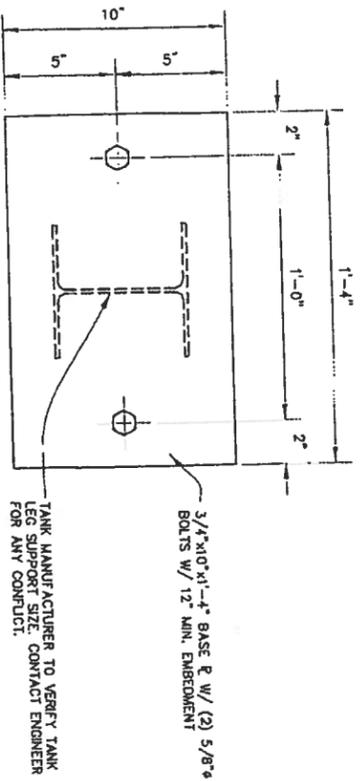

A BASE PLATE DETAIL (TYP. @ EQUIP. LEGS)
SCALE: 3" = 1'-0"

NOTES:
1. SEE MECHANICAL FOR BASE PLATE COALITIONS.
2. SEE MECHANICAL FOR PIPE SUPPORT COALITIONS.

TANK MANUFACTURER TO VERIFY TANK LEG SUPPORT SIZE. CONTACT ENGINEER FOR ANY CONFLICT.

BCE
Brenneise & Company
CONSULTING
ENGINEERS, INC.

600 W 7TH AVE. SUITE 4
ANCHORAGE, ALASKA 99501
PHONE: (907) 273-8241
FAX: (907) 273-8241
WWW.BCE-ALASKA.COM

PROJECT: 2009 WATER SYSTEM UPGRADES
SHEET NO. S3.0

Project No.	JAN. 2013
Date	LAP
Designed	MCB
Drawn	LAP
Approved	LAP

REVISION	BY	DATE
AS-BUILT	CCP	011413

CE2
ENGINEERS, INC.

PO BOX 22296 ANCHORAGE, AK 99522 P: 907-349-8170 FAX: 907-349-9175

2009 WATER SYSTEM UPGRADES
DETAILS
ATKA, ALASKA



CONSTRUCTION RECORD	FIELD BOOK
STAKING	FOREMAN
AS-BUILT	INSPECTOR

SCALE:
BAR IS ONE INCH ON ORIGINAL DRAWING
IF NOT ONE INCH ON THIS SHEET, ADJUST SCALE ACCORDINGLY

RECORD DRAWING CERTIFICATE
THESE RECORD DRAWINGS REFLECT INFORMATION AS CONSTRUCTED, AND ARE BASED ON PERIODIC FIELD OBSERVATIONS BY CE2 ENGINEERS, WHO PROVIDED THE INFORMATION TO BCE, INC.
NAME: [Signature] DATE: 1-14-13

ATKA WATER SYSTEM UPGRADE OPERATIONAL NARRATIVE

OPERATIONAL NARRATIVE (NUMBERS IN PARENTHESIS REFER TO CIRCLED NUMBERS IN PROCESS DIAGRAM, SHEET M1.1)

RAW WATER IS IMPOUNDED BEHIND A SMALL DAM. THE WATER IS COLLECTED USING A SCREEN WITH 0.06" SLOT OPENINGS, AND WILL FLOW TO THE WATER TREATMENT PLANT THROUGH A 4" BURIED PIPELINE. (1). BOOST PUMP BP-1 PUMPS 40 GPM THROUGH FILTER PROCESS. (2). AFTER TREATMENT, THE WATER FLOWS INTO A 130,300 GALLON WATER STORAGE TANK (WT-1).

THE WATER TREATMENT PLANT IS CONFIGURED FOR CONTINUOUS OPERATION WITH MANUAL SHUTDOWN BASED ON FILTER BREAK-THROUGH, AS INDICATED BY ELEVATED TURBIDITY OF THE TREATED WATER. THE FILTRATION PROCESS WILL BE MANUALLY SHUT DOWN WHEN THE WATER STORAGE TANK IS FULL.

COAGULANT WILL BE INJECTED AS PART OF THE TREATMENT PROCESS. (3) FOLLOWED BY FLOW THROUGH TWO 5-FOOT DIAMETER MULTIMEDIA PRESSURE FILTERS OPERATING IN PARALLEL. (4). THE TREATED WATER WILL BE STORED IN A 130,300 GALLON WATER STORAGE TANK WT-1. (9). THE ELEVATION HEAD OF THE TANK WILL PROVIDE THE DISTRIBUTION SYSTEM PRESSURE.

2XX SERIES- PRE-FILTRATION TREATMENT

PUMP OPERATION:

A 1.0 HORSEPOWER STAINLESS STEEL MULTI-STAGE PUMP MULTI-STAGE WILL BOOST FLOW FROM THE WATER SOURCE TO APPROXIMATELY 40 GPM AT 60 FT. OF HEAD TO PUSH THE WATER THROUGH THE FILTRATION SYSTEM AND INTO THE WATER STORAGE TANK WT-1. (2).

WHEN THE MULTIMEDIA FILTERS FIRST COME ON LINE, FILTERED WATER FLOWS THROUGH VALVE V-2 TO WASTE FOR APPROXIMATELY 10 MINUTES TO CONDITION THE FILTER MEDIA. (6). TURBIDMETER TU-2 WILL BE MONITORED TO ENSURE THAT THE FILTERS WERE PROPERLY BACKWASHED AND CONDITIONED. WHEN THE COMBINED FILTER EFFLUENT IS WITHIN THE REQUIRED VALUES, FILTER TO STORAGE VALVE V-3 WILL BE OPENED AND FILTER TO WASTE VALVE V-2 WILL BE CLOSED. WATER WILL THEN FLOW INTO STORAGE TANK WT-1. CONTROL VALVE CV-2 WILL BE ADJUSTED MANUALLY BY THE OPERATOR TO MAINTAIN FLOW AT 40 GPM (OR OTHER DESIRED VALUE UP TO 50 GPM) BASED ON READINGS OF TOTALIZING METER M-2.

BACKWASH PUMP BW-1 CAN BE USED TO CLEAN THE INTAKE SCREEN AT THE RESERVOIR BY RUNNING POTABLE WATER THROUGH THE RAW WATER LINE TOWARD THE 0.06" SLOTTED INTAKE SCREEN. (12).

METER M-1 RECORDS THE RAW WATER FLOW.

TURBIDMETER TU-1 MEASURES THE RAW WATER TURBIDITY AS A REFERENCE FOR ASSESSING THE EFFECTIVENESS OF THE TREATMENT PROCESS.

COAGULANT ADDITION:

COAGULANT USED IN THE TREATMENT PROCESS WILL BE MIXED IN A VAT, OR USED NEAT. (3). STATIC MIXER SM-1 BLENDS COAGULANT FROM COAGULANT FEED PUMP CF-1. STREAMING CURRENT DETECTOR SCD-1 WILL MEASURE THE NET CHARGE OF THE CONTAMINANTS AND COAGULANTS IN THE WATER, AND ADJUST CF-1 TO FEED THE OPTIMUM AMOUNT OF COAGULANT INTO THE PROCESS STREAM. THE COAGULANT DOSAGE WILL VARY AS REQUIRED TO ACHIEVE PROPER COAGULATION, BUT WILL TYPICALLY BE APPROXIMATELY 3 PPM. SCD-1 WILL SEND A 4-20 mA SIGNAL TO COAGULANT FEED PUMP CF-1 TO MAINTAIN A PREDETERMINED SETPOINT. THE SETPOINT CAN BE CHANGED BY THE OPERATOR, BASED ON JAR TESTING RESULTS.

SCD-1 AND CF-1 ARE TURNED ON AND OFF BY FLOW SWITCH FS-1.

3XX SERIES - FILTER BACKWASH AND AIR SCOUR

GAUGES DP-1 AND DP-2 WILL MONITOR DIFFERENTIAL PRESSURE ACROSS PRESSURE FILTERS PF-1 AND PF-2 RESPECTIVELY.

FILTER BACKWASH WILL BE INITIATED MANUALLY BY THE OPERATOR. (5). THE PROCEDURE FOR BACKWASHING FILTER PF-1 FOLLOWS (PF-2 SIMILAR):

1. BOOST PUMP BP-1 IS SHUT DOWN.
2. ALL VALVES ARE CLOSED.
3. DRAIN DOWN VALVE V-12 IS OPENED ALLOWING THE WATER TO DRAIN DOWN FROM THE HEADSPACE IN THE TANK ABOVE THE FILTER MEDIA.
4. AFTER THE WATER IS DRAINED DOWN, AIR SCOUR VALVE V-14 IS OPENED AND THE AIR SCOUR BLOWER AB-1 IS TURNED ON FOR APPROXIMATELY 2 MINUTES. AIR BUBBLES WILL RISE THROUGH THE FILTER MEDIA, AGITATING THE SAND AND ANTHRACITE LAYERS TO BREAK LOOSE THE TRAPPED CONTAMINANTS. THE OPERATOR WILL MONITOR THE MEDIA SCOURING ACTION THROUGH THE FILTER VESSEL WINDOW AND ADJUST THE AIR FLOW AS NEEDED TO ACHIEVE GOOD AGITATION.

5. DRAIN DOWN VALVE V-12 AND AIR SCOUR VALVE V-14 ARE CLOSED TO COMPLETE THE AIR SCOUR STEP.
6. BACKWASH VALVES V-13 AND V-11 ARE OPENED.
7. BACKWASH PUMP BW-1 IS TURNED ON TO "SLOW FILL" SETTING (75 GPM) FOR 4 MINUTES. THEN IS TURNED TO "BACKWASH" SETTING FOR 10 MINUTES (OR OTHER TIME DESIRED).
8. BACKWASH VALVES BV-13 AND BV-11 ARE CLOSED, AND BACKWASH PUMP BW-1 IS SHUT OFF AFTER THE BACKWASH OPERATION IS COMPLETE.

FLOW METER M-4 WILL MEASURE THE FLOW OF BACKWASH WATER THROUGH THE PRESSURE FILTERS.

BACKWASH WATER WILL FLOW INTO THE BACKWASH WATER DISCHARGE BASIN WHERE COAGULANT AND CONTAMINANTS WILL BE ALLOWED TO SETTLE OUT BEFORE THE BACKWASH WATER IS DISCHARGED.

4XX SERIES - POST-FILTRATION TREATMENT

CHEMICAL FEED PUMP CF-2 WILL INJECT A HYPOCHLORITE DISINFECTANT SOLUTION, STORED IN THE SOLUTION TANK, INTO THE FILTER EFFLUENT (8). THE DISINFECTANT DOSAGE WILL BE INITIALLY ADJUSTED BY THE OPERATOR, BUT A 4-20MA SIGNAL FROM FLOW METER M-2 WILL PACE CF-2.

FLOW SWITCH FS-2 WILL TURN ON AND OFF CF-2.

5XX SERIES - WATER STORAGE TANK AND DISTRIBUTION SYSTEM

TREATED WATER WILL BE STORED IN AN INSULATED 130,300 GALLON BOLTED-AND-GASKETED WATER TANK. (9). TANK DIMENSIONS ARE APPROXIMATELY 34-FT. DIAMETER X 24-FT. HIGH. AN INSULATED 4-IN. HDPE X 12-IN. ALUMINUM JACKET ARCTIC PIPE WILL SUPPLY THE TANK. A 12-IN. X 18-IN. ALUMINUM JACKET ARCTIC PIPE WILL BE USED TO DRAW WATER FROM THE TANK. A VORTEX BREAKER ON THE TANK END OF THE 12X18 ARCTIC PIPE WILL SERVE AS A SUCTION.

TANK WT-1 ALSO SERVES AS THE DISINFECTANT CONTACT TANK FOR THE TREATMENT PROCESS, SUPPLYING 1-LOG INACTIVATION OF GIARDIA CYSTS AND 4-LOG INACTIVATION OF VIRUSES.

STATIC LEVEL OF WATER IN THE TANK WILL BE MEASURED USING ALTITUDE GAUGE PG-2. A TABLE MOUNTED NEAR PG-2 WILL CONVERT GAUGE READINGS TO GALLONS OF WATER REMAINING IN TANK.


TANK FILL AND DRAW LINES WILL BE EQUIPPED WITH FREEZE PROTECTION CIRCULATING PUMP CP-1. PUMP CP-1 WILL OPERATE DURING FREEZING TEMPERATURES WHEN FLOW SWITCH FS-2 REGISTERS NO FLOW.

BURIED 8-IN. HDPE PIPING WILL DISTRIBUTE POTABLE WATER FROM WT-1 TO CUSTOMERS BY GRAVITY FLOW. (11). FLOW METER M-4 WILL REGISTER GALLONS OF WATER SUPPLIED TO THE DISTRIBUTION SYSTEM. VACUUM BREAKER VB-1 WILL PROTECT THE WATERMAIN FROM NEGATIVE PRESSURES IF THE WATER SUPPLY IS BE SHUT OFF AND DRAINED.



RECORD DRAWING
1-22-2013

<p>Project No. _____ Date MAY 2010 Designed LAP Drawn _____ Approved LAP</p>	<table border="1" style="width: 100%; border-collapse: collapse;"> <tr> <th>REVISION</th> <th>BY</th> <th>DATE</th> </tr> <tr> <td> </td> <td> </td> <td> </td> </tr> <tr> <td> </td> <td> </td> <td> </td> </tr> </table>	REVISION	BY	DATE							 PO BOX 23294 ANCHORAGE, AK 99523 PH: 807-349-1010 FAX: 807-349-1015	<p>2009 WATER SYSTEM UPGRADES</p> <p>WATER TREATMENT PROCESS OPERATIONAL NARRATIVE</p> <p>ATKA, ALASKA</p>		<table border="1" style="width: 100%; border-collapse: collapse;"> <tr> <th colspan="2">CONSTRUCTION RECORD</th> </tr> <tr> <td>FIELD BOOK</td> <td> </td> </tr> <tr> <td>STAGING</td> <td> </td> </tr> <tr> <td>FOREMAN</td> <td> </td> </tr> <tr> <td>AS-BUILT</td> <td> </td> </tr> <tr> <td>INSPECTOR</td> <td> </td> </tr> </table>	CONSTRUCTION RECORD		FIELD BOOK		STAGING		FOREMAN		AS-BUILT		INSPECTOR		<p>SCALE: AS SHOWN</p> <p>IF NOT ONE INCH ON THIS SHEET, ADA'S SCALES ACORDING TO</p>	<p>RECORD DRAWING CERTIFICATE</p> <p>THESE DRAWINGS REFLECT RECORDED INFORMATION OBTAINED DURING CONSTRUCTION. INFORMATION PROVIDED HEREIN IS ACCURATE TO THE BEST OF MY KNOWLEDGE.</p> <p>NAME _____ DATE _____</p>
REVISION	BY	DATE																										
CONSTRUCTION RECORD																												
FIELD BOOK																												
STAGING																												
FOREMAN																												
AS-BUILT																												
INSPECTOR																												

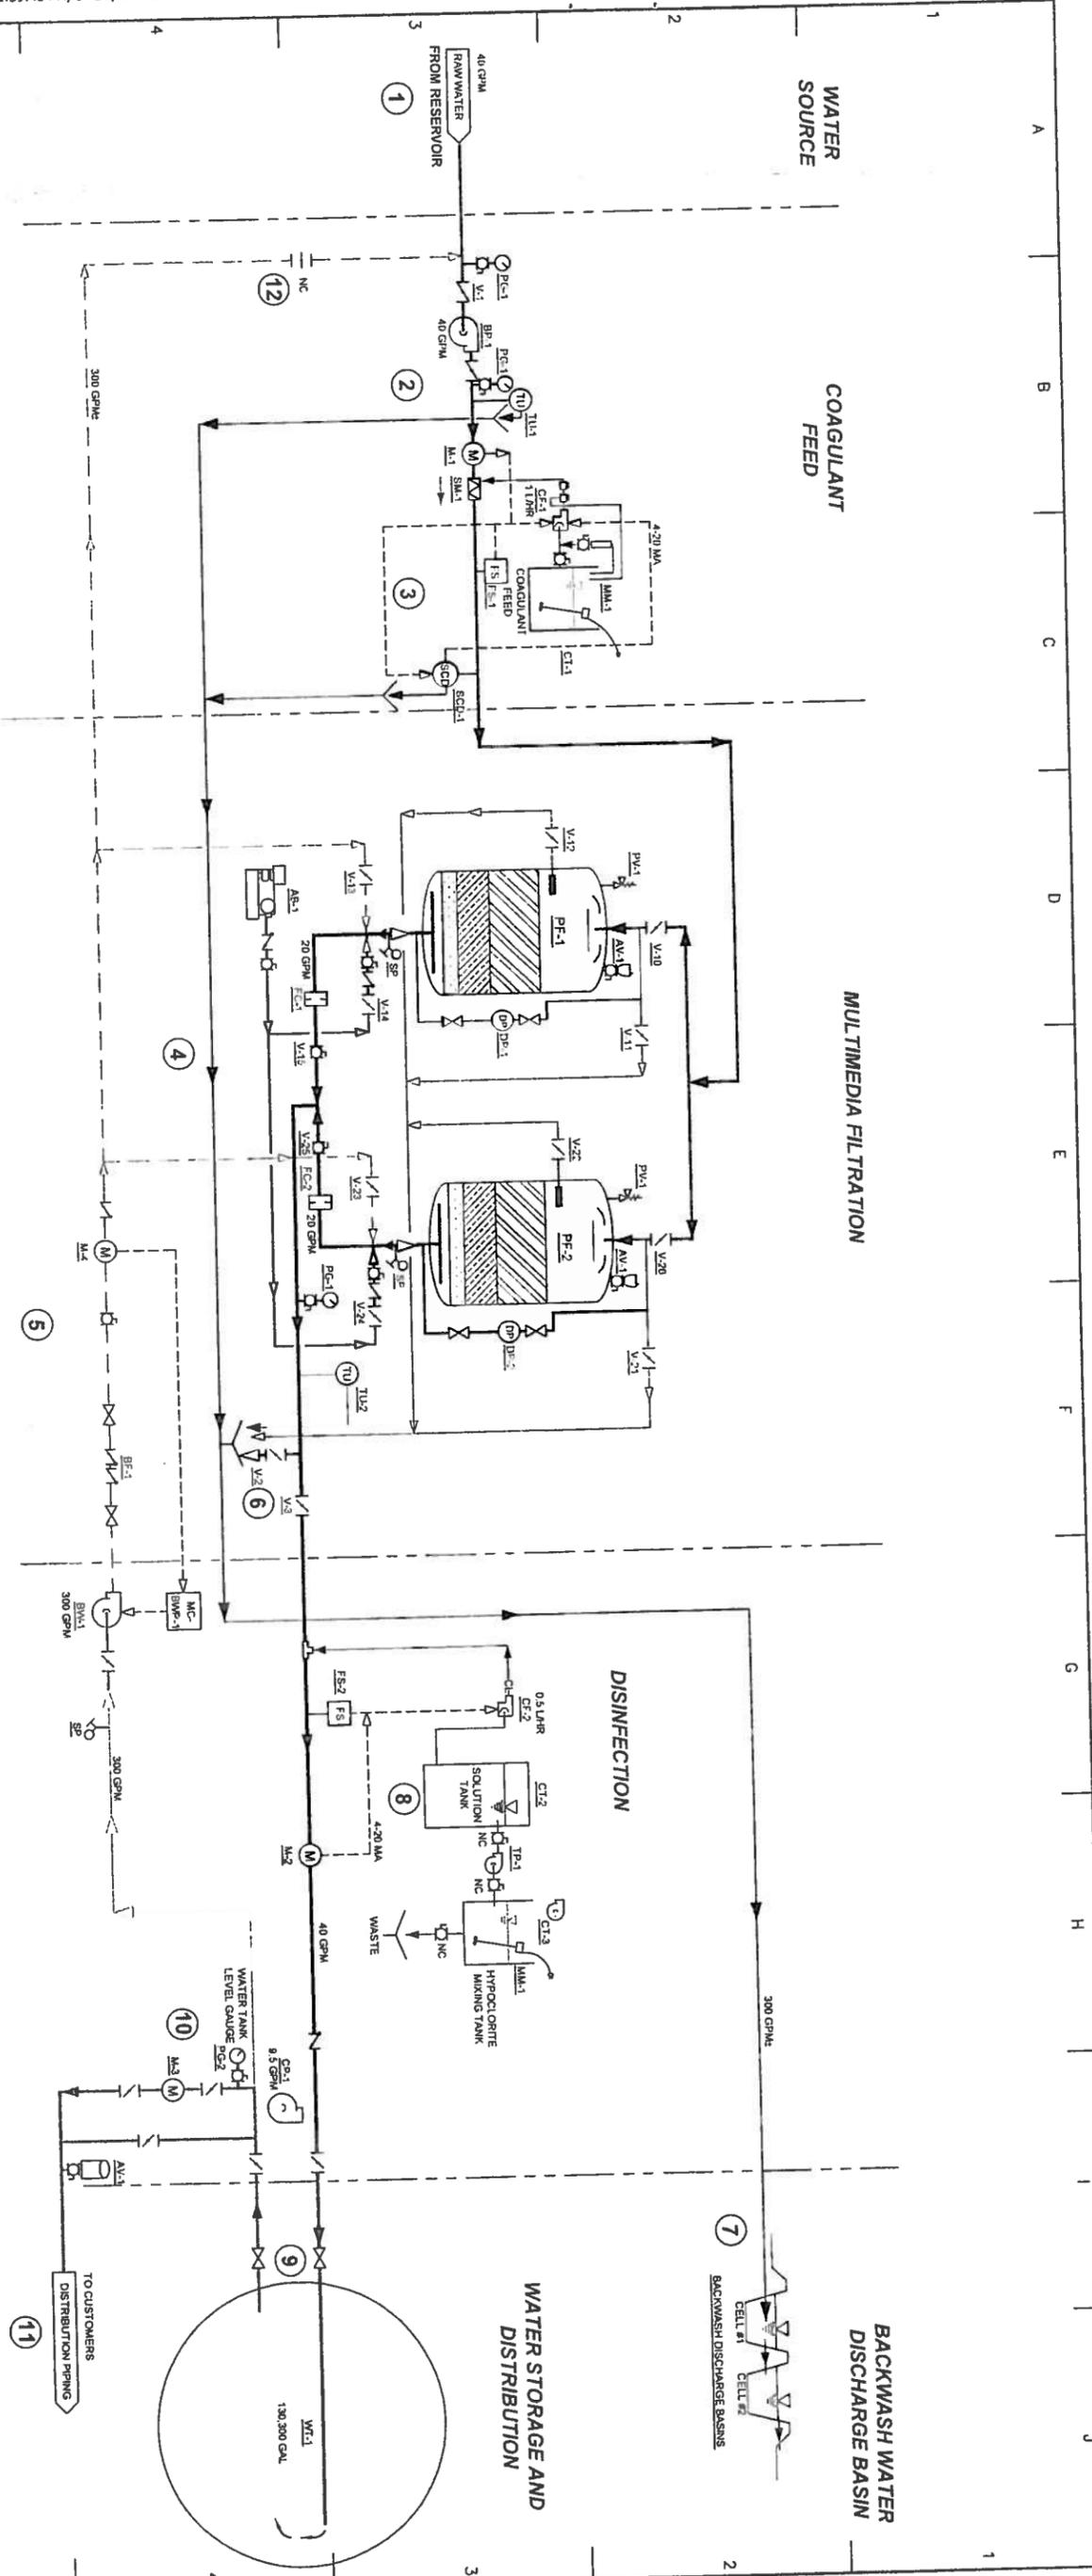

WATER TREATMENT PROCESS DIAGRAM

NOTE: FOR PROCESS NARRATIVE TEXT, SEE SHEET M1.0

- LEGEND**
- CONTROL LINK
 - POTABLE WATER
 - BACKWASH IN
 - PROCESS WATER
 - BACKWASH OUT
 - CHEMICAL FEED
 - AIR SCOUR
 - AIR MIXER
 - AIR BLOWER
 - AIR AND VACUUM RELIEF VALVE
 - BACKFLOW PREVENTOR
 - CHEMICAL FEED PUMP
 - CIRCULATION PUMP
 - CHEMICAL TANK
 - CONTROL VALVE
 - DIFFERENTIAL PRESSURE INDICATOR
 - FLOW CONTROL
 - FLOW METER
 - FLOW SWITCH
- MF1.1 MAIN PRESSURE FILTER
 - CP1.1 CONTROL PANEL
 - LG1.1 LEVEL CONTROL
 - MM1.1 MOTORIZED MIXER
 - M1.1 METER
 - NC NORMALLY CLOSED VALVE
 - PI1.1 PRESSURE GAUGE
 - PF1.1 MULTIMEDIA PRESSURE FILTER
 - PR1.1 PRESSURE RELIEF VALVE
 - SC1.1 STREAMING CURRENT DETECTOR
 - SM1.1 STATIC MIXER
 - SP1.1 SAMPLE PORT
 - TE1.1 THERMOMETER
 - TI1.1 TURBIDIMETER
 - TS1.1 TURBIDITY SENSOR
 - VB1.1 VACUUM BREAKER
 - WT1.1 WATER TANK


RECORD DRAWING
1-22-2013



CE2 ENGINEERS, INC. PO BOX 232948 ANCHORAGE, AK 99523 PH: 607-340-0100 FAX: 607-340-1015	2009 WATER SYSTEM UPGRADES WATER TREATMENT PROCESS DIAGRAM ATKA, ALASKA	STATE OF ALASKA 49 IN LICENSE NO. 1394 PAUL C. MEZZALANA REGISTERED PROFESSIONAL ENGINEER	CONSTRUCTION RECORD FIELD BOOK STAKING FOREMAN AS-BUILT INSPECTOR	SCALE: AS SHOWN BAR IS ONE INCH OR ORIGINAL DRAWING IF NOT ONE INCH OR 3/4" SHEET AS SHOWN SCALE IS ACCORDINGLY	RECORD DRAWING CERTIFICATE THESE DRAWINGS REFLECT RECORDED INFORMATION OBTAINED DURING CONSTRUCTION. INFORMATION PROVIDED HEREIN IS ACCURATE TO THE BEST OF MY KNOWLEDGE NAME _____ DATE _____
	Project No. _____ Date MAY 2010 Designed LAP Drawn _____ Approved LAP	REVISION BY DATE			

NOTES

1. FILTER ARRANGEMENT SHOWN IS SET BY DESIGN. SUPERINTENDENT TO COORDINATE EXACT FILTER PLACEMENT DURING CONSTRUCTION TO MATCH LAYOUT AND ANCHOR BOLT PATTERNS.
2. ALL EXPOSED PIPING, VALVES, AND FITTINGS SHALL BE SCHEDULE 80 PVC UNLESS SPECIFICALLY NOTED OTHERWISE BY THE PROJECT DESIGN ENGINEER.
3. DURING ASSEMBLY/INSTALLATION OF PIPING EQUIPMENT, SWEL-TYPE (VAN STONE) ADAPTER FLANGES SHALL BE UTILIZED AS NEEDED TO GUARANTEE ACCURATE AXIAL AND RADIAL PIPING ALIGNMENTS. ALL FLANGE BOLTS, NUTS, AND WASHERS SHALL BE 304 STAINLESS STEEL TO PREVENT CORROSION.
4. PIPE SUPPORTS SHALL BE POSITIONED ON 32-INCH CENTERING THROUGHOUT THE WTP FACILITY.
5. NO PAINT SHALL BE APPLIED TO ANY PLASTIC PIPE SEGMENTS OR FITTINGS.
6. ALL AIR-SCOUR PIPING AND FITTINGS SHALL BE HIGH DENSITY POLYETHYLENE, "AIR PRO" OR APPROVED EQUAL PIPE, 2".
7. AIR "LOADING" RATES FROM THE AIR-SCOUR BLOWER WILL INITIALLY FOLLOW INDUSTRY RECOMMENDATIONS OF 4 STANDARD CUBIC FEET PER MINUTE PER SQUARE FOOT OF CROSS-SECTIONAL FILTER BED AREA (SCFM/SF). THIS FLOW RATE IN A 60" DIA FILTER IS 78 SCFM. OPTIMAL RATES WILL BE ESTABLISHED BASED ON RESULTS AS OBSERVED DURING THE WTP START-UP PHASE.
8. FILTER REFILL FLOW RATE SHOULD BE INITIALLY SET AT 40 GPM.
9. BACKWASH FLOW RATES WILL INITIALLY FOLLOW INDUSTRY RECOMMENDATIONS OF 15 GPM PER SQUARE FOOT OF CROSS-SECTIONAL FILTER BED AREA (GPM/SF). THIS FLOW RATE IN A 60" DIA FILTER IS 295 GPM. OPTIMAL RATES WILL BE ESTABLISHED BASED ON RESULTS AS OBSERVED DURING THE WTP START-UP PHASE.

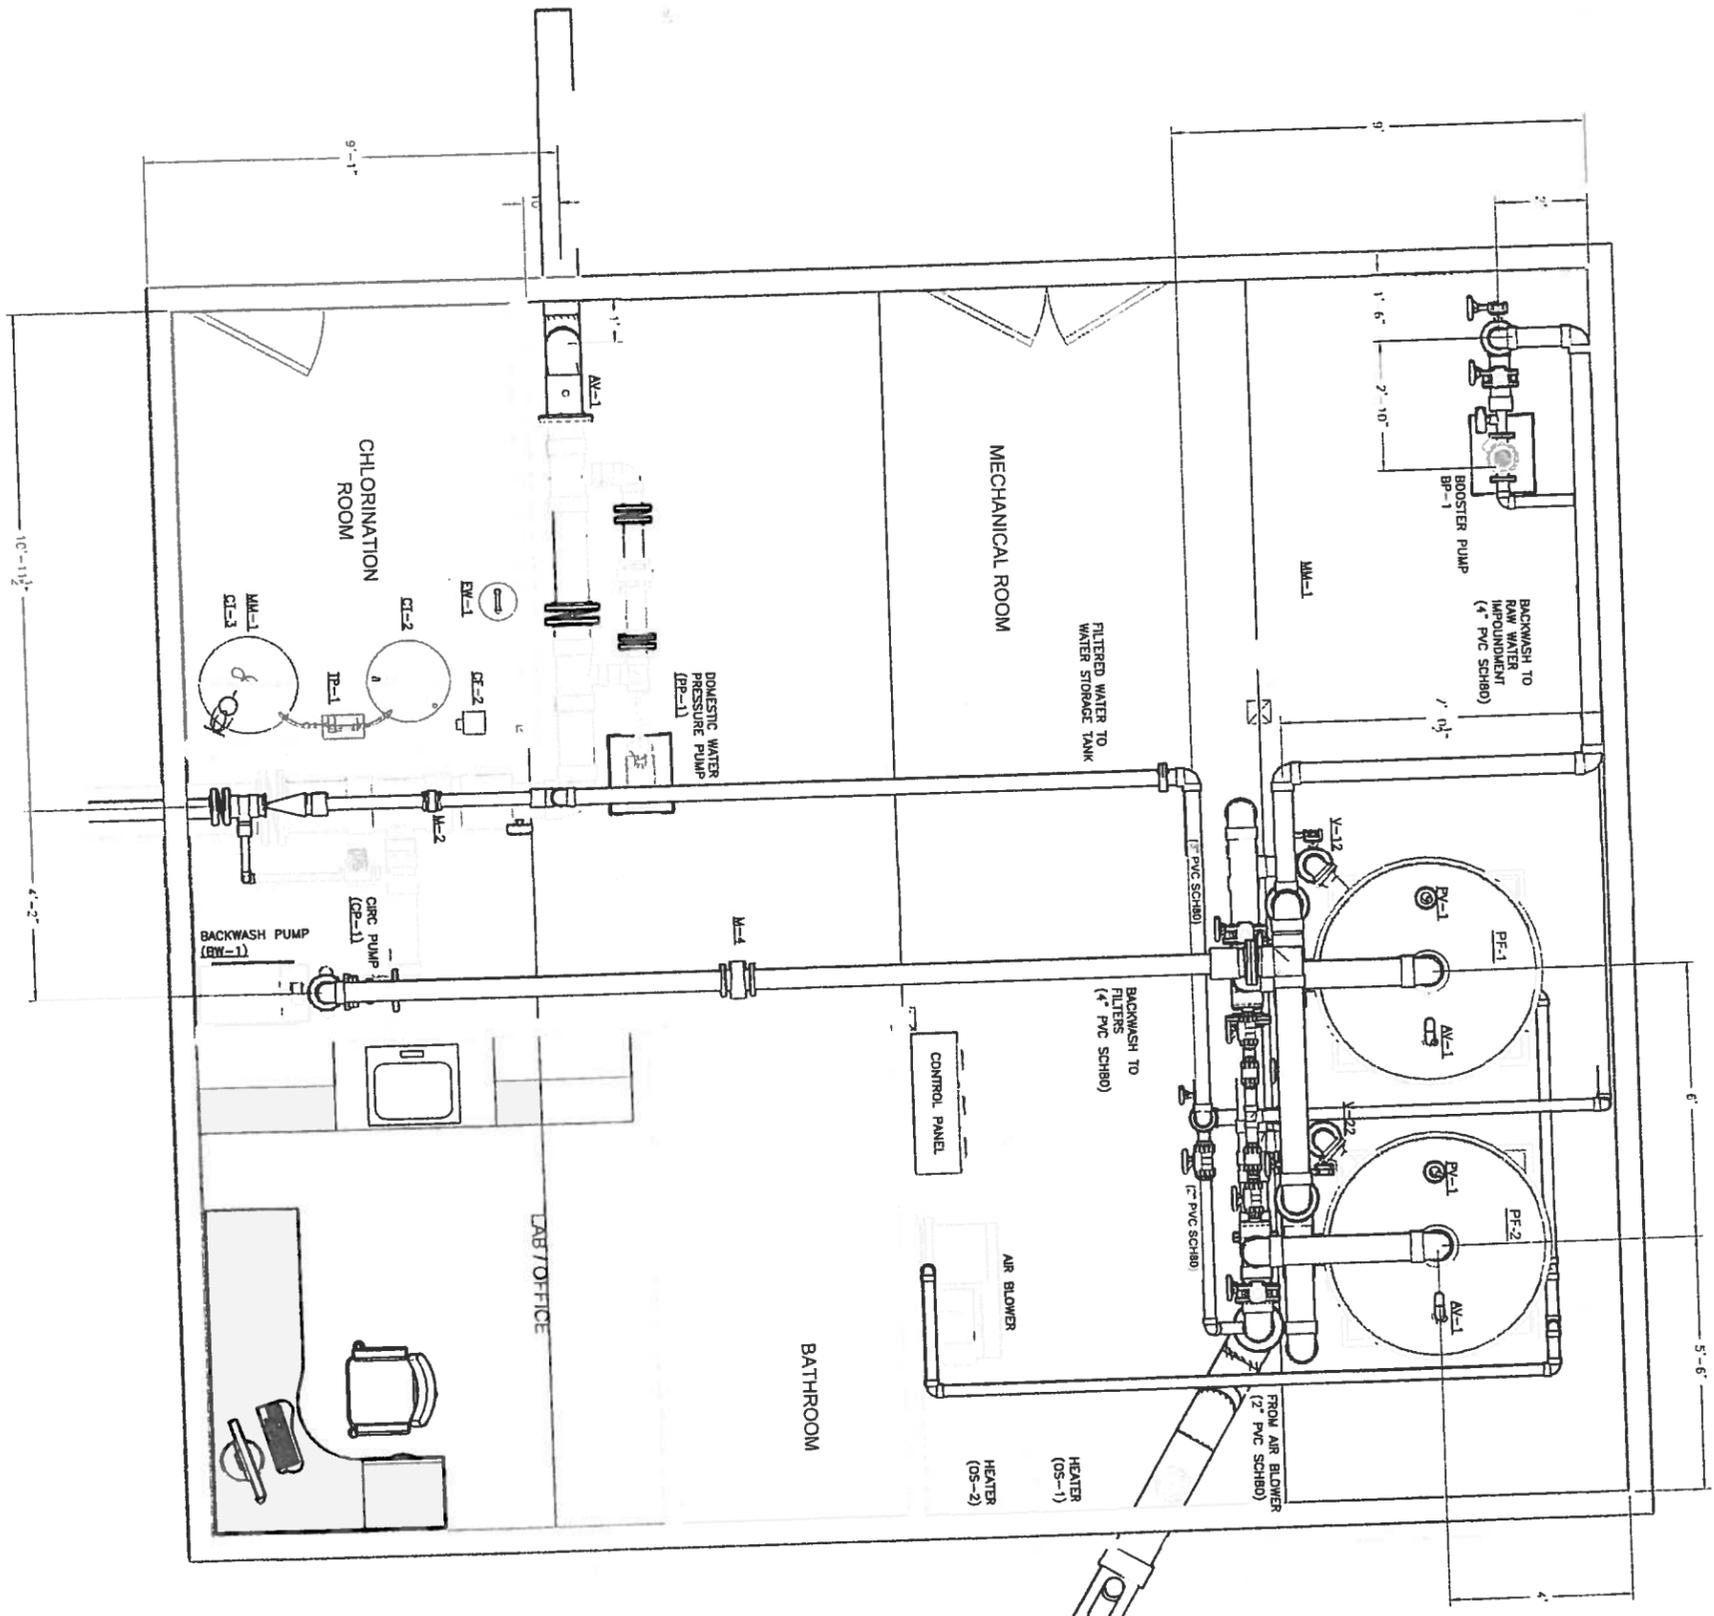


1 MECHANICAL PIPING - PLAN
M2.2 SCALE: 1/2" = 1'-0"


RECORD DRAWING
1-22-2013



<p>Project No. _____ Date <u>MAY 2010</u> Designed <u>LAP</u> Drawn _____ Approved <u>LAP</u></p>	<table border="1" style="width: 100%; border-collapse: collapse;"> <thead> <tr> <th>REVISION</th> <th>BY</th> <th>DATE</th> </tr> </thead> <tbody> <tr><td> </td><td> </td><td> </td></tr> <tr><td> </td><td> </td><td> </td></tr> <tr><td> </td><td> </td><td> </td></tr> </tbody> </table>	REVISION	BY	DATE										 PO BOX 22248 ANCHORAGE, AK 99523 PR: 907-349-1010 FAX: 907-349-1915	2009 WATER SYSTEM UPGRADES WATER TREATMENT PLANT MECHANICAL FLOOR PLAN ATKA, ALASKA	<table border="1" style="width: 100%; border-collapse: collapse;"> <tr><td>CONSTRUCTION RECORD</td></tr> <tr><td>FIELD BOOK</td></tr> <tr><td>STAKING</td></tr> <tr><td>FOREMAN</td></tr> <tr><td>AS-BUILT</td></tr> <tr><td>INSPECTOR</td></tr> </table>	CONSTRUCTION RECORD	FIELD BOOK	STAKING	FOREMAN	AS-BUILT	INSPECTOR	<p>SCALE: AS SHOWN</p> <p>BAR IS ONE INCH ON ORIGINAL DRAWING</p> <p>1" = 10' ONE INCH ON THIS SHEET = FOUR FEET ON ORIGINAL</p>	<p>RECORD DRAWING CERTIFICATE</p> <p>THESE DRAWINGS REFLECT RECORDED INFORMATION OBTAINED DURING CONSTRUCTION. INFORMATION PROVIDED HEREIN IS ACCURATE TO THE BEST OF MY KNOWLEDGE.</p> <p>NAME _____ DATE _____</p>
REVISION	BY	DATE																						
CONSTRUCTION RECORD																								
FIELD BOOK																								
STAKING																								
FOREMAN																								
AS-BUILT																								
INSPECTOR																								

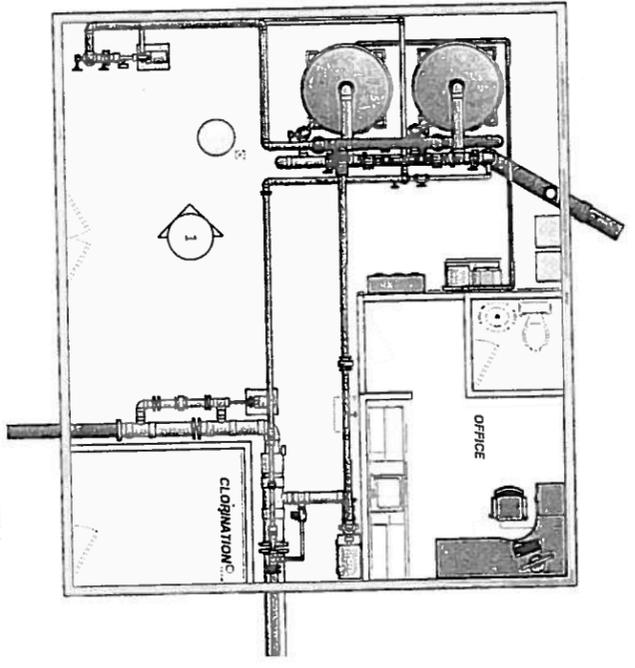

WATER TREATMENT PLANT DETAIL KEY
SCALE: NTS

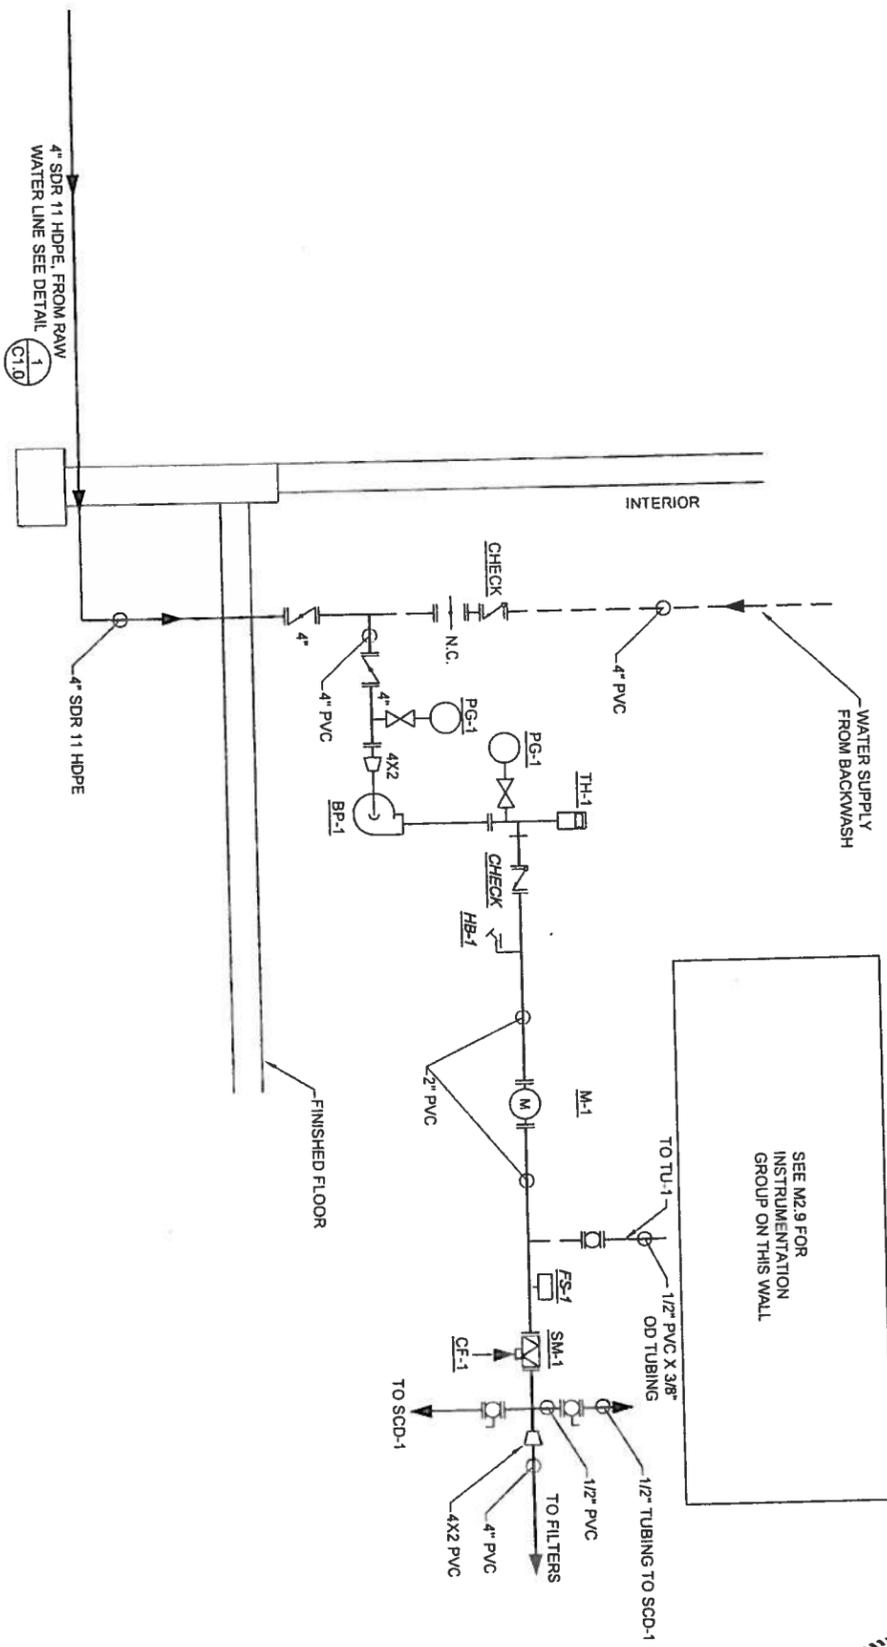

1 WATER SUPPLY PROCESS PIPING ELEVATION
M2.1 SCALE: NTS

SEE M2.9 FOR INSTRUMENTATION GROUP ON THIS WALL

RECORD DRAWING
1-22-2013




Project No.	
Date	MAY 2010
Designed	LAP
Drawn	
Approved	LAP

REVISION	BY	DATE

CE₂
ENGINEERS, INC.
PO BOX 23296 ANCHORAGE, AK 99523 PH: 807-349-1010 FAX: 807-349-1015


2009 WATER SYSTEM UPGRADES
WATER SUPPLY PROCESS DIAGRAM
ATKA, ALASKA

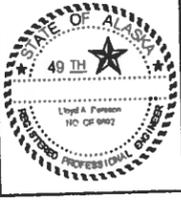


CONSTRUCTION RECORD	
FIELD BOOK	
STAKING	
FOREMAN	
AS-BUILT	
INSPECTOR	

SCALE: AS SHOWN
SCALE IS ONE INCH ON ORIGINAL DRAWING
IF NO ONE INCH ON THIS SHEET, ADJUST SCALE ACCORDINGLY


RECORD DRAWING CERTIFICATE	
THESE DRAWINGS REFLECT RECORDED INFORMATION OBTAINED DURING CONSTRUCTION. INFORMATION PROVIDED HEREIN IS ACCURATE TO THE BEST OF MY KNOWLEDGE	
NAME	DATE

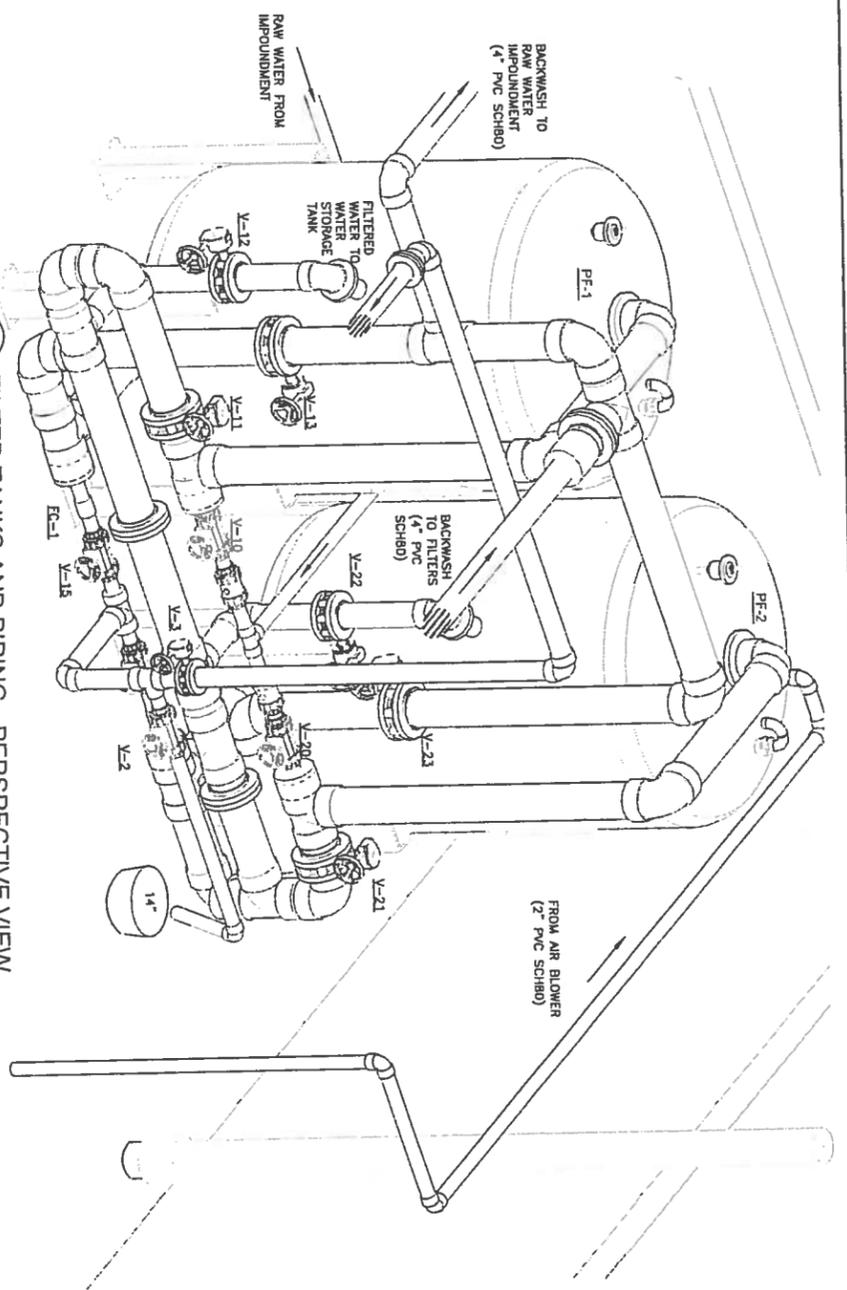


3 FILTER TANKS AND PIPING - PERSPECTIVE VIEW
M2.2 SCALE 3/4" = 1'-0"

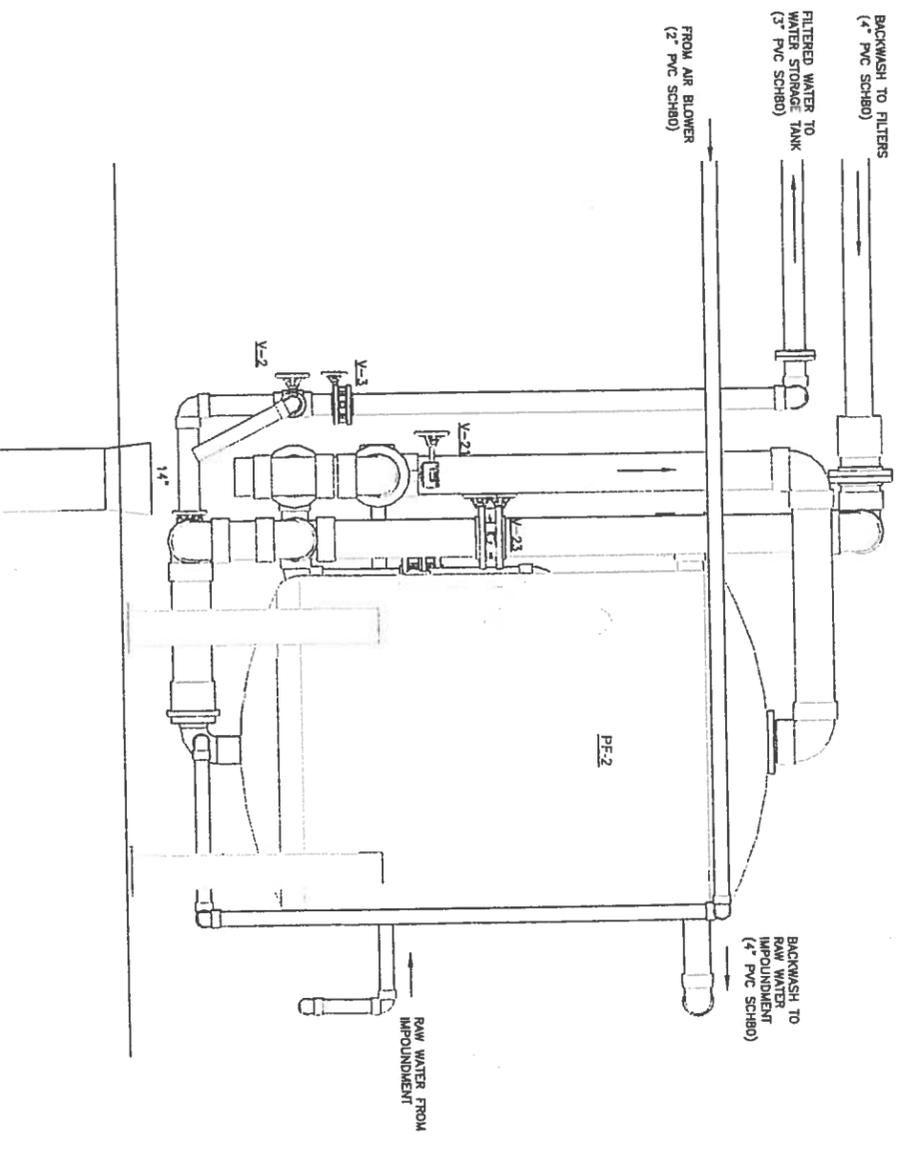

4 FILTER TANKS AND PIPING - SIDE ELEVATION
M2.2 SCALE 3/4" = 1'-0"

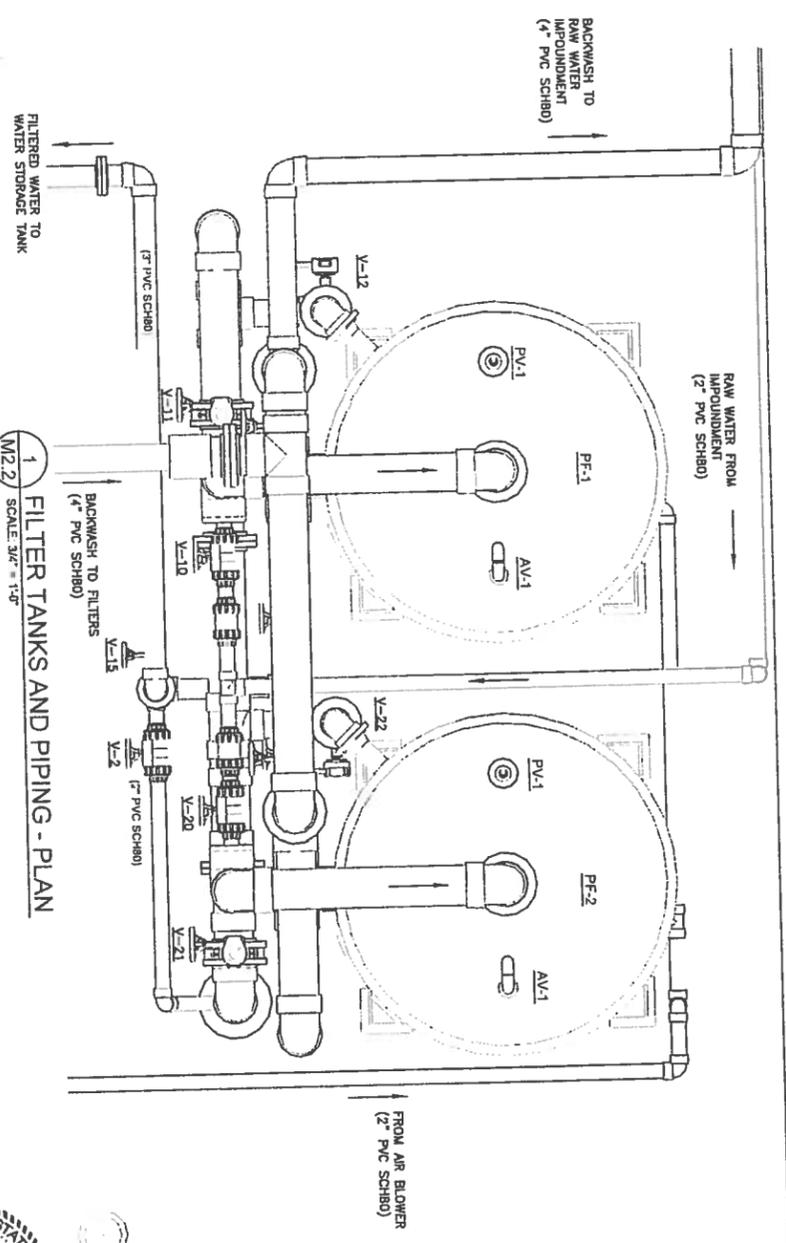

1 FILTER TANKS AND PIPING - PLAN
M2.2 SCALE 3/4" = 1'-0"

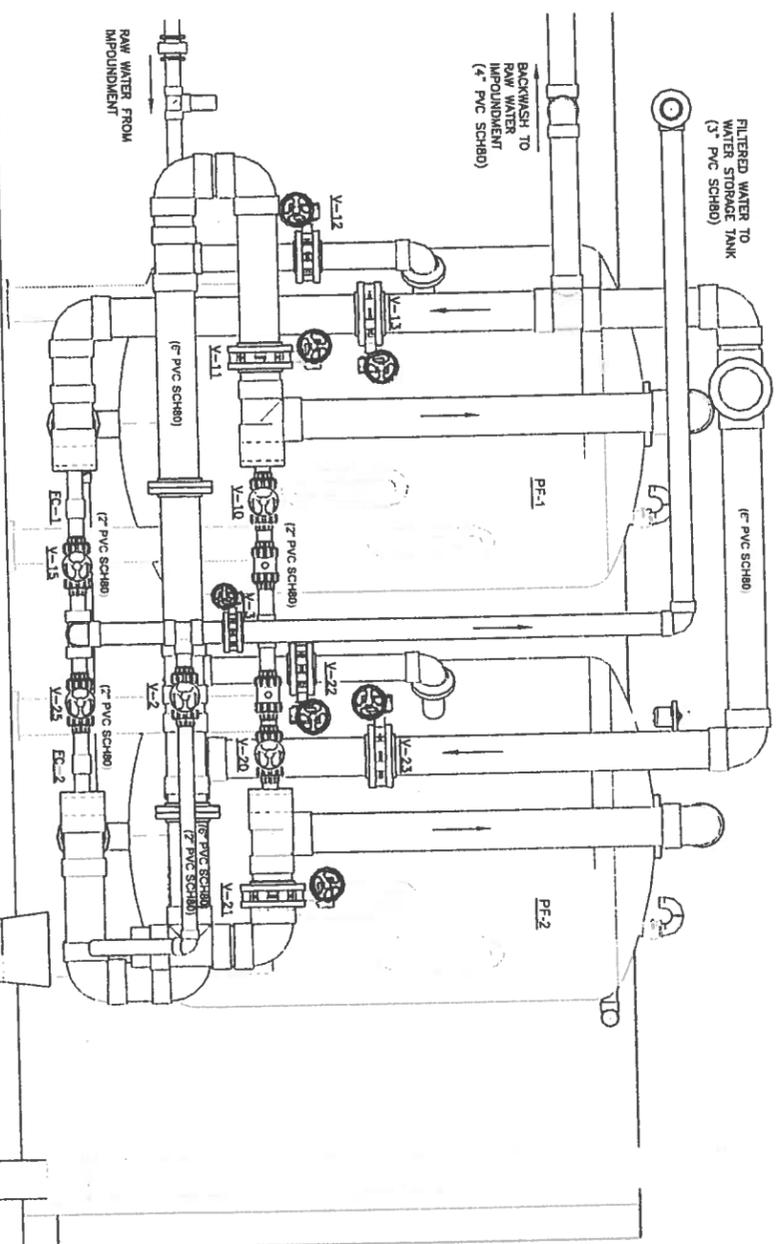

2 FILTER TANKS AND PIPING - FRONT ELEVATION
M2.2 SCALE 3/4" = 1'-0"

RECORD DRAWING
1-22-2013




Project No.	
Date	MAY 2010
Designed	LAP
Drawn	
Approved	LAP

REVISION	BY	DATE

CE₂
ENGINEERS, INC.
PO BOX 222946 ANCHORAGE, AK 99523 PH: 907-349-1010 FAX: 907-349-1015


2009 WATER SYSTEM UPGRADES
PRESSURE FILTER
PLAN AND ELEVATIONS
ATKA, ALASKA

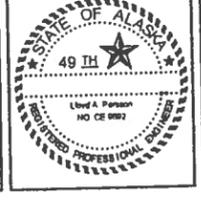



CONSTRUCTION RECORD	FIELD BOOK
STAKING	FOREMAN
AS-BUILT	INSPECTOR

SCALE:
AS SHOWN
1" = 10'
IF NOT ONE INCH ON THIS SHEET, SCALE IS ACCORDINGLY


RECORD DRAWING CERTIFICATE	
THESE DRAWINGS REFLECT RECORDED INFORMATION OBTAINED DURING CONSTRUCTION. INFORMATION PROVIDED HEREIN IS ACCURATE TO THE BEST OF MY KNOWLEDGE	
NAME	DATE

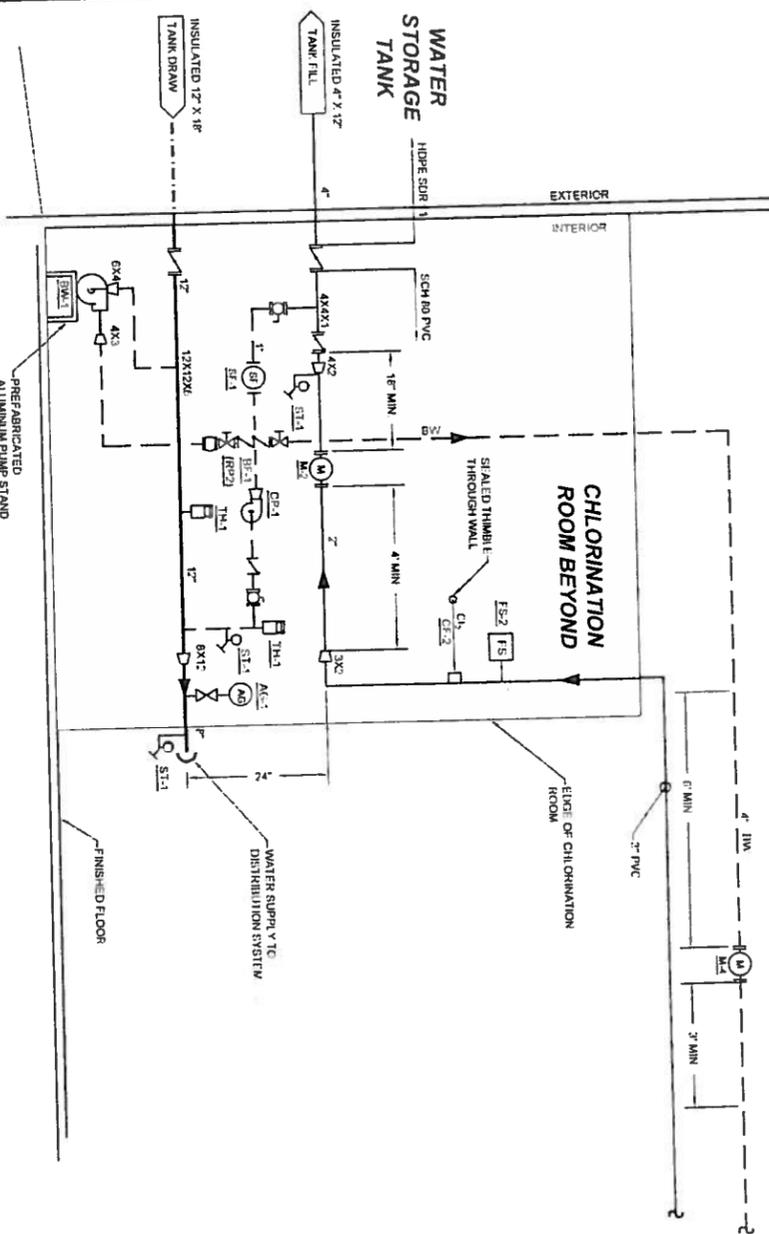


1 TANK FILL AND DRAW SCHEMATIC
M2.3 SCALE: NTS

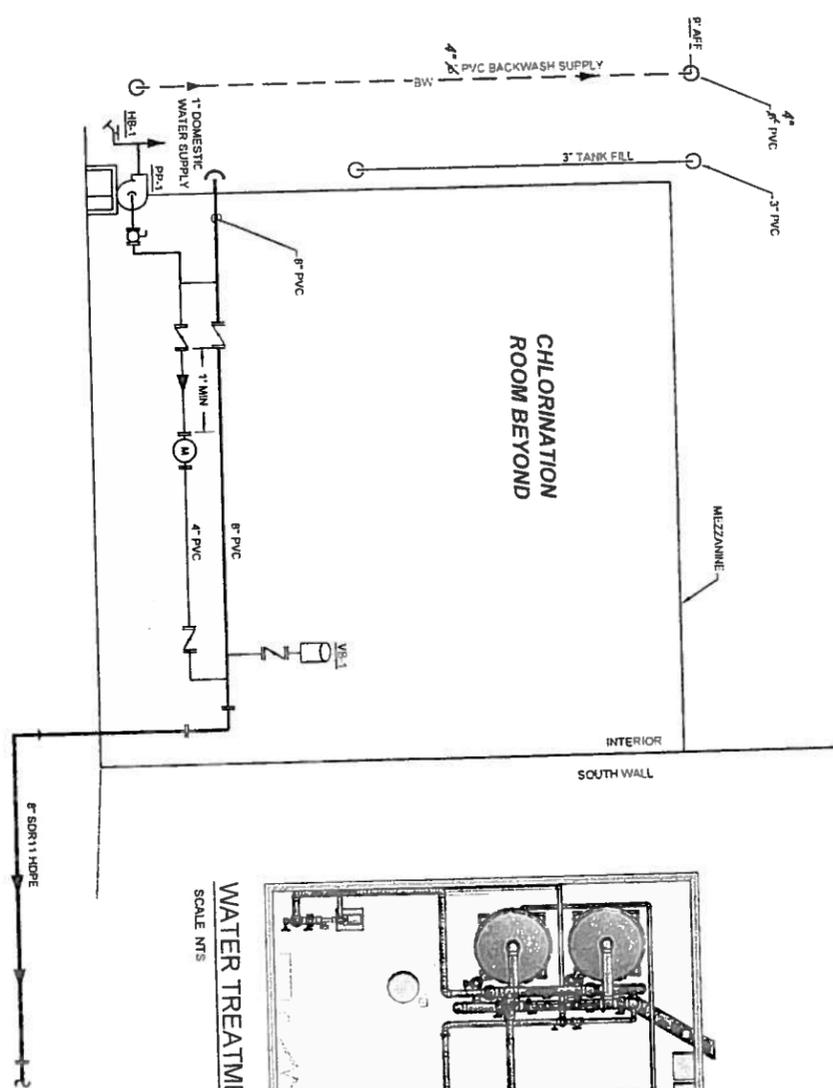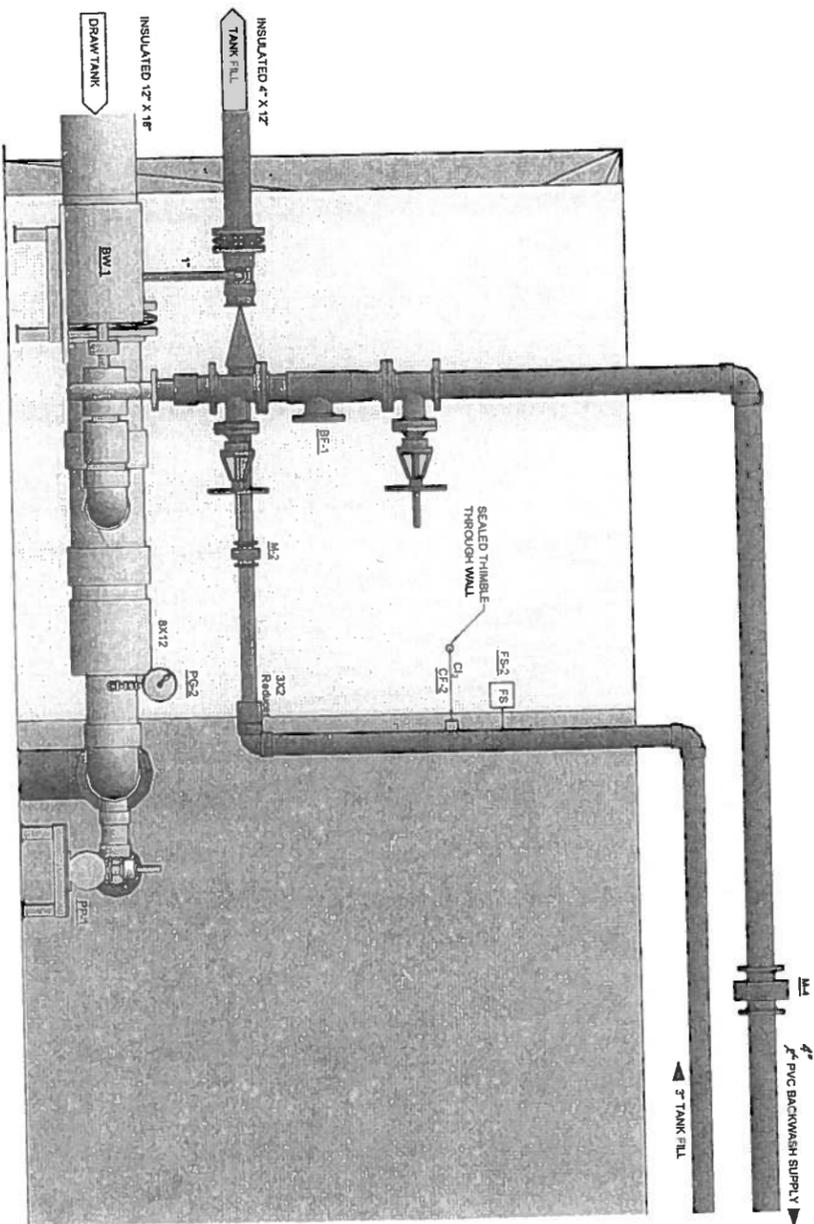

2 WATER OUT SCHEMATIC
M2.3 SCALE: NTS

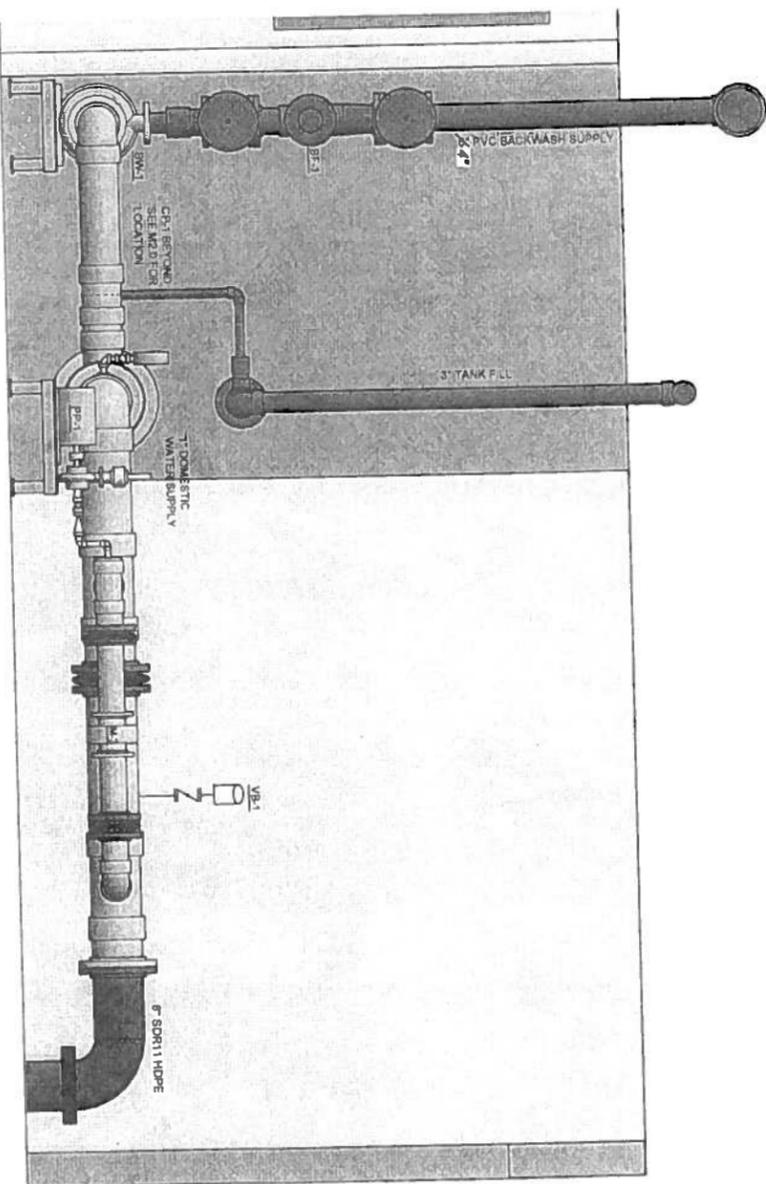


WATER TREATMENT PLANT DETAIL KEY
SCALE: NTS

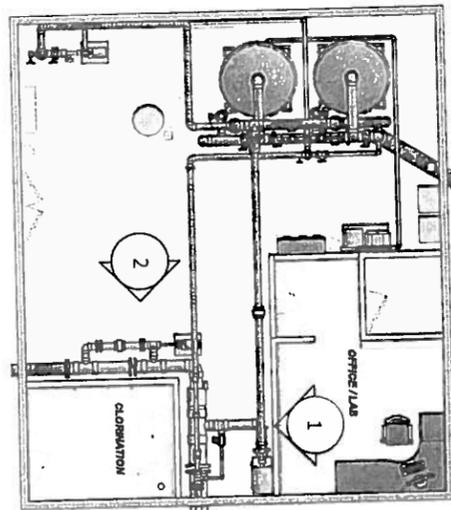

RECORD DRAWING
1-22-2013



2009 WATER SYSTEM UPGRADES
TANK FILL & DRAW
PROCESS SCHEMATICS
ATKA, ALASKA

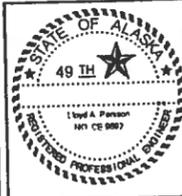

CONSTRUCTION RECORD	
FIELD BOOK	
STAKING	
FOREMAN	
AS-BUILT	
INSPECTOR	

SCALE: AS SHOWN
BAR IS ONE INCH ON ORIGINAL DRAWING
UP TO ONE INCH ON THIS SHEET AS SHOWN SCALES ACCORDINGLY


RECORD DRAWING CERTIFICATE	
THESE DRAWINGS REFLECT RECORDED INFORMATION OBTAINED DURING CONSTRUCTION INFORMATION PROVIDED HEREIN IS ACCURATE TO THE BEST OF MY KNOWLEDGE	
NAME	DATE




REVISION	BY	DATE

Project No.	
Date	MAY 2010
Designed	LAP
Drawn	
Approved	LAP
Sheet No.	M2.3

- NOTES:**
1. CALLOUTS IN HEXAGONS ARE DESCRIBED IN THE TABLE, DETAIL 2, THIS SHEET.
 2. MANWAYS "A" LOCATION 90° FOR PF-1 ONLY.
 3. MANWAYS "G" LOCATION 270° FOR PF-2 ONLY.

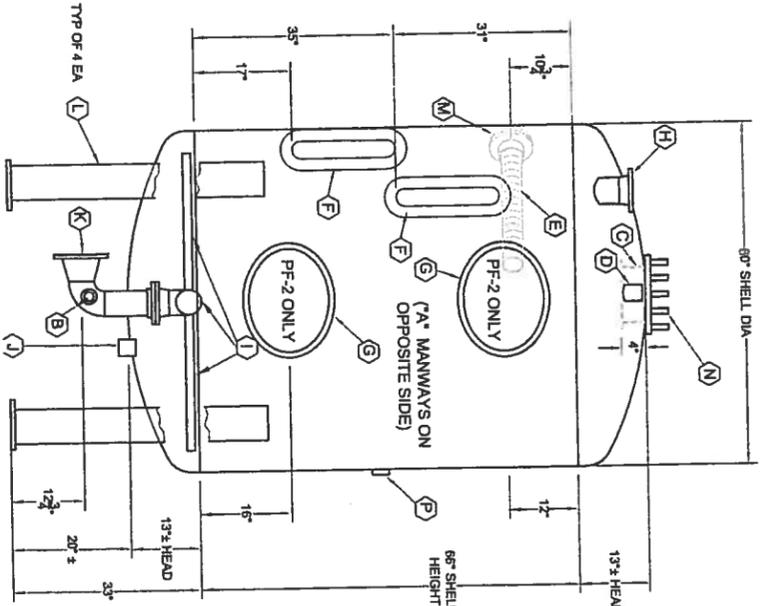

1 270° POSITION VIEW
M2.4 MULTI-MEDIA PRESSURE FILTER ELEVATION
 SCALE: 3/4"=1'-0"

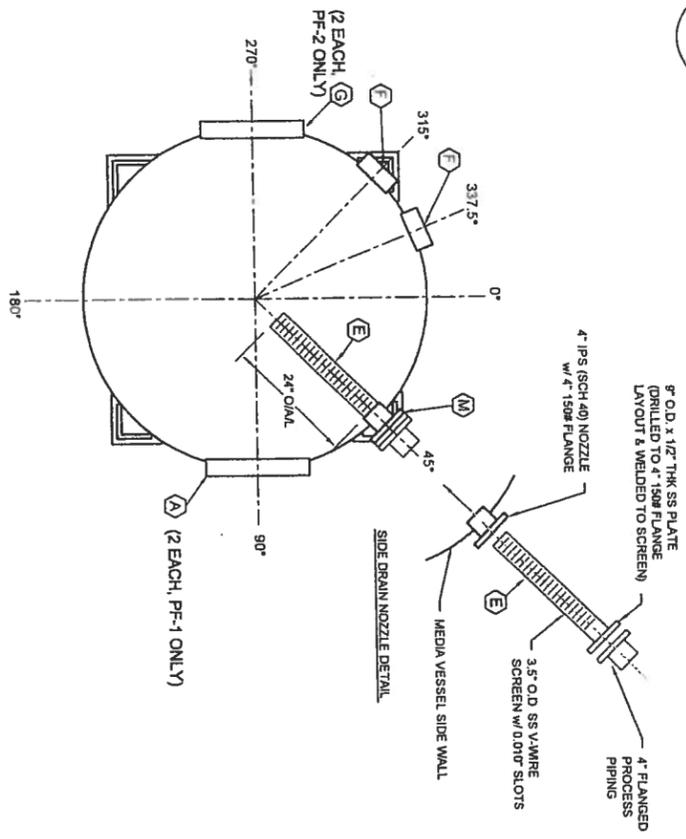


4 MULTI-MEDIA FILTER SHELL PLAN
M2.4 SCALE: 3/4"=1'-0"

NOTE:
 CALLOUTS IN HEXAGONS
 ARE DESCRIBED ABOVE


NOZZLE MARK	QUANTITY	SIZE	SERIES	LOCATION	DESCRIPTION
A	1	1 1/2" x 1/2"	100 PSI	90°	ELLIPTICAL MANWAY, 2" NOSE (PF-1 VESSEL ONLY)
B	2	2"	SCH 40	90°, 270°	2" SS THROATLET OR HALF-COUPLING BOTH SIDES
C	1	1 1/2" x 1/2" x 1/16"	304 SS		1 1/2" x 1 1/2" x 1/16" SPLASH PLATE AND STAND-OFF SUPPORTS
D	2	2" FIP1	304 SS	90°, 270°	2" SS HALF COUPLING
E	1	3 1/2" O.D. x 2 1/2" L	SS	45°	3 1/2" SS V-WIRE MEDIA SCREEN 0.018" SLOTS, ONE END CAPPED OTHER END WELDED 8" O.D. x 1 1/2" THK SS PLATE DRILLED TO 4" 150# FLANGE LAYOUT (PAPILLAS OR EQUAL)
F	1	3" W x 18" L	100 PSI SS	315°, 337.5°	3" SS V-WIRE MEDIA SCREEN 0.018" SLOTS, ONE END CAPPED OTHER END WELDED 8" O.D. x 1 1/2" THK SS PLATE DRILLED TO 4" 150# FLANGE LAYOUT (PAPILLAS OR EQUAL)
G	1	1 1/2" x 1 1/2"	100 PSI SS	270°	ELLIPTICAL MANWAY 2" NOSE (PF-2 VESSEL ONLY)
H	1	4"	304 SS	315°	4" Ø ILLUMINATION FIXTURE W/ HIGH DENSITY LAMP, PAPILLAS REX-HD W/ NW 80 TYPE 304 SS/TFE MOUNTING PAD
I	1	4" IPS	304 SS		304 SS UNDERDRAIN ASSY. HORIZONTAL, HEADER FOR RADIALS OR LATERALS, KEEP LATERALS WITHIN 6" O.C. SEE DETAIL 3 THIS SHEET
J	1	2" FIP1	304 SS	180°	STEEL THREADED COUPLING FOR BOTTOM DRAIN W/ V-WIRE SCREEN SEE DETAIL 3 THIS SHEET
K	1	6" IPS	304 SS	0°	BOTTOM PORT OUTLET, 6" SPL ON FLANGE, 8x4 REB. 4" LB WELD ELBOW WITH 2" SIDE AMOUNT HALF COUPLING ON EACH SIDE OF ELBOW FOR AIR SCOUR AND SAMPLING, SCH 40 PIPE NOZZLE, CONNECT TO UNDERDRAIN HUB INSIDE VESSEL, AS REQUIRED
L	1	AS REQD	304 SS	45°, 135°, 225°, 315°	VESSEL LEG, 1.58x1/2" OR W/REAM FOR SEMI-CONE 4" 6x3/8" 150# BASE PLATE W/ 1/2" DIA. BOLT HOLE IN CENTER OF PLATE (TYP OF ALLEYS)
M	1	4"	SCH 40 SS	45°	SIDE DRAIN NOZZLE, 2" PIPE W/ 150# SLIP-ON FLANGE (SEE "E" ABOVE FOR SCREEN ASSY)
N	1	6"	304 SS		6" TOP FLANGE AND 150# PATTERN W/ SS STUD BOLTS
P	1	5" W x 3" H		180°	VESSEL FABRICATORS AND ASME DATA PLATE(S) AS REQUIRED

2 MULTI-MEDIA PRESSURE FILTER PENETRATION SCHEDULE
M2.4 SCALE: NTS

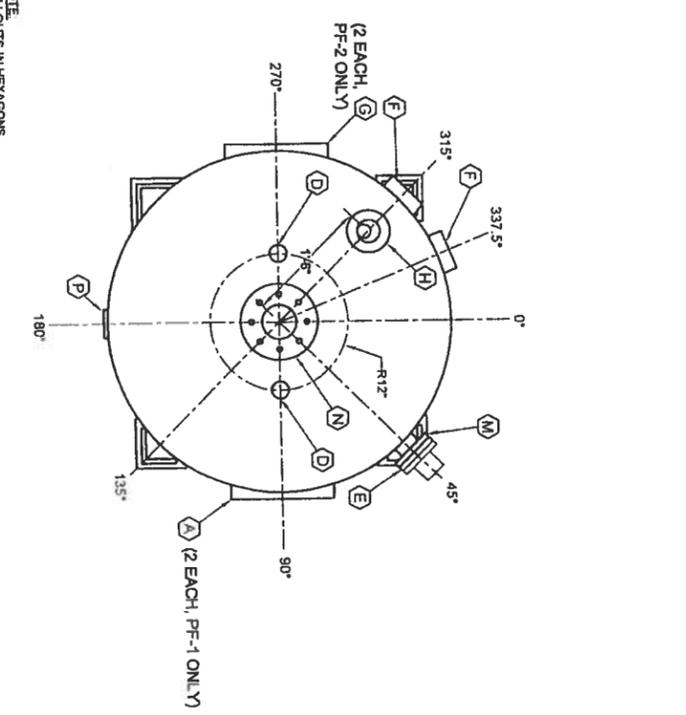


5 MULTI-MEDIA FILTER TOP HEAD PLAN
M2.4 SCALE: 3/4"=1'-0"

NOTE:
 CALLOUTS IN HEXAGONS
 ARE DESCRIBED ABOVE

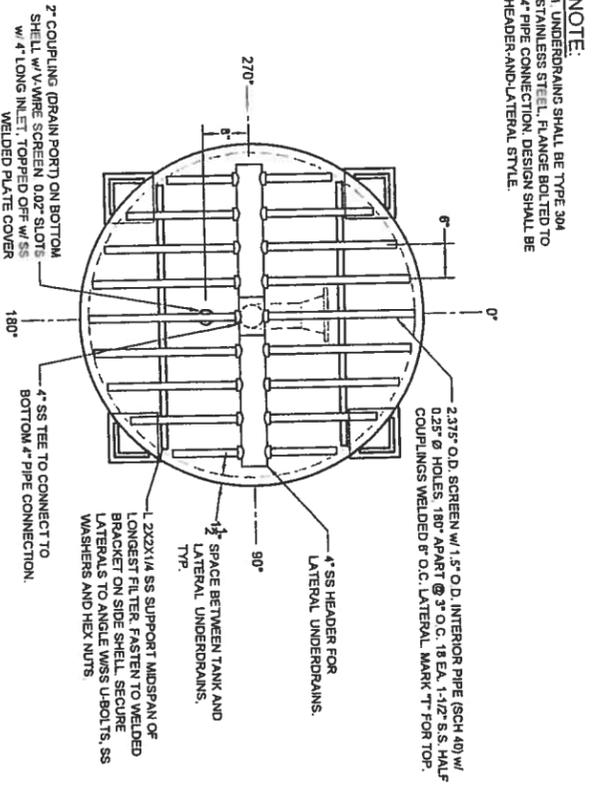

3 MULTI-MEDIA FILTER BOTTOM HEAD PLAN
M2.4 SCALE: 3/4"=1'-0"

NOTE:
 1. UNDERDRAINS SHALL BE TYPE 304 STAINLESS STEEL, FLANGE BORED TO 4" PIPE CONNECTION, DESIGN SHALL BE HEADER-AND-LATERAL STYLE.

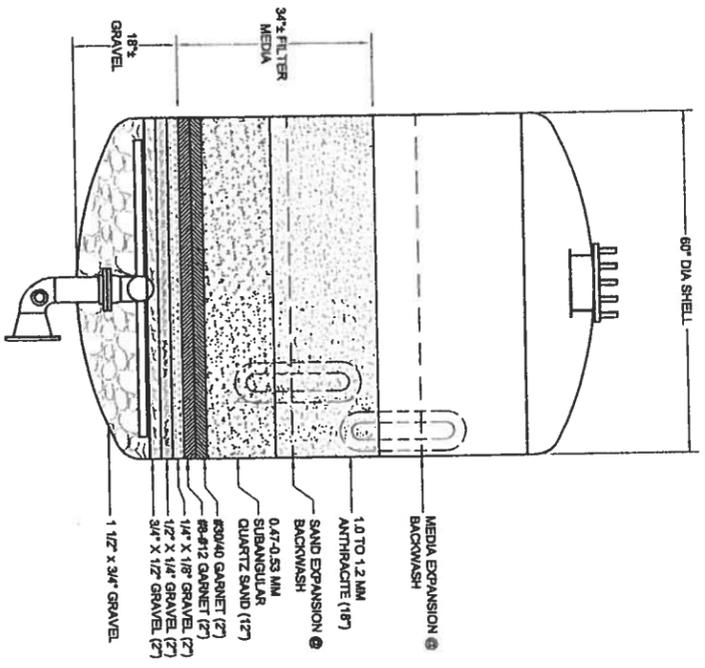

6 FILTER MEDIA & GRAVEL BED DETAILS
M2.4 SCALE: 3/4"=1'-0"

RECORD DRAWING
 1-22-2013


2009 WATER SYSTEM UPGRADES PRESSURE FILTER DETAILS & SECTIONS ATKA, ALASKA		CONSTRUCTION RECORD FIELD BOOK STAKING FOREMAN AS-BUILT INSPECTOR	SCALE: 1" = 1' (ON ORIGINAL DRAWING) 1/4" = 1' (ON THIS SHEET) ADJUST SCALES ACCORDINGLY	RECORD DRAWING CERTIFICATE THESE DRAWINGS REFLECT RECORDED INFORMATION OBTAINED DURING CONSTRUCTION. INFORMATION PROVIDED HEREIN IS ACCURATE TO THE BEST OF MY KNOWLEDGE. NAME: _____ DATE: _____
---	--	--	--	---

CE2 ENGINEERS, INC.
 PO BOX 22296 ANCHORAGE, AK 98223 PH: 877-343-1010 FAX: 877-343-1015

REVISION	BY	DATE

Project No. _____
 Date: **MAY 2010**
 Designed: **LAP**
 Drawn: **DDR**
 Approved: **LAP**



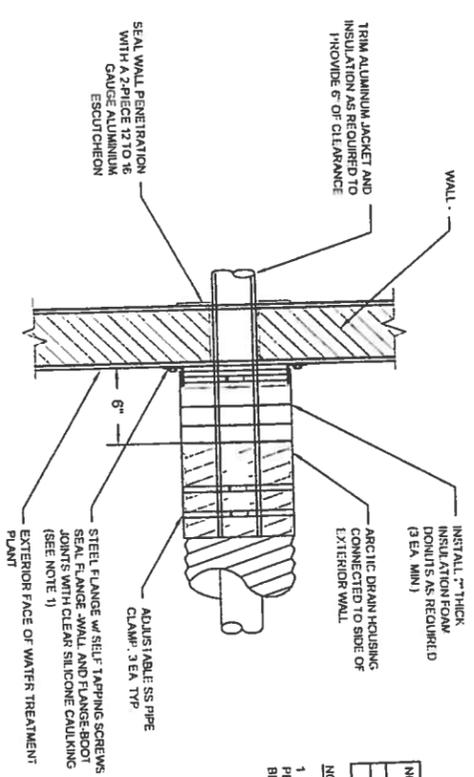

1 WALL PENETRATION DETAIL
M2.6 SCALE: NTS

NOMINAL OUTER JACKET SIZE	FLANGE ID	FLANGE OD
1 1/2"	1 1/8"	1 3/4"
1 3/4"	1 1/4"	1 7/8"
1 7/8"	1 1/2"	2 1/8"
2"	1 3/4"	2 1/4"

NOTES:
1. STEEL FLANGES AT PENETRATIONS, MAY NEED TO BE FIELD TRIMMED

SEAL WALL PENETRATION WITH A 2" PIECE OF 304 STAINLESS STEEL ESCUTCHEON


STEEL FLANGE W/ SELF TAPPING SCREWS JOINTS WITH CLEAR SILICONE CAULKING (SEE NOTE 1)
EXTERIOR FACE OF WATER TREATMENT PLANT

ADJUSTABLE SS PIPE CLAMP, 3 EA. TYP

ARCTIC DRAIN HOUSING CONNECTED TO SIDE OF EXTERIOR WALL

INSTALL 1/2" THICK INSULATION FROM DONUTS AS REQUIRED (3 EA. MIN)

TRIM ALUMINUM JACKET AND INSULATION AS REQUIRED TO PROVIDE 6" OF CLEARANCE

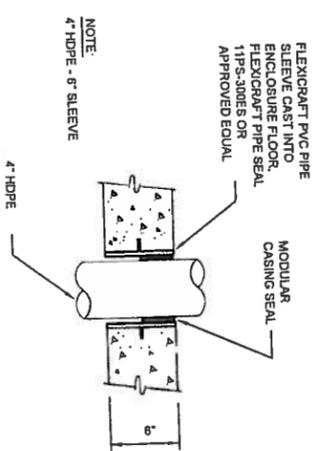

2 UNRESTRAINED FLOOR PENETRATION
M2.6 SCALE: NTS

NOTE:
4" HOPE - 6" SLEEVE

4" HOPE


4" HOPE

4" HOPE


4" HOPE

4" HOPE


NOTES:
1. ALL UNRESTRICT CHANNEL AND FITTINGS TYPE 304SS
2. POSTERIOR 1 1/2" X 1 1/4" L STAINLESS STEEL HEX BOLTS AND SS SPRING NUTS

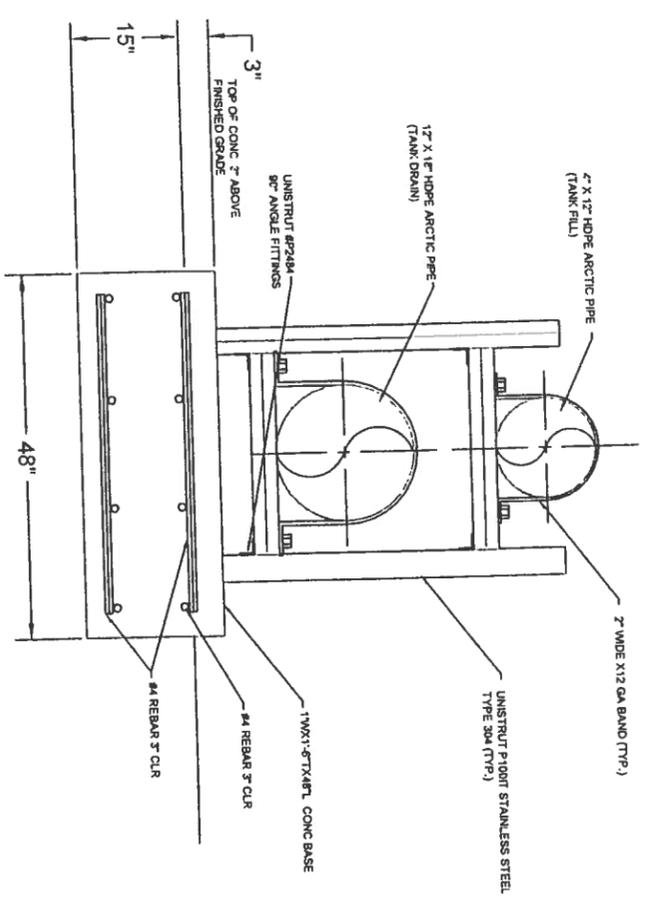


3 TANK TO BUILDING PIPE SUPPORT
M2.6 SCALE: NTS

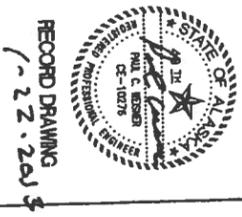

Project No. _____ Date <u>MAY 2010</u> Designed <u>LAP</u> Drawn <u>DDR</u> Approved <u>LAP</u>	REVISION BY DATE	 PO BOX 22246 ANCHORAGE, AK 99523 PH: 907-348-1010 FAX: 907-348-1015	2009 WATER SYSTEM UPGRADES DETAILS ATKA, ALASKA		CONSTRUCTION RECORD FIELD BOOK STAGING FOREMAN AS-BUILT INSPECTOR	SCALE: 1" = 3' ONE INCH ON ORIGINAL DRAWING IF NOT ONE INCH ON 24" SHEET USE AS USUAL SCALES ACCORDINGLY	RECORD DRAWING CERTIFICATE THESE DRAWINGS REFLECT RECORDED INFORMATION OBTAINED DURING CONSTRUCTION. INFORMATION PROVIDED HEREIN IS ACCURATE TO THE BEST OF MY KNOWLEDGE. NAME _____ DATE _____
	Sheet No. M2.6		 PO BOX 22246 ANCHORAGE, AK 99523 PH: 907-348-1010 FAX: 907-348-1015	2009 WATER SYSTEM UPGRADES DETAILS ATKA, ALASKA		CONSTRUCTION RECORD FIELD BOOK STAGING FOREMAN AS-BUILT INSPECTOR	SCALE: 1" = 3' ONE INCH ON ORIGINAL DRAWING IF NOT ONE INCH ON 24" SHEET USE AS USUAL SCALES ACCORDINGLY

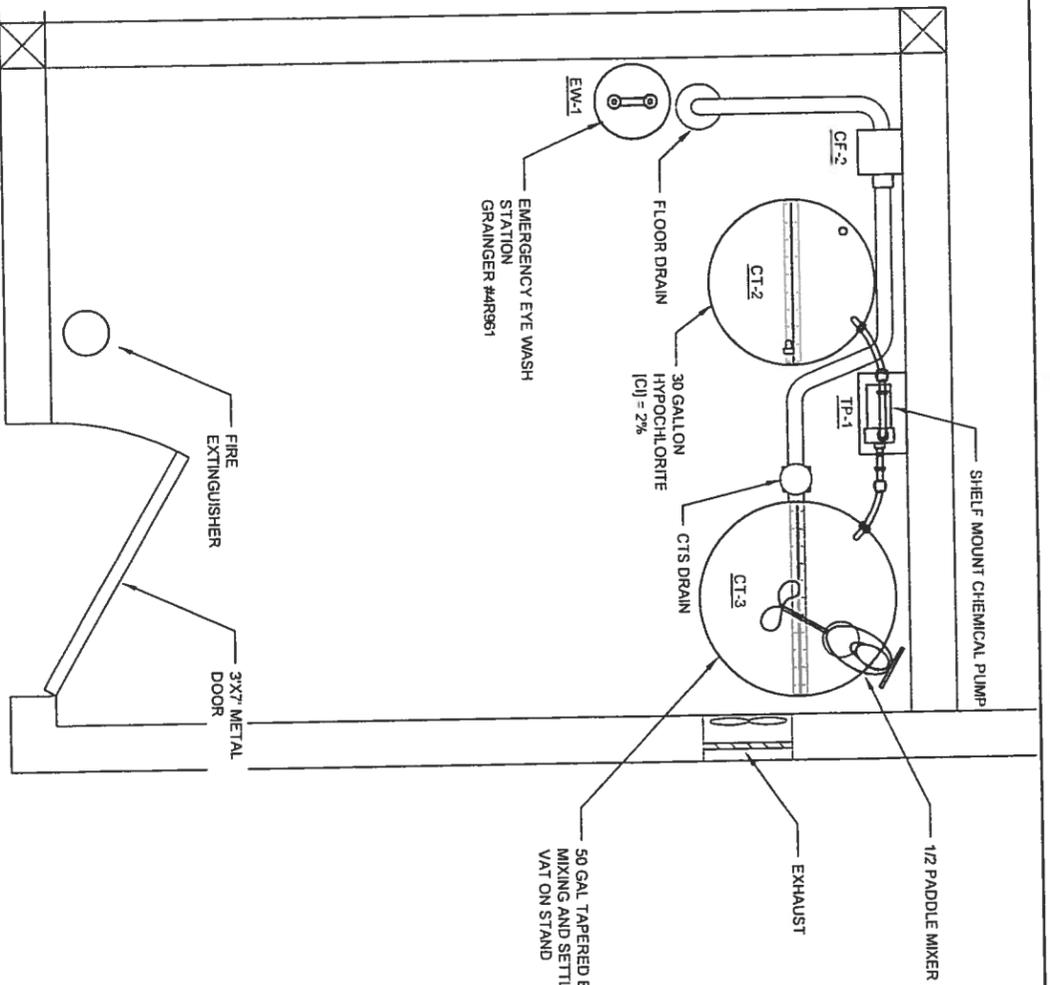

1 MECHANICAL PLAN CHLORINATION ROOM
M2.7 SCALE: 1" = 1'-0"

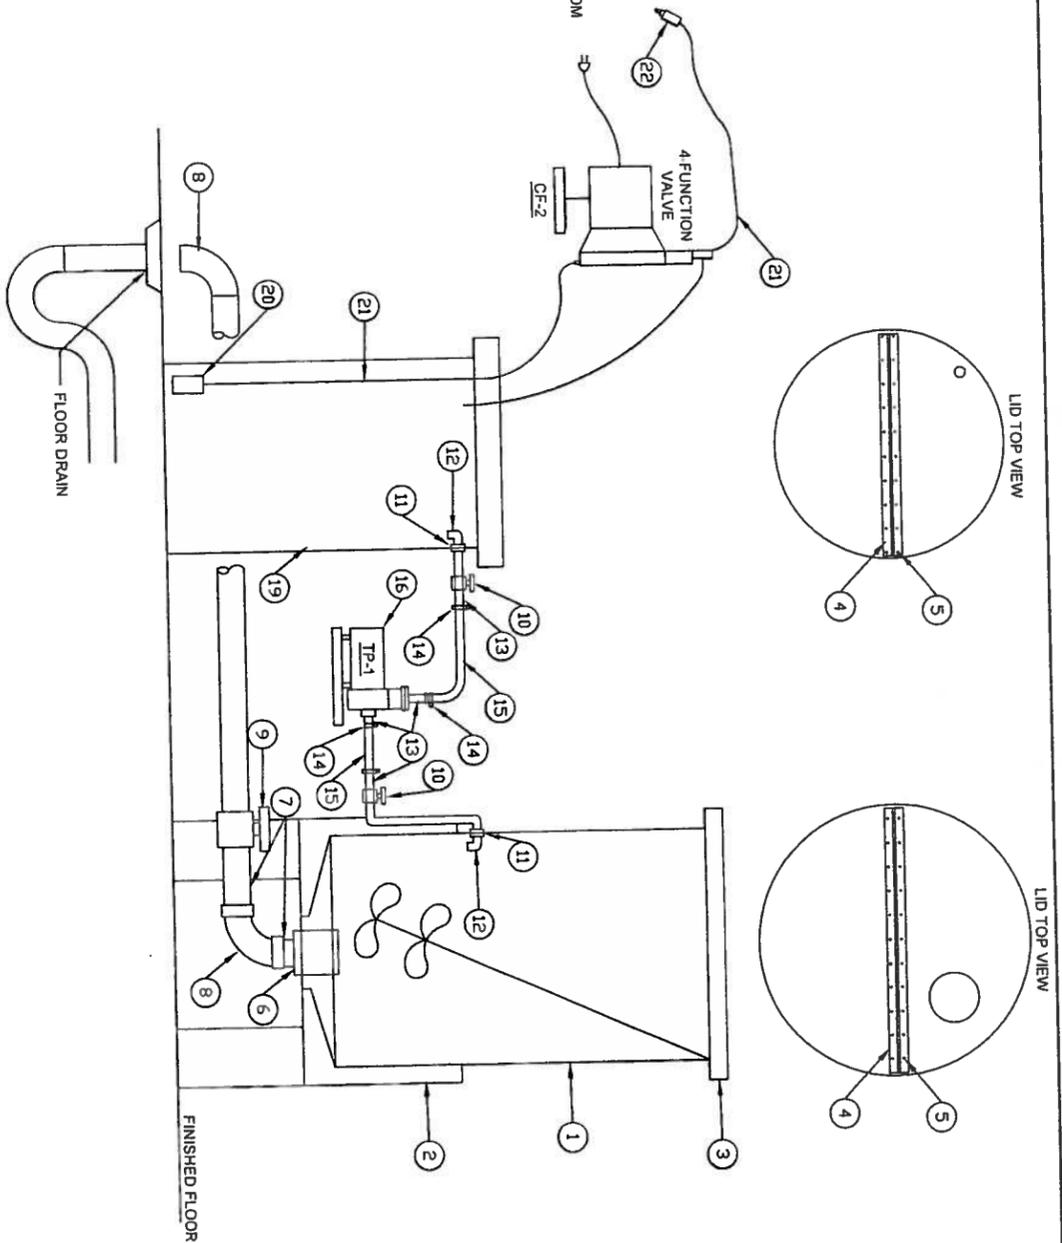

2 HYPOCHLORITE SOLUTION MIXING AND FEED
M2.7 SCALE: NTS

Callout	Description	Callout	Description
1	55 gal hypochlorite mixing tank, total drain, with lid, Snyder Industries P.N. 5790000N-1	13	3/4" PVC hose insert adaptor, mipt x insert, Spears #1436-007
2	Plastic tank stand 12" h for 22" dia total drain tank, Snyder Industries P.N. 1370000N	14	Type 316 stainless steel worm drive hose clamp, 7/8" to 1-1/4" ID, 1/2" wide, McMaster-Carr #45945K65
3	Tank lid for (1) above. Comes with tank	15	TYGON B-44-4X 1B TUBING 3/4 X 1", mfr Part #ADADA00053, Ryan Herco #0030.180
4	2" wide x 6' long PVC continuous hinge, McMaster-Carr #11195A45	16	Magnetic drive centrifugal pump, TE/Sub motor, 115V, 115VAC, 1/20 hp, 2 amps, 1/2" mipt discharge x 3/4" fipt suction, March Manufacturing model LC-3CP-MD
5	1/4-20x3/4" PVC capscrew, fully threaded, McMaster-Carr #94806A029 (pkg of 25)	17	Sch 80 PVC reducer coupling assembly, 3/4" fipt x 1/2" fipt, consisting of Spears #830-007 3/4" fipt coupling and Spears #839-101 3/4" x 1/2" flush bushing
6	Total bottom drain fitting, 2" FIPF, Viton gaskets, Snyder Industries P.N. 341146	18	not used
7	2" sch 80 pvc pipe, glue or thread as req'd	19	30 gallon vertical polyethylene open top tank with lid, Snyder Industries #10001VOT with lid
8	2" sch 80 PVC 90 deg el, soc x soc, Spears #806-020	20	Check valve and weight assembly for 1/4" OD chemical feed tubing. Comes with CF-2 chemical feed pump as part of a kit
9	2" PVC full union ball valve, soc or thread fittings inc., Viton O-ring, Spears #2339-020	21	1/4" OD chemical feed tubing. Comes with CF-2 chemical feed pump as part of a kit
10	3/4" PVC full union ball valve, soc or thread fittings inc., Viton O-ring, Spears #2339-007	22	1/2" tubing injector quill and check valve, 1/2" mipt, comes with CF-2 chemical feed pump as part of a kit
11	3/4" PVC tank adaptor soc x soc with viton gasket, Spears #8170-007		
12	3/4" PVC sch 80 90 deg el, soc x soc, Spears #806-007, with short length of 3/4" sch 80 pvc pipe connecting to tank adaptor		

RECORD DRAWING
1-22-2013

Project No.	
Date	MAY 2010
Designed	LAP
Drawn	LAW
Approved	LAP
Sheet No.	M2.7

REVISION	BY	DATE

CE2 ENGINEERS, INC.
PO BOX 22296 ANCHORAGE, AK 99523 PH: 807-343-1310 FAX: 807-343-1815

2009 WATER SYSTEM UPGRADES


MECHANICAL CHLORINATION ROOM AND DETAILS

ATKA, ALASKA

CONSTRUCTION RECORD	FIELD BOOK
STAKING	
FOREMAN	
AS-BUILT	
INSPECTOR	

SCALE:	BAR IS ONE INCH ON ORIGINAL DRAWING
	IF NOT ONE INCH ON THIS SHEET, REFER TO SCALE AS ACCORDING

RECORD DRAWING CERTIFICATE	
THESE DRAWINGS REFLECT RECORDED INFORMATION OBTAINED DURING CONSTRUCTION INFORMATION PROVIDED HEREIN IS ACCURATE TO THE BEST OF MY KNOWLEDGE	
NAME	DATE

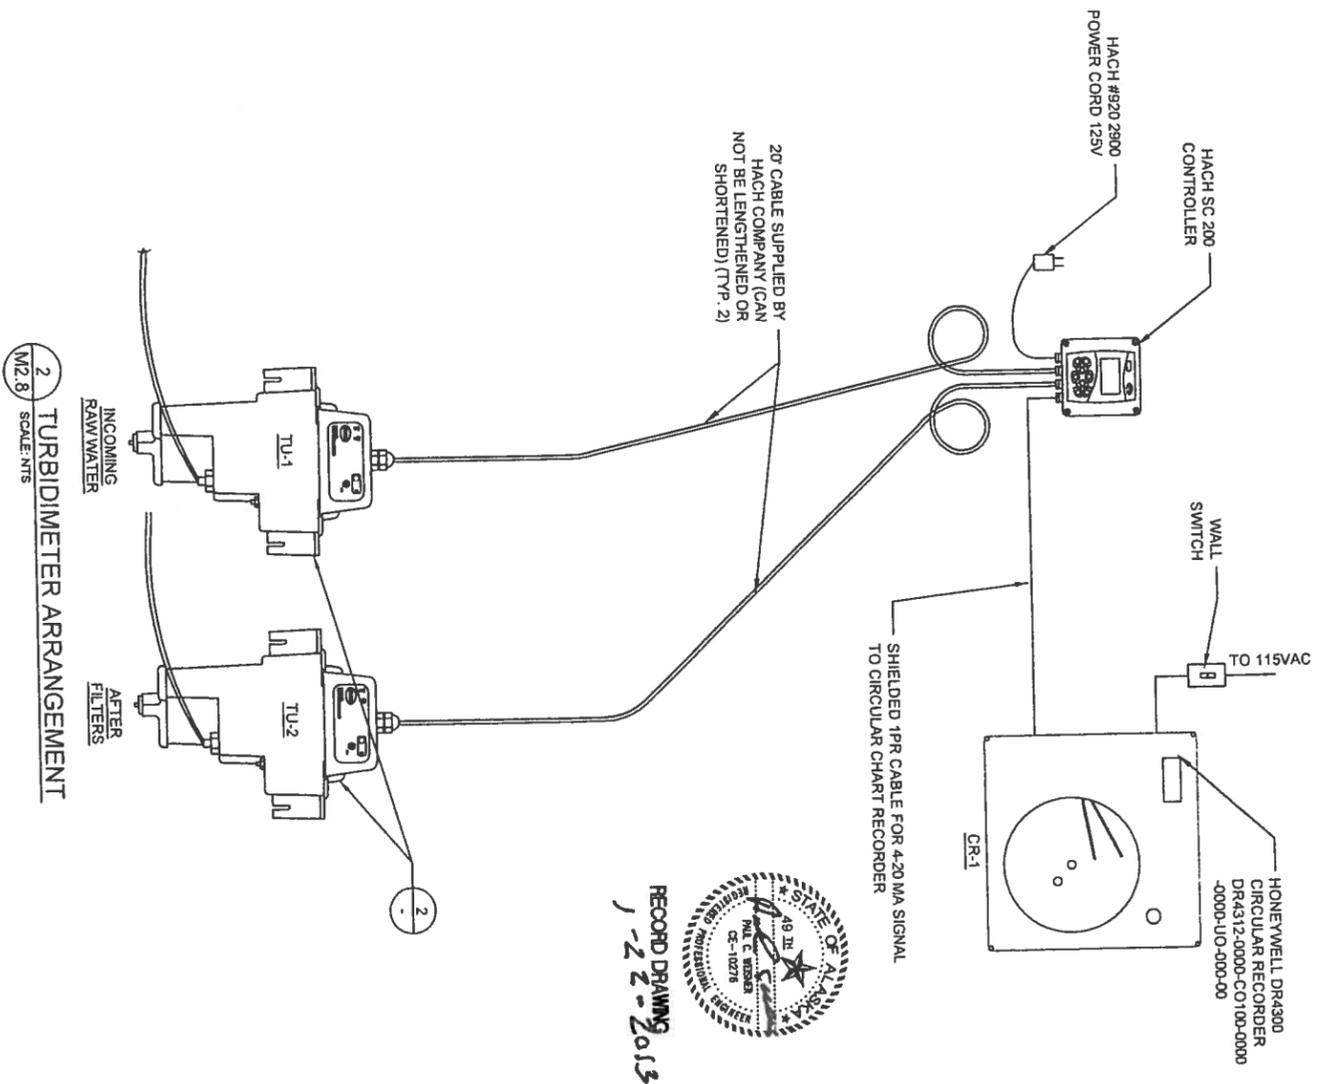

RECORD DRAWING
1-22-2013


2 TURBIDIMETER ARRANGEMENT
SCALE: M2.8

NOTES:

THIS SYSTEM WILL HAVE 2 TURBIDITY READINGS, (RAW WATER AND FINISHED WATER) AND ONE FOR EACH TURBIDITY READING TO CIRCULAR CHART RECORDER. THE SC200 CONTROLLER POWERS AND RECORDS DATA FROM THE TURBIDIMETERS AND SENDS A 4-20 MA ANALOG SIGNAL TO THE CIRCULAR CHART RECORDER.

- 1 HACH SC200 CONTROLLER - 2 INPUTS / 2 EA 4-20MA OUTPUTS
- 2-1720E HACH TURBIDIMETER
- 1- HONEYWELL DR4300 CIRCULAR RECORDER - 2 EA 4 MA INPUTS

Project No. Date <u>MAY 2010</u> Designed <u>LAP</u> Drawn <u>LAW</u> Approved <u>LAP</u>	REVISION BY DATE	 PO BOX 232948 ANCHORAGE, AK 99523 PH: 877-348-1010 FAX: 877-348-1015	2009 WATER SYSTEM UPGRADES MECHANICAL TURBIDIMETER ARRANGEMENT ATKA, ALASKA		CONSTRUCTION RECORD FIELD BOOK STAGING FOREMAN AS-BUILT INSPECTOR	SCALE: 1" = 10'-0" IF NOT ONE INCH ON ORIGINAL DRAWING SCALE IS ACCORDING	RECORD DRAWING CERTIFICATE THESE DRAWINGS REFLECT RECORDED INFORMATION OBTAINED DURING CONSTRUCTION. INFORMATION PROVIDED HEREIN IS ACCURATE TO THE BEST OF MY KNOWLEDGE. NAME _____ DATE _____
	Sheet No. M2.8				CONSTRUCTION RECORD FIELD BOOK STAGING FOREMAN AS-BUILT INSPECTOR	SCALE: 1" = 10'-0" IF NOT ONE INCH ON ORIGINAL DRAWING SCALE IS ACCORDING	RECORD DRAWING CERTIFICATE THESE DRAWINGS REFLECT RECORDED INFORMATION OBTAINED DURING CONSTRUCTION. INFORMATION PROVIDED HEREIN IS ACCURATE TO THE BEST OF MY KNOWLEDGE. NAME _____ DATE _____

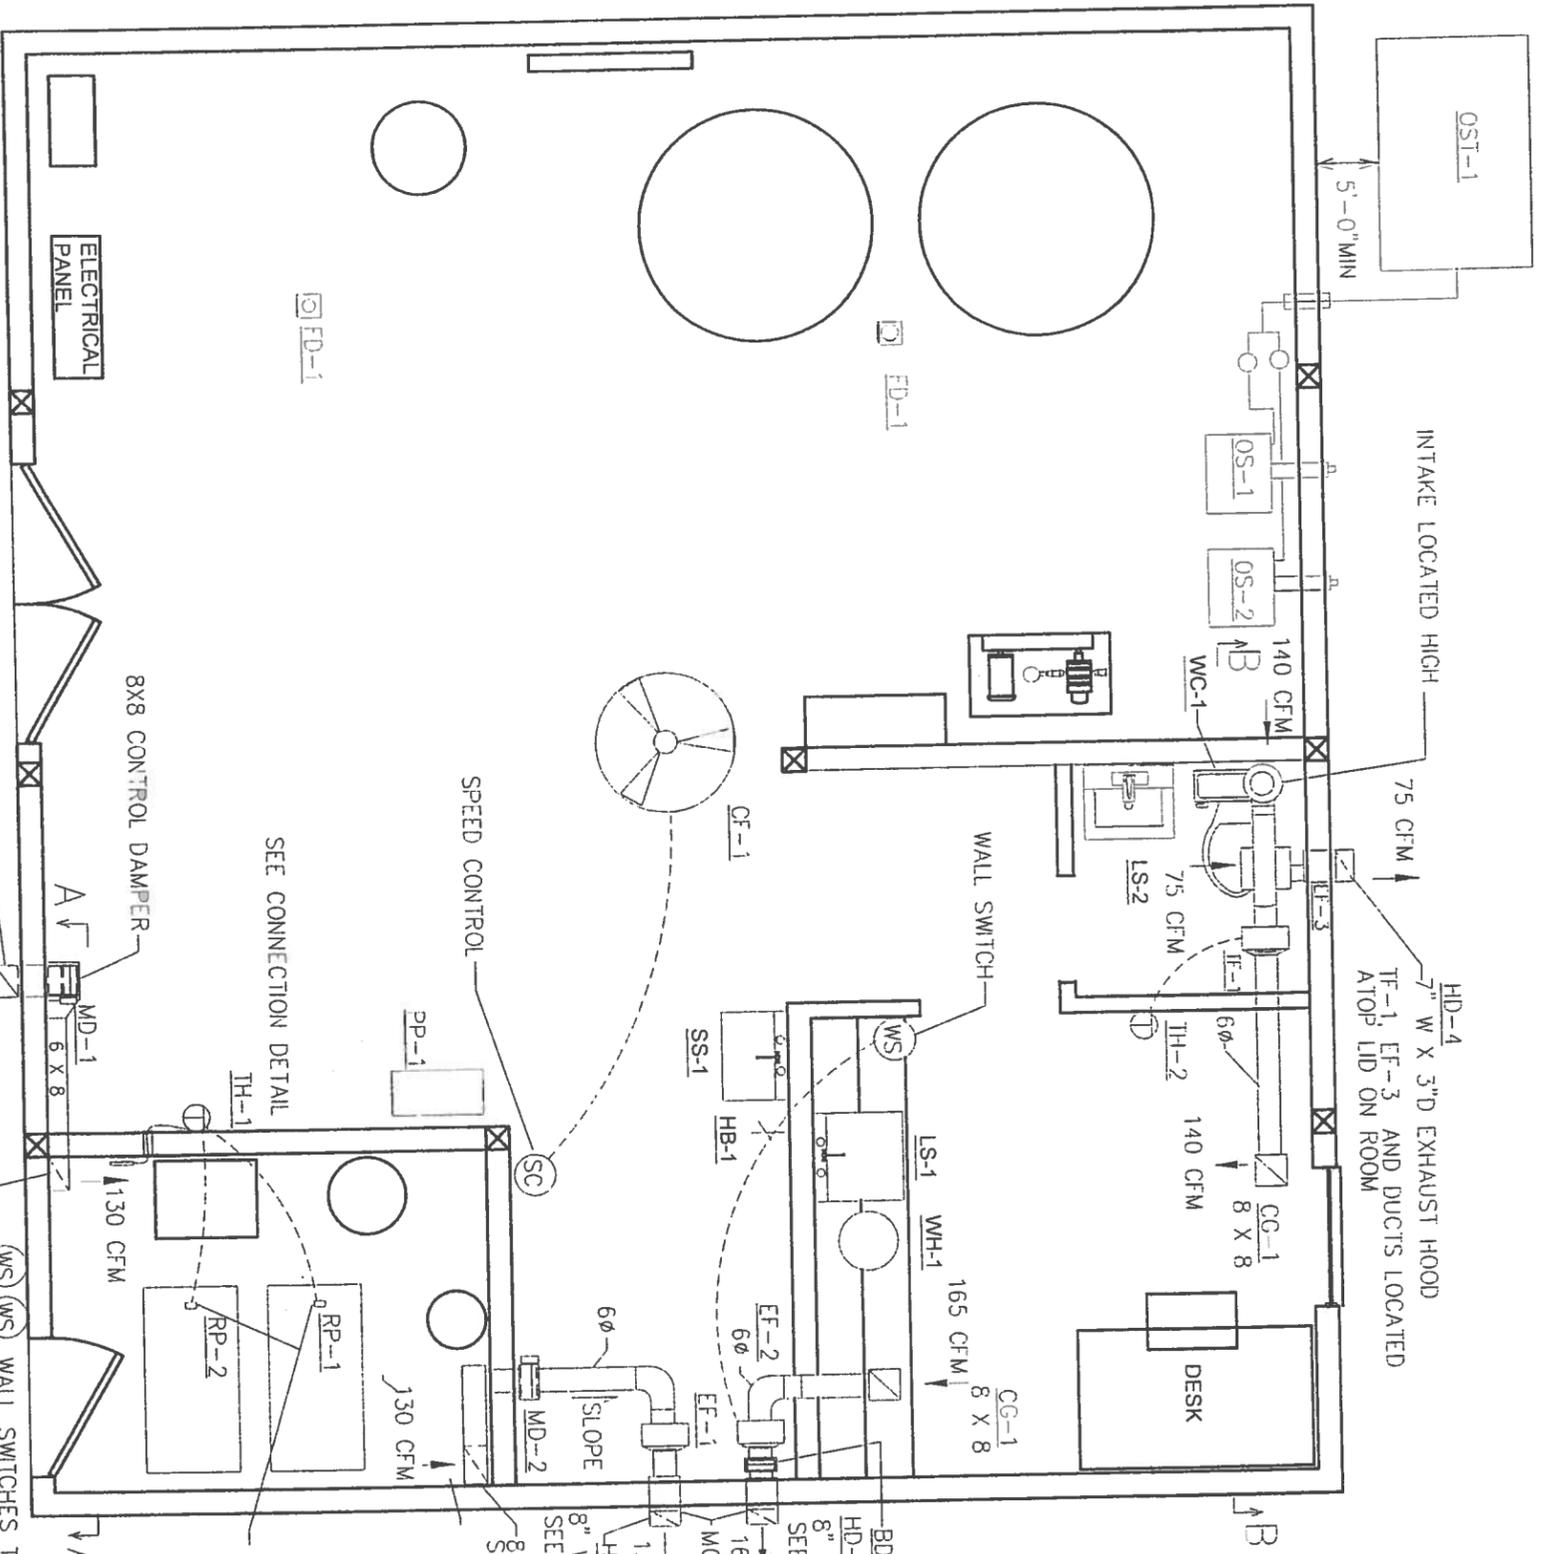

ATKA WATER PLANT HVAC AND PLG PLAN

SCALE: 1/4" = 1'-0"

EF-1, MD-1, MD-2 OPERATION: EF-1, MD-1, MD-2 ARE INTERLOCKED. WHEN WALL SWITCH OUTSIDE CHLORINATOR ROOM IS SET TO "ON", EF-1 STARTS AND MD-1, MD-2 OPEN TO FULL OPEN. SWITCH ACTIVATES FLASHING RED LIGHT (LABELED "UNSAFE TO ENTER"). LIGHT IS ON FOR 3 MINUTES TO PURGE AREA AND AT THE END OF THE 3 MINUTE TIME A GREEN LIGHT (LABELED "SAFE TO ENTER") IS ILLUMINATED. WHEN OPERATOR LEAVES WORK AREA THE SWITCH IS SET TO "OFF" AND EF-1 STOPS, MD-1, MD-2 DAMPERS CLOSE.

- MD-1 MOTORIZED DAMPER. 8" WIDE X 8" HIGH. LOW LEAKAGE. BELIMO LF120 DAMPER MOTOR. 120 V 5.5 WATTS 35 IN LB OR EQ
 - MD-2 MOTORIZED DAMPER. 8" WIDE X 8" HIGH. LOW LEAKAGE. BELIMO LF120 DAMPER MOTOR. 120 V 5.5 WATTS 35 IN LB OR EQ
 - BDD-1 WEIGHTED BACKDRAFT DAMPER. 8" WIDE X 8" HIGH. MFG: RUSKIN CBD-2 DAMPER OR EQUAL
 - EF-1 EXHAUST FAN: INLINE TYPE, DIRECT DRIVE. 130 CFM @ 0.4 IN W.C. MOUNTING BRACKET, SPEED CONTROL, WORM DRIVE CLAMPS, FLEX PIPE FOR CONNECTIONS, CORROSION RESISTANT MFG: FANTECH (GRAINGER) FR150.67 AMPS/115V/1 PH OR EQUAL
 - EF-2 EXHAUST FAN: INLINE TYPE, DIRECT DRIVE. 165 CFM @ 0.4 IN W.C. MOUNTING BRACKET, SPEED CONTROL, WORM DRIVE CLAMPS, FLEX PIPE FOR CONNECTIONS, CORROSION RESISTANT MFG: FANTECH (GRAINGER) FR150.67 AMPS/115V/1 PH OR EQUAL
 - TF-1 EXHAUST FAN: INLINE TYPE, DIRECT DRIVE. 140 CFM @ 0.25 IN W.C. MOUNTING BRACKET, SPEED CONTROL, WORM DRIVE CLAMPS, FLEX PIPE FOR CONNECTIONS, CORROSION RESISTANT MFG: FANTECH (GRAINGER) FR150.67 AMPS/115V/1 PH OR EQUAL
 - TH-1 THERMOSTAT: REMOTE BULB THERMOSTAT. 0-100 F RANGE, 3-10 F DIFFERENTIAL. WITH CAPILLARY, WALL BRACKET, AND BULB. MFG: HONEYWELL F675A1045 OR EQUAL 8.0 AFL/120 V / 1 PH
 - TH-2 THERMOSTAT: WALL TYPE LINE VOLTAGE THERMOSTAT 44F TO 86 F RANGE. HEATING ONLY MFG: HONEYWELL T4S1A3005 OR EQUAL
 - CF-1 CEILING FAN: 36 INCH DIAMETER CEILING FAN WITH SPEED CONTROL. MFG: LEADING EDGE 36201 WITH 12003 SPEED CONTROL 1 AMP / 120 V / 1 PH OR EQUAL
 - OS-1, OS-2: OIL STOVE. SELF CONTAINED UNIT. 22,000 BTUH OUTPUT. 90 % EFFICIENCY. SELF CONTAINED WITH BUILT IN CONTROL 275 WATTS / 120 V / 1 PH OR EQUAL MFG: TOYOTOMI OM-22 OR EQUAL
 - CG-1 CEILING GRILLE: 8 X 8 BAR GRILLE. NO VOLUME DAMPER MFG: SHOEMAKER 901 OR EQUAL
- SEQUENCE OF OPERATION:
- RP-1, RP-2 CYCLE ON TH-1 SET POINT 60 F
 - TF-1 CYCLES ON TH-2. SET POINT ADJUSTIBLE
 - FAN MOVES WARM AIR FROM ROOF TO OFFICE/LAB
 - CF-1 OPERATES CONTINUOUSLY. CONTROLLED BY SPEED CONTROL.
 - EF-2 OPERATES ON WALL SWITCH
 - OS-1, OS-2 OIL STOVES OPERATE ON INTEGRAL CONTROLS

HVAC AND PLUMBING PLAN
ATKA WATER PLANT
ATKA, ALASKA



CAPSTONE ENGINEERING LLC
MECHANICAL ENGINEERS
12110 BUSINESS BLVD STE 6 PMB 169
EAGLE RIVER, ALASKA 99577
TELEPHONE & FAX 541-884-8065

DRAWN: F.H. BELTZ
MARCH 4, 2011
SCALE: AS NOTED
JAN 16, 2013
REVISED AS BUILT
JOB NO. C376
SHEET NO. M4.1

PLUMBING FIXTURE	WASTE	VENT	CW	HW	DESCRIPTION
WC-1	3"	2"	1/2"	-	FLOOR MOUNT TANK TYPE 1.6 GPF
LS-1	1 1/2"	1 1/4"	1/2"	1/2"	WALL MOUNT LAVATORY-
FD-1	2	1 1/2"	-	-	FLOOR DRAIN
WH-1	2"	1 1/2"	1/2"	1/2"	TANK TYPE 4 GALLON ELECTRIC HEATER
SS-1	2"	1 1/2"	1/2"	1/2"	FLOOR MOUNT LAUNDRY SINK
LS-1	2"	1 1/2"	1/2"	1/2"	COUNTER MOUNTED LAB SINK
HB-1			1/2"		INDOOR HOSE BIB
EW-1	1 1/2"	1 1/4"	1/2"	1/2"	EYE WASH UNIT-WITH TEMPERED WATER VALVE

PLUMBING FIXTURES

WC-1: WATER CLOSET: FLOOR MOUNT, FLUSH TANK 1.6 GPM PER FLUSH COMFORT HEIGHT, OPEN FRONT SOLID PLASTIC SEAT W/METAL HINGES
 MFG: AM STD CADET OR EQUAL WHITE COLOR

LS-2: LAVATORY: WALL MOUNT, 4 INCH FAUCET MOUNTING, CAST IRON, SINGLE LEVER MIXING FAUCET, WHITE COLOR SINK
 MFG: AM STD REGALYN W/ DELTA SINGLE LEVER HANDLE FAUCET OR EQUAL-

WH-1: WATER HEATER: 4 GALLON TANK TYPE HEATER. 1500 WATT / 120 V / 1 PH
 MFG: ARISTON GLATI (GRAINGER 4UJ90) OR EQUAL

SS-1: SERVICE SINK: FLOOR MOUNT MOLDED STONE TYPE SINK, SINGLE BASIN
 MFG: FLAT FL-1 WITH LEGS AND DELTA SINGLE LEVER KITCHEN FAUCET OR EQUAL


LS-1: LAB COUNTER SINK: COUNTER MOUNTED, 18 GA STAINLESS STEEL SINK, SINGLE BASIN, BASIN IS APPROX 18 W X 16 FR X 9" DEEP. FAUCET IS GOOSENECK MIXING FAUCET 4" C-C MOUNTING
 MFG: JUST, ELKAY OR APPROVED EQUAL

HB-1: HOSE BIB: INDOOR TYPE FOR COLD WATER, WHEEL HANDLE TYPE

FD-1: MEDIUM DUTY CAST IRON FLOOR DRAIN. NICKEL FINISH COVER. MFG SMITH 2005 OR EQUAL

PLUMBING MATERIALS

POTABLE WATER PIPING: TYPE L COPPER, NO LEAD SOLDER, WROUGHT FITTINGS.
 INSULATE HW LINES 1/2" CLOSED CELL FOAM
 WASTE AND VENT: ABS
 WATER STOPS: WHEEL HANDLE TYPE
 WATER SUPPLIES: FLEXIBLE WITH PLATING
 PIPE HANGERS: SEE PROCESS SPECIFICATIONS

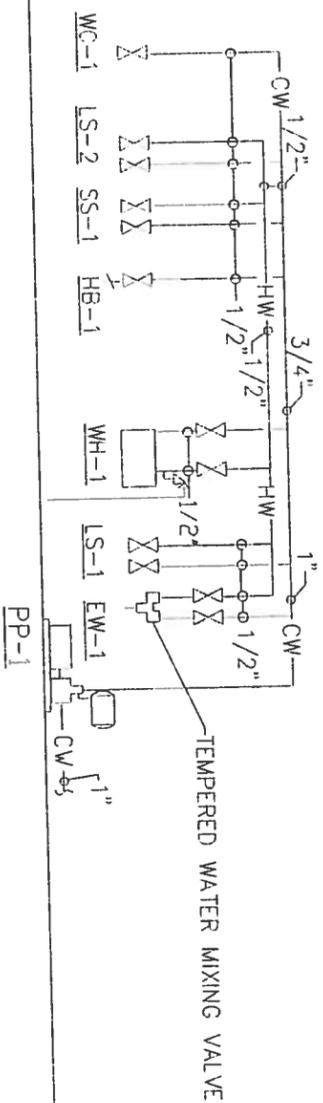

WATER PLANT LOCAL WATER DISTRIBUTION

NO SCALE

PLUMBING DETAILS
 ATKA WATER PLANT
 ATKA, ALASKA



CAPSTONE ENGINEERING LLC
 MECHANICAL ENGINEERS
 12110 BUSINESS BLVD STE 6 PHB 169
 EAGLE RIVER, ALASKA 99577
 TELEPHONE & FAX 541-684-8065

MARCH 4, 2011
 DRAWN: F.A. BELZ
 SCALE: AS NOTED
 JAN 16, 2013
 REVISED: AS BUILT
 JOB NO: A-3375
 SHEET NO: M4.3

REF. OR TAG NO.	EQUIPMENT DESCRIPTION	LOCATION	MANUFACTURER'S SPECIFICATION	SETPPOINT
AIR BLOWERS AB-1	AIR BLOWER, 60 SCFM AT 8.5 PSIG, WITH SELF-CONTAINED AIR INTAKE AND FILTER, MUFFLER, 208 VAC, 3-PH MOTOR	NEAR PRESSURE FILTER PF-1	UNIMAC SERIES 3M	8.5 PSI OR BEST SETTING TO GIVE GOOD AGITATION OF FILTER MEDIA DURING AIR SCOUR
AIR RELEASE, AUTOMATIC AV-1	AIR/VACUUM VALVE FOR RELEASE OF AIR TRAPPED, 1" FPT INLET AND OUTLET, OPERATION PRESSURE BELOW 150 PSI	ON TOP OF PRESSURE FILTERS PF-1 AND PF-2	NETAFIM 2" COMBINATION AIR AND VACUUM RELIEF AIR VENT WITH CONTINUOUS ACTING AIR VENT	N/A
AV-2	AIR/VACUUM VALVE FOR RELEASE OF AIR TRAPPED, 4" FPT INLET AND OUTLET, OPERATION PRESSURE BELOW 150 PSI	ON WATERMAIN BEFORE IT EXITS THE WTP BUILDING	NETAFIM 2" COMBINATION AIR AND VACUUM RELIEF AIR VENT WITH CONTINUOUS ACTING AIR VENT	N/A
BACKFLOW PREVENTERS BF-1	BACKFLOW PREVENTER, DOUBLE CHECK VALVE ASSEMBLY, 4" 300 SERIES STAINLESS STEEL, 175 PSI, 33-10°F	BACKWASH WATER LINE DOWNSTREAM OF BACKWASH PUMP BF-1	WATTS SERIES 774 (MODEL #774-47) WITH ISOLATION GATE VALVES AND TESTING PORTS	N/A
CHEMICAL FEED PUMPS, EQUIPMENT CF-1	ELECTRONIC CHEMICAL FEED PUMP, CAPABLE OF 1.00 GPH 3/8" OD TUBING CONNECTIONS, 120 VAC, MANUAL OR ANALOG 4-20 MA OPERATION	IN AREA OF WATER TREATMENT PLANT BETWEEN BF-1 AND PF-1	LMI SERIES AA ELECTRONIC METERING PUMP, PVC WET ENDS, MODEL #AA951-450H	AS REQD TO ACHIEVE PROPER COAGULANT FEED, APPROXIMATELY 3 PPM
CF-2	ELECTRONIC CHEMICAL FEED PUMP, CAPABLE OF 1.00 GPH 3/8" OD TUBING CONNECTIONS, 120 VAC, MANUAL OR ANALOG 4-20 MA OPERATION	IN AREA OF WATER TREATMENT PLANT BETWEEN BF-1 AND PF-2	LMI SERIES AA ELECTRONIC METERING PUMP, PVC WET ENDS, MODEL #AA951-450H	AS REQD TO ACHIEVE PROPER HYPOCHLORITE FEED, APPROXIMATELY 1 PPM
CONTROL VALVES CV-1	FLOW CONTROL VALVE, RUBBER VARIABLE ORIFICE SIZE TYPE, 2" FPT CONNECTIONS, 20 GPM RATED	BETWEEN PRESSURE FILTERS	DOLE VALVE 2" CONNECTIONS 20 GPM	FIXED AT 20 GPM
CV-2	FLOW CONTROL VALVE, RUBBER VARIABLE ORIFICE SIZE TYPE, 2" FPT CONNECTIONS, 20 GPM RATED	BETWEEN PRESSURE FILTERS	DOLE VALVE 2" CONNECTIONS 20 GPM	FIXED AT 20 GPM
FLOW METERS, TOTALIZERS, CONTROLLERS, M-1	FLOWMETER, MAGNETIC TYPE, 2" FLANGES SENSOR WITH REMOTE MOUNTED ELECTRONICS AND READOUT	RAW WATER PIPING IN WATER TREATMENT ROOM	ENDRESS + HAUSER 50W, 2" FLANGED	N/A
M-2	FLOWMETER, BRONZE, TURBINE 4-100 GPM THROUGH 2" PVC PIPE, WITH BRONZE STRAINER	FILTERED WATER PIPING IN WATER TREATMENT ROOM	NEPTUNE BRONZE HIGH PERFORMANCE TURBINE METER, 2" WITH STRAINER, CALIBRATED IN US GALLONS, OVAL FLANGES, DIRECT READING BRONZE BOX AND COVER	N/A
M-3	FLOWMETER, BRONZE, TURBINE 4-500 GPM THROUGH 4" PIPE, WITH BRONZE STRAINER	WATER MAIN EXITING WTP BUILDING TO TOWN	NEPTUNE BRONZE HIGH PERFORMANCE TURBINE METER, 4" WITH STRAINER, CALIBRATED IN US GALLONS, OVAL FLANGES, DIRECT READING BRONZE BOX AND COVER	N/A
M-4	FLOWMETER, MAGNETIC TYPE, 4" FLANGES SENSOR WITH REMOTE MOUNTED ELECTRONICS AND READOUT	BACKWASH WATER LINE DOWNSTREAM OF DOUBLE CHECK VALVE BW-1	ENDRESS + HAUSER 50W, 4" FLANGED	N/A
FLOW SWITCH FS-1	FLOW SWITCH, ELECTRONIC, USING HEATER & TEMPERATURE SENSING FOR FLOW (0.01 TO 0.5/SEC), 3/4" MPT CONNECTION, 115 VAC, 2" INSERTION LENGTH	RAW WATER PIPING IN WATER TREATMENT ROOM	FLUID COMPONENTS INTERNATIONAL (FCI) MODEL FL793B-AB00	UPPER END OF RANGE ABOUT 0.5 FT/SEC
FS-2	FLOW SWITCH, ELECTRONIC, USING HEATER & TEMPERATURE SENSING FOR FLOW (0.01 TO 0.5/SEC), 3/4" MPT CONNECTION, 115 VAC, 2" INSERTION LENGTH	FILTERED WATER PIPING IN WATER TREATMENT ROOM	FLUID COMPONENTS INTERNATIONAL (FCI) MODEL FL93B-AB00	UPPER END OF RANGE ABOUT 0.5 FT/SEC
HVAC BDD-1	WEIGHTED BACKDRAFT DAMPER 8"W X 8"H	ON TOP OF LAB CEILING LID ABOVE COUNTER	RUSKIN CBD-2 OR EQUAL	N/A
FC-1	CEILING FAN, 36" DIAMETER WITH SPEED CONTROL	CENTER OF CEILING OF WATER PLANT ROOM	LEADING EDGE 36201 WITH 12003 SPEED CONTROL, 1A, 120V, 1 PH OR EQUAL	SPEED AS DESIRED BY OPERATOR
EF-1	EXHAUST FAN, INLINE TYPE DIRECT DRIVE, 130 CFM @ 0.4" WC, MOUNTING BRACKET, SPEED CONTROL, WORM DRIVE CLAMPS, FLEX PIPE FOR CONNECTIONS, CORROSION RESISTANT	ON CEILING LID ABOVE CHLORINE ROOM	FANTECH (GRAINGER) FR150, 0.67 AMPS/115V/1PH OR EQUAL	N/A
EF-2	EXHAUST FAN, INLINE TYPE DIRECT DRIVE, 165 CFM @ 0.4" WC, MOUNTING BRACKET, SPEED CONTROL, WORM DRIVE CLAMPS, FLEX PIPE FOR CONNECTIONS, CORROSION RESISTANT	ON CEILING LID ABOVE LAB ROOM	FANTECH (GRAINGER) FR150, 0.67 AMPS/115V/1PH OR EQUAL	N/A
EF-3	EXHAUST FAN, INLINE TYPE, CEILING TYPE BATH FAN 75 CFM @ 0.35 IN WC, SPEED CONTROL	ON CEILING OF LAB BATHROOM	GREENHECK SP-8110, 1.1 AMPS/115VAC/1 PH OR EQUAL	N/A
MD-1	MOTORIZED DAMPER, 8"W X 8"H, LOW LEAKAGE, 2-POSITION DAMPER, SPRING RETURN	ON OUTSIDE WALL BETWEEN ENTRANCE AND CHLORINE ROOM	RUSKIN CD-50 OR EQUAL, BELIMO LF120 DAMPER MOTOR, 120 VAC 5.5W 35 IN-LB OR EQUAL	N/C
MD-2	MOTORIZED DAMPER, 8"W X 8"H, LOW LEAKAGE, 2-POSITION DAMPER, SPRING RETURN	ON EXHAUST DUCT ABOVE CEILING OF CHLORINE ROOM	RUSKIN CD-50 OR EQUAL, BELIMO LF120 DAMPER MOTOR, 120 VAC 5.5W 35 IN-LB OR EQUAL	N/C
OS-1, OS-2	OIL HEATER, SELF-CONTAINED UNIT, 22,000 BTU/HR OUTPUT, 90% EFFICIENCY, BUILT-IN TEMPERATURE CONTROL, 275 WATTS/20V/1 PH	OUTSIDE WALL OF WATER TREATMENT ROOM NEAR FILTERS	TOYOTOMI OM-22 OR EQUAL	65F ON OS-1 AND 60F ON OS-2 INITIAL SETTING
RP-1, RP-2	RADIANT PANEL HEATERS, 375 WATTS, 24X40 WITH SURFACE MOUNTING BRACKET	CEILING IN CHLORINE ROOM	MARLEY AT12442 WITH SURFACE MOUNTINGS BRACKET, 375WATTS/115V/1 PH	50F
TF-1	EXHAUST FAN, INLINE TYPE DIRECT DRIVE, 140 CFM @ 0.4" WC, MOUNTING BRACKET, SPEED CONTROL, WORM DRIVE CLAMPS, FLEX PIPE FOR CONNECTIONS, CORROSION RESISTANT	ON CEILING LID ABOVE LAB BATHROOM	FANTECH (GRAINGER) FR150, 0.67 AMPS/115V/1PH OR EQUAL	N/A
TS-1	REMOTE BULB THERMOSTAT, 0-100°F RANGE, 3-10°F DIFFERENTIAL WITH CAPILLARY, WALL BRACKET, AND BULB	ON WATER PLANT SIDE OF CHLORINE ROOM WALL	HONEYWELL F875A10A5 OR EQUAL, 8 FLA, 120V, 1 PH OR EQUAL	50F INITIAL
TS-2	THERMOSTAT, WALL TYPE, LINE VOLTAGE, 44F TO 86F RANGE, HEATING ONLY	ON LAB WALL	HONEYWELL T451A3005 OR EQUAL	AS DESIRED BY OPERATOR

RECORD DRAWING
1-2-2-2-013



Project No. _____
Date MAY 2010
Designed LAP
Drawn _____
Approved LAP

REVISION	BY	DATE



2009 WATER SYSTEM UPGRADES
EQUIPMENT LIST
ATKA, ALASKA



CONSTRUCTION RECORD	
FIELD BOOK	
STAKING	
FOREMAN AS BUILT	
INSPECTOR	

SCALE: AS SHOWN
BAR IS ONE INCH ON ORIGINAL DRAWING
IF NOT ONE INCH ON THIS SHEET, PLEASE SCALE ACCORDINGLY

RECORD DRAWING CERTIFICATE	
THESE DRAWINGS REFLECT RECORDED INFORMATION OBTAINED DURING CONSTRUCTION. INFORMATION PROVIDED HEREIN IS ACCURATE TO THE BEST OF KNOWLEDGE.	
NAME	DATE

REF. OR TAG NO.	EQUIPMENT DESCRIPTION	LOCATION	MANUFACTURER'S SPECIFICATION	NOTES
INSTRUMENTATION				
CR-1	CIRCULAR CHART RECORDER, 10" DIAMETER CHARTS, 2 PEN, 4-20 MA INPUT FROM TURBIDIMETERS, 120VAC POWERED	IN INSTRUMENTATION AREA NEAR PRESSURE FILTERS	HONEYWELL DR4900 SERIES DIGITAL CHART RECORDER MODEL #DR4312-0000-C0100-0000-00-000-00	N/A
SCD-1	STREAMING CURRENT DETECTOR, 4-20 MA OUTPUT, WITH AUTOMATIC JETWASH	WATER TREATMENT PLANT NEAR CF-1	MILTON ROY SC5200 WITH AUTOMATIC JET WASHER AND INLET CYCLONE SEPARATOR	DETERMINED BY JAR TESTING
TU-1, TU-2	TURBIDIMETER, INCANDESCENT NEPHELOMETER, WITH CONTROLLER TO HANDLE TWO TURBIDIMETERS	NEAR PRESSURE FILTERS	TWO EACH FILTER 1720E NEPHELOMETER AND ONE SC200 CONTROLLER WITH 4 20MA OUTPUT TO CIRCULAR CHART RECORDER CR-1	N/A
VFD MOTOR CONTROLS				
MC-AB1	7.5 HP SOFT START, 208 VAC 3 PH, NEMA 12 ENCLOSURE	MAIN WATER TREATMENT AREA, LOWER FLOOR, NEAR AB-1 AND PRESSURE FILTERS	ALLEN-BRADLEY POWER FLEX 70	N/A
MC-BW1	10 HP SOFT START, 208 VAC 3 PH, NEMA 12 ENCLOSURE	MAIN WATER TREATMENT AREA, LOWER FLOOR, NEAR BW-1	ALLEN-BRADLEY POWER FLEX 70	N/A
PRESSURE FILTERS				
PF-1	MULTIMEDIA PRESSURE FILTER	WATER TREATMENT AREA	FOR CONSTRUCTION DETAILS SEE SHEET M2.4	N/A
PF-2	MULTIMEDIA PRESSURE FILTER	WATER TREATMENT AREA	FOR CONSTRUCTION DETAILS SEE SHEET M2.4	N/A
PRESSURE GAUGES				
DP-1 DP2	DIFFERENTIAL PRESSURE GAUGE, 4 1/2" DIA FACE, 1/4" NPT PORTING IN LINE, AUX SWITCH, PANEL MOUNTED, 150 PSIG RATED, 0-10 PSID, AIR BLEEDING FITTINGS	NEXT TO PRESSURE FILTER PF-2 ON WALL, DP-1 MONITORS PF-1 AND DP-2 MONITORS PF-2	ORANGE RESEARCH #1203PSS-5-F-C-4.5-F-A-10, CONDUIT CONNECTION, WIKI TYPE 23X-34, CATALOG #9834826	10 PSID ON AUXILIARY SWITCH
PG-1	PROCESS PRESSURE GAUGE, THERMOPLASTIC CASE, 4-1/2" DIAMETER FACE, 0-60 PSIG, SILICONE FILLED, SS WETTED INTERNALS, 1/2" NPT BOTTOM PIPING CONNECTION	WATER TREATMENT AREA ON 8" PVC PIPE GOING OUT TO COMMUNITY	USA BLUE BOOK CATALOG #ME-85075	N/A
PG-2	GAGE FOR MONITORING THE DEPTH OF WATER IN WATER STORAGE TANK WT-1, 6" DIAMETER FACE, 0-19.999, 0-36 FT. ALTITUDE, MANUAL SET HAND, 1/4" NPT BOTTOM PIPING CONNECTION, USA BLUE BOOK CATALOG #ME-85075			
PUMPS, CIRCULATING, BACKWASH, EFFLUENT, PRESSURE, SEWAGE, TRANSFER, ETC.				
BP-1	5-STAGE CENTRIFUGAL PUMP, 40 GPM @ 60 TDH, STAINLESS STEEL HOUSING, 2" 300# FLANGE SUCTION AND DISCHARGE, 1.0 HP 1750 RPM 208V 3 PHASE	NEAR RAW WATER OUTLET IN WATER TREATMENT PLANT	5 STAGE STAINLESS CENTRIFUGAL PUMP GOULDS 155VCF8F60 1750RPM PREMIUM EFFICIENCY TERC MOTOR, 208 V 3 PH	N/A
BW-1	END SUCTION, CLOSE COUPLED CENTRIFUGAL PUMP, STAINLESS STEEL, 4" FLG SUCTION X 3" FLG DISCH, 208 V 3-PH, 1750 RPM TERC MOTOR, 10 HP, 300 GPM @ 60' TDH	ON SUPPLY PIPING IN WTP OUT OF WATER TANK WT-1	GAL CODE 23SH-52C Q23SH, 3 X 4.8 WITH 10 HP 1750 TERC 208 VAC 3-PH MOTOR AND SIZE D B-7/16" DIA IMPELLER	100 GPM SLOW FILL UP TO 300 GPM BACKWASH
CF-1	IN LINE CENTRIFUGAL PUMP, BRONZE, 3/4" SWEAT CONNECTIONS, 9.5 GPM @ 6' TDH, 80 WATTS, 115 VAC	NEAR AREA WHERE PIPING LEAVES WTP AND GOES TO WATER TANK WT-1	GRUNDFOS MODEL #UP-15-1887	9.5 GPM
PP-1	END SUCTION PRESSURE PUMP WITH INTEGRAL PRESSURE TANK, STAINLESS AND THERMOPLASTIC CONSTRUCTION, 1-1/4" FIP SUCTION X 1" FIP DISCHARGE, WITH PRESSURE AND FLOW SWITCH AND RUN DRY PROTECTION	NEAR AREA WHERE PIPING LEAVES WTP AND GOES TO WATER TANK WT-1	GRUNDFOS MODEL #MG 35, CAT #888 80172 115/60/1PH	6.5 GPM @ 40 PSI, PRESSURE RANGE 20-40 PSI
TP-1	END SUCTION MAGNETIC DRIVE CENTRIFUGAL PUMP, 8 GPM @ 5TDH, 1/2" NPT DISC X 3/4" FIP SUCTION, 1/20 HP TERSUB MOTOR, 115 VAC, WITH CORD	CHLORINE ROOM BETWEEN CT-2 AND CT-3	MARCOH MANUFACTURING MODEL LC-3CP-MD	N/A
PRESSURE RELIEF/REGULATOR VALVES				
PV-1	PRESSURE RELIEF VALVE, BRONZE, 1" FNPT INLET AND OUTLET, 100 PSI	TOP OF PRESSURE FILTERS, NO ISOLATION VALVES	WATTS MODEL 140S-100PSI	100 PSIG
STATIC MIXER, MOTORIZED MIXER				
MM-1	MOTORIZED MIXER, 1725 RPM, FLANGE MOUNT, TOTALLY ENCLOSED 1/20 HP, STAINLESS STEEL PROPELLER, SHAFT, COUPLER, EPOXY COATED, FACTORY POWER CORD, 115V, 30" LONG SHAFT	IN WATER TREATMENT PLANT NEAR CF-1 AND CF-2	WINGERT F-4M-TE-PRPWRD-EK-SCF-316-30"	FOR CHEMICAL MIXING IN CT-1 AND CT-3
SM-1	WAFFER-TYPE STATIC MIXER, FITS BETWEEN 3" 150# FLANGES, PVC MOUNTING RING, 0.7 BETA, 1/8" EPDM GASKETS, INJECTION QUILL INCLUDED	IN WATER TREATMENT PLANT NEAR CF-1	WESTFALL MFG. WAFFER STYLE, 2" MODEL 2800, PVC MOUNTING RING WITH 1/2" PVC QUILL AND BUILT-IN CHECK VALVE	DESIGNED FOR 40 GPM OPERATION
THERMOMETERS				
TH-1	THERMOMETER, DIGITAL, SELF-POWERED, VARIABLE ANGLE MOUNTING, RANGE -40F TO +300F, WITH THERMOWELL	VARIOUS LOCATIONS, AS REQUIRED	WEISS #DVU35 ELECTRONIC THERMOMETER (INDUSTRIAL GLASS THERMOMETER STEM ASSEMBLY, 3 1/2" STEM LENGTH) WITH E35-758S 3/4" NPT SOCKET	N/A
WATER HEATERS				
WH-1	ITEM # 1PZ78 WATER HEATER, 10 GAL, 120 VAC, 1500 W PLUG IN, 1 HEATING ELEMENT, 3/4" T&P VALVE, 3/4" NPT H & C CONNECTIONS	ON LID ABOVE LAB AND BATHROOM	VANGUARD #3648 GRANGER #1PZ78 OR EQUAL	110F

RECORD DRAWING
1-22-2013



Project No. _____
Date MAY 2010
Designed LAP
Drawn _____
Approved LAP

REVISION	BY	DATE

CE2 ENGINEERS, INC.
PO BOX 23296 ANCHORAGE, AK 99521 PH: 807-343-6010 FAX: 807-343-1015

2009 WATER SYSTEM UPGRADES
EQUIPMENT LIST
ATKA, ALASKA



CONSTRUCTION RECORD
FIELD BOOK
STAKING
FOREMAN
AS-BUILT
INSPECTOR

SCALE: AS SHOWN
1" = 10'-0"

RECORD DRAWING CERTIFICATE
THESE DRAWINGS REFLECT RECORD INFORMATION OBTAINED DURING CONSTRUCTION. INFORMATION PROVIDED HEREIN IS ACCURATE TO THE BEST OF KNOWLEDGE.
NAME _____

REF. OR TAG NO.	EQUIPMENT DESCRIPTION	LOCATION	MANUFACTURER'S SPECIFICATION	SETPOINT
TANKS				
CT-1	30 GAL VERTICAL MIXING TANK WITH LID, POLYETHYLENE, 18" DIA. X 31" H, MOLDED GALLONAGE AND LITER MARKINGS ON SIDE, NSF-61 APPROVED	NEAR FILTER PF-1	SNYDER INDUSTRIES PART #568-0000N-1	N/A
CT-2	30 GAL VERTICAL MIXING TANK WITH LID, POLYETHYLENE, 18" DIA. X 31" H, MOLDED GALLONAGE AND LITER MARKINGS ON SIDE, NSF-61 APPROVED	IN CHLORINE ROOM NEAR CT-3	SNYDER INDUSTRIES PART #568-0000N-1	N/A
CT-3	55 GAL VERTICAL MIXING TANK WITH LID TOTAL DRAIN POLYETHYLENE, 22" DIA. X 40" H, MOLDED GALLONAGE AND LITER MARKINGS ON SIDE, NSF-61 APPROVED WITH 12" HIGH PLASTIC TANK STAND	IN CHLORINE ROOM NEAR CT-2	SNYDER INDUSTRIES PART #579-0000N-1, WITH 1370000N--12" H TANK STAND	N/A
WT-1	INSULATED WATER TANK, 140,000 GAL, 39.6" ID X 16" TALL, W/ SS INTERNALS	OUTSIDE OF WATER TREATMENT PLANT	CUSTOM MADE TANK AND APPURTENANCES, SEE DRAWING CA.1 AND CA.2	N/A
PLUMBING FIXTURES AND COMPONENTS				
EW-1	EYEWASH STATION, SELF-STANDING, PLASTIC BOWL	CHLORINE ROOM BETWEEN CT-2 AND CT-3	BRADLEY S19-210, GRAINGER 4R861	N/A
LS-1	LAB COUNTER SINK, COUNTER MOUNTED, 18 GA STAINLESS STEEL SINK, SINGLE BASIN, BASIN IS APPROX. 18 W X 18 FR X 9" DEEP, FAUCET IS GOOSENECK MIXING FAUCET 4" C-C MOUNTING	LABORATORY	JUST, ELKAY OR APPROVED EQUAL	N/A
LS-2	LABORATORY SINK, WALL MOUNT, 4 INCH FAUCET MOUNTING, CAST IRON, SINGLE LEVER MIXING FAUCET, WHITE COLOR SINK	BATHROOM	AM STD REGALYN W/ DELTA SINGLE LEVER HANDLE FAUCET OR EQUAL	N/A
SS-1	SERVICE SINK, ENAMELED CAST IRON, BLANK BACK, W/ SS RIM GUARD AND WALL HANGER SUPPORTS W/ TRAP AND FAUCET	WATER TREATMENT AREA	KOHLER BANNON K-6718 SERVICE SINK, KOHLER ADJUSTABLE TRAP K-6673, KOHLER KINLOCK FAUCET K-8807	N/A
FD-1	MEDIUM DUTY CAST IRON FLOOR DRAIN, NICKEL FINISH COVER	VARIOUS LOCATIONS	SMITH 2005 OR EQUAL	N/A
HB-1	HOSE BIB, INDOOR TYPE FOR COLD WATER, WHEEL HANDLE TYPE			
WC-1	WATER CLOSET, FLOOR MOUNT, FLUSH TANK, 1.6 GPM PER FLUSH COMFORT HEIGHT, OPEN FRONT SOLID PLASTIC SEAT W/METAL HINGES	BATHROOM	AM STD GLENWALL OR EQUAL WHITE COLOR W/ FLOOR MOUNT, PVC ADAPTER TYPE CLOSET CARRIER (16123) OR EQUAL	N/A
WH-1	WATER HEATER, 4 GALLON TANK TYPE HEATER, 1500 WATT/120 V / 1 PH	ABOVE LAB CEILING	ARISTON GL471 (GRAINGER 4JY90) OR EQUAL	N/A



Project No. _____ Date <u>MAY 2010</u> Designed <u>LAP</u> Drawn _____ Approved <u>LAP</u>	REVISION BY DATE	 PO BOX 232948 ANCHORAGE, AK 99523 PTE 807-348-1910 FAX 807-348-1915	2009 WATER SYSTEM UPGRADES EQUIPMENT LIST ATKA, ALASKA	CONSTRUCTION RECORD FIELD BOOK _____ STAKING _____ FOREMAN _____ AS-BUILT _____ INSPECTOR _____	SCALE: AS SHOWN 1" = 10'-0"	RECORD DRAWING CERTIFICATE THESE DRAWINGS REFLECT RECORD INFORMATION OBTAINED DURING CONSTRUCTION. INFORMATION PROVIDED HEREIN IS ACCURATE TO THE BEST OF OUR KNOWLEDGE. NAME _____ DA _____
	Sheet No. <u>MS.3</u>		STATE OF ALASKA PROFESSIONAL ENGINEER License No. 14978 Expires 05-18-2013	STATE OF ALASKA PROFESSIONAL ENGINEER License No. 14978 Expires 05-18-2013	SCALE: AS SHOWN 1" = 10'-0"	RECORD DRAWING CERTIFICATE THESE DRAWINGS REFLECT RECORD INFORMATION OBTAINED DURING CONSTRUCTION. INFORMATION PROVIDED HEREIN IS ACCURATE TO THE BEST OF OUR KNOWLEDGE. NAME _____ DA _____


ELECTRICAL LEGEND

(NOTE: THIS IS A STANDARD LEGEND AND NOT ALL SYMBOLS ARE NECESSARILY USED.)

- ☐ EXTERIOR LIGHT FIXTURE, POLE MOUNTED, HEADS AS SHOWN
- HOLE
- PHOTOCELL WALK
- LUMINAIRE - TYPE AS NOTED ON PLAN
- LUMINAIRE - WALL MOUNTED, TYPE AS NOTED ON PLAN
- LUMINAIRE - EMERGENCY LIGHT
- TRACK LIGHTING - TRACK LENGTH AS SCALED, TYPE AS NOTED ON PLAN
- EMERGENCY LIGHTING UNIT (WALL, CEILING, RECUR HEAD): TYPE "T", UN
- EMERGENCY LIGHTING UNIT (WALL, CEILING, RECUR HEAD): TYPE "T", UN
- EXIT SIGN (CEILING, WALL), SWIRE DENOTES FACE, ARROWS AS INDICATED, TYPE "X", UN
- SWITCH - SINGLE POLE, SINGLE THROW, UN
- SWITCH - THREE WAY
- SWITCH - FOUR WAY
- SWITCH CONTROL FOR FIXTURES DENOTED WITH "O" APPENDED TO CIRCUIT NUMBER
- SWITCH - LOW VOLTAGE
- SWITCH - ELECTRONIC DIMMER SWITCH COMPATIBLE WITH LIGHT FIXTURE
- SWITCH - RECTED
- SWITCH - FLUO LIGHT
- SWITCH - INTEGRAL MOTOR OVERLOAD
- SWITCH - VARIABLE SPEED CONTROL
- LIGHT CONTROL OCCUPANCY SENSOR - WALL SWITCH BOX MOUNTED
- LIGHT CONTROL OCCUPANCY SENSOR - CEILING MOUNTED
- POWER DISTRIBUTION PANELBOARD
- METERING DEVICE
- CURRENT TRANSFORMER ENCLOSURE
- POWER PANELBOARD (NEW) - SURFACE, RECESSED, [CEILING - SURFACE, RECESSED]
- TRANSFORMER APPROX. PHYSICAL SIZE AS SCALED, ACTUAL RATING AS NOTED ON ONE-LINE DIAGRAMS
- MOTOR CONNECTION
- COMBINATION BATHROOM FAN/LIGHT, TYPE AS NOTED ON PLAN
- NON-FUSED SAFETY SWITCH
- FUSED SAFETY SWITCH
- ENCLOSED CIRCUIT BREAKER SWITCH
- MOTOR STARTER
- COMBINATION MOTOR STARTER SAFETY SWITCH
- PUSH BUTTON CONTROL STATION
- JUNCTION BOX OR EQUIPMENT CONNECTION - FLEX OR RECEPTACLE AS REQUIRED (CEILING, WALL, FLOOR)
- POWER CONNECTION TO FSD CONTROLLED BY FIRE ALARM SYSTEM
- SWIREX RECEPTACLE
- DUPLEX RECEPTACLE
- DOUBLE DUPLEX RECEPTACLE
- DUPLEX RECEPTACLE - SPILT WIRED FOR SWITCH CONTROL OF LOWER OUTLET
- DUPLEX RECEPTACLE - GFC PROTECTED
- DUPLEX RECEPTACLE - GFC PROTECTED MOUNTED 4'-6" AFF
- DUPLEX RECEPTACLE - GFC PROTECTED MOUNTED ABOVE COUNTERTOP
- DUPLEX RECEPTACLE - MOUNTED ABOVE COUNTERTOP
- DUPLEX RECEPTACLE - FLOOR MOUNTED FIVE RATED POLE THROUGH, UN
- DOUBLE DUPLEX RECEPTACLE - FLOOR MOUNTED FIVE RATED POLE THROUGH, UN
- RECEPTACLE - FREIGHT MOUNTED FROM CEILING
- RECEPTACLE - FLUSH MOUNTED IN CEILING
- DRIVER RECEPTACLE - 20A, 3 POLE, 4 WIRE, NEMA 14-30R
- ELECTRIC RANGE RECEPTACLE - 50A, 3 POLE, 4 WIRE, NEMA 14-50R
- SPECIAL PURPOSE RECEPTACLE - NEMA CONFIGURATION AS NOTED (SURFACE, WALL)
- GROUND CONNECTION POINT
- DUAL CHANNEL SURFACE MOUNTED RECEPTACLE - LENGTH AS SCALED
- SINGLE CHANNEL SURFACE MOUNTED RECEPTACLE - LENGTH AS SCALED
- TELECOMMUNICATION OUTLET (WALL, FLOOR)
- TELEPHONE OUTLET
- TELEVISION OUTLET (WALL, CEILING)
- DUAL CHANNEL SERVICE POLE
- TELECOMMUNICATION FLOOR STAIRING BACK
- TELECOMMUNICATION WALL MOUNTED BACK
- TELECOMMUNICATION WAIN GROUNDING BUS
- TELECOMMUNICATION GROUNDING BUS
- CONTROL PANEL - TYPE AS NOTED (SURFACE, RECESSED)

- FIRE ALARM CONTROLLED MANDANT DOOR HOLDER / RELEASE
- ABORT STATION
- CARBON MONOXIDE DETECTOR
- HEAT DETECTOR - RATE OF RISE
- HEAT DETECTOR - FIXED TEMPERATURE AS NOTED
- SMOKE DETECTOR - PHOTOELECTRIC TYPE
- SMOKE DETECTOR - PHOTOELECTRIC TYPE
- SMOKE DETECTOR - DUCT MOUNTED
- SMOKE DETECTOR - BEAM RECEIVER
- SMOKE DETECTOR - BEAM TRANSMITTER
- FLAME DETECTOR
- LINE TYPE HEAT SENSITIVE CABLE DETECTOR
- FIRE ALARM HORN
- FIRE ALARM STROBE
- FIRE ALARM COMBINATION HORN/STROBE
- FIRE ALARM FULL STATION
- FIRE ALARM CONTROL PANEL
- FIRE SYSTEM ANNUNCIATOR PANEL
- FIRE CONTROL PANEL
- FIRE ALARM SPEAKER STROBE
- WAFER FLOW BELL - 120V CONTROLLED BY FLOW SWITCH
- FIRE ALARM FLOW SWITCH
- FIRE ALARM TAMPERS SWITCH
- MICROPHONE INPUT JACK - FLOOR MOUNTED
- MICROPHONE INPUT JACK - FLOOR MOUNTED
- INTERCOM ADMINISTRATION PHONE
- SPEAKER (WALL, CEILING)
- CLOCK SPRINGER COMBINATION WALL MOUNT UNIT
- CLOCK - WALL MOUNTED
- SECURITY ACCESS CARD READER
- DOOR CONTROL STATION
- DOOR MANDANT CONTACT
- SECURITY SYSTEM - GLASS BREAK SENSOR
- SECURITY SYSTEM - MOTION SENSOR
- SECURITY SYSTEM - DOOR POSITION SENSOR
- SECURITY SYSTEM - REQUEST TO EXIT MOTION DETECTOR
- SECURITY SYSTEM - ACCESS KEY PAD
- SECURITY SYSTEM - MOTION SENSOR - WINDOW PATTERNS
- SECURITY SYSTEM - CAMERA
- ACCESS PANEL
- LINE TYPE DENOTING CABLE TRAY
- LINE TYPE/DENOTING DENOTING FINING WORK
- LINE TYPE/DENOTING DENOTING EXISTING WORK TO REMAIN
- LINE TYPE/DENOTING DENOTING NEW WORK
- LINE TYPE/DENOTING DENOTING DEMO WORK
- DENOTES AVAILABLE FAULT CURRENT

EQUIPMENT TAG LEGEND

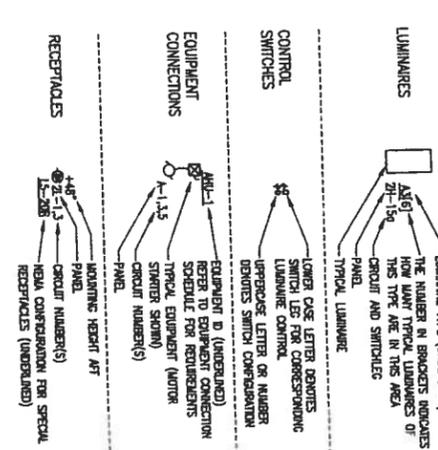


ABBREVIATIONS

AC	ACROSS
A	ABOVE
AF	ABOVE FINISHED FLOOR
AFI	ARC FAULT CIRCUIT INTERRUPTER
AG	ABOVE FINISHED GRADE
AJ	AUTOMATIC FINISH JURISDICTION
AK	ALWAYS INTERFERING EQUIPMENT
AL	ALUMINUM
AM	ARCHITECTURAL MOUNTING
AN	ANCHOR BOLT
AO	CONDUIT OR CABLES
AP	CABLETRAY
AR	CIRCUIT BREAKER
AS	CONDUIT ONLY
AT	CABLETRAY TRANSFORMER
BA	BRASS
BC	BRASS
BD	BRASS
BE	BRASS
BF	BRASS
BG	BRASS
BH	BRASS
BI	BRASS
BJ	BRASS
BK	BRASS
BL	BRASS
BM	BRASS
BN	BRASS
BO	BRASS
BP	BRASS
BQ	BRASS
BR	BRASS
BS	BRASS
BT	BRASS
BU	BRASS
BV	BRASS
BW	BRASS
BX	BRASS
BY	BRASS
BZ	BRASS
CA	CABLE
CB	CABLE
CC	CABLE
CD	CABLE
CE	CABLE
CF	CABLE
CG	CABLE
CH	CABLE
CI	CABLE
CJ	CABLE
CK	CABLE
CL	CABLE
CM	CABLE
CN	CABLE
CO	CABLE
CP	CABLE
CQ	CABLE
CR	CABLE
CS	CABLE
CT	CABLE
CU	CABLE
CV	CABLE
CW	CABLE
CX	CABLE
CY	CABLE
CZ	CABLE
DA	CABLE
DB	CABLE
DC	CABLE
DD	CABLE
DE	CABLE
DF	CABLE
DG	CABLE
DH	CABLE
DI	CABLE
DJ	CABLE
DK	CABLE
DL	CABLE
DM	CABLE
DN	CABLE
DO	CABLE
DP	CABLE
DQ	CABLE
DR	CABLE
DS	CABLE
DT	CABLE
DU	CABLE
DV	CABLE
DW	CABLE
DX	CABLE
DY	CABLE
DZ	CABLE
EA	CABLE
EB	CABLE
EC	CABLE
ED	CABLE
EE	CABLE
EF	CABLE
EG	CABLE
EH	CABLE
EI	CABLE
EJ	CABLE
EK	CABLE
EL	CABLE
EM	CABLE
EN	CABLE
EO	CABLE
EP	CABLE
EQ	CABLE
ER	CABLE
ES	CABLE
ET	CABLE
EU	CABLE
WB	CABLE
WC	CABLE
WD	CABLE
WE	CABLE
WF	CABLE
WG	CABLE
WH	CABLE
WI	CABLE
WJ	CABLE
WK	CABLE
WL	CABLE
WM	CABLE
WN	CABLE
WO	CABLE
WP	CABLE
WQ	

FEEDER SCHEDULE			
FEEDER ID	RACKWAY	CONDUCTORS	NOTES
200N	1	(1) 2/0 AWG, (1) 3/4" AMC EGC	
200M	2	C.O. STUBBED OUT FOR UTILITY CONNECTION	
200S	N/A	N/A	


STANDARD NOTES:
 1) ALL CONDUCTOR SIZES SHOWN ARE COPPER.
 2) COORDINATE CONDUIT SIZE, QUANTITY, LOCATION, ROUTING, AND REQUIREMENTS WITH UTILITY SERVICE MAY BE OVERHEAD OR UNDERGROUND.

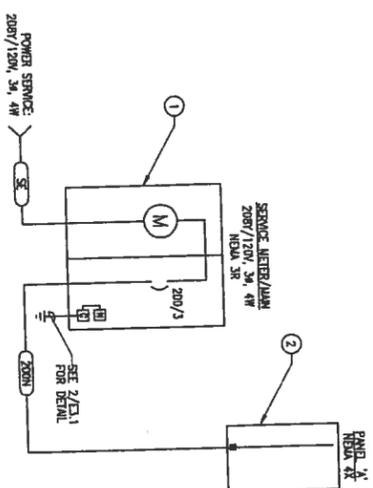

1 POWER ONE-LINE DIAGRAM
 E3.1 SCALE: NONE

EQUIPMENT SCOR SCHEDULE			
ALL EQUIPMENT TO HAVE SCORE EXCEEDING THE AVAILABLE SCA AT THE CALCULATED X/R RATIO. WHERE X/R RATIO IS GREATER THAN THE INDUSTRY STANDARD TEXT X/R RATIOS THE APPROPRIATE MULTIPLICATION FACTOR SHALL BE APPLIED TO PROPERLY RATE THE EQUIPMENT.			
DOMESTIC EQUIPMENT AND CIRCUIT BREAKER RATINGS SHALL BE RATED USING FULLY RATED EQUIPMENT OR THE AVAILABLE SCA AT EQUIPMENT. SERIES RATED EQUIPMENT MOTOR LOADS CANNOT EXCEED 1% OF A.C. RATING PER NEC 240.8(B)(1).			
EQUIPMENT ID	SCORING	X/R	
SERVICE METER/MAIN	15.087	1.04	
PANEL 'A'	15.087	1.02	
ASSUMED UTILITY SYSTEM CONFIGURATION			
TRANSFORMER	75 KVA, 11.5% 1.22 X/R		
CONDUCTORS (TRANSFORMER SECONDARY)	SCA(Ph), WHITE		
PER PHASE	CU 1/2", 1 EA. 12/0, 20 FT. RACKWAY = NON-METAL		
CONTRACTOR TO VERIFY ACTUAL EQUIPMENT TO BE PROVIDED WITH SERVING UTILITY PRIOR TO EQUIPMENT PROCUREMENT. ANY DISCREPANCIES IN TRANSFORMER KVA OR CABLE SIZES TO BE REPORTED TO CONTRACT OFFICER.			

- DETAIL EQUIPMENT**
- SERVICE METER/MAIN - SE. RATED, NEHA 3R, 200R/120V, 34.4N, 200A MAIN CB, 18,000 A.C. SQUARE D OR EQUIVALENT.
 - PANEL 'A' - NEHA 4R, 200R/120V, 34.4N, 200A, 18,000 A.C. 42 SPACE SQUARE D OR EQUIVALENT.

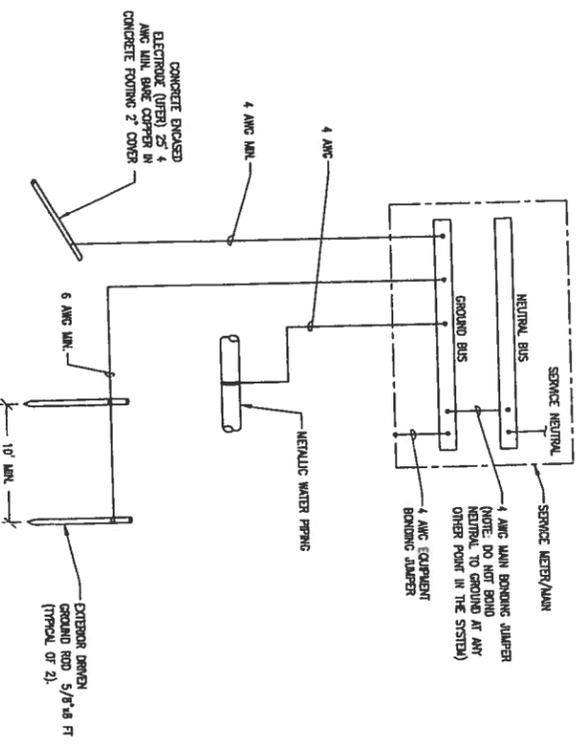


2 BUILDING GROUNDING DIAGRAM
 E3.1 SCALE: NONE

PANEL 'A' SCHEDULE									
NO.	DESCRIPTION	UNIT	QTY	SCHEMATIC	LOCATION	DATE	BY	REVISION	NOTES
1	TRANSFORMER	75 KVA	1		OUTSIDE				
2	CONDUCTORS	CU 1/2"	1 EA.		12/0				
3	CONDUCTORS	CU 1/2"	1 EA.		12/0				
AS-BUILT DRAWINGS
 INFORMATION HAS NOT BEEN VERIFIED OR IS CLAIMED TO BE ACCURATE BY THE ENGINEER. ALL WORK IS BASED ON CONTRACTOR PROVIDED RED-LINE DRAWINGS.

EIC ENGINEERS, INC.
 ELECTRICAL ENGINEERS
 8977 OLD SPANISH WPT. SUITE 200
 ANCHORAGE, AK 99518
 P 907.249.9712
 F 907.249.9713
 www.eic-engineers.com
 REG. JOB # 810-1788

Project No. _____ Date <u>APRIL 2011</u> Designed <u>BLS</u> Drawn <u>BLS</u> Approved <u>EDC</u>	REVISION BY DATE	 PO BOX 23294 ANCHORAGE, AK 99523 PH: 907-349-1910 FAX: 907-349-1015	2009 WATER SYSTEM UPGRADES ELECTRICAL DIAGRAMS AND DETAILS ATKA, ALASKA	CONSTRUCTION RECORD FIELD BOOK STAKING FOREMAN AS-BUILT INSPECTOR	SCALE: BAR IS ONE INCH OR ORIGINAL DRAWING IF NOT ONE INCH ON THIS SHEET ADJUST SCALES ACCORDINGLY	RECORD DRAWING CERTIFICATE THESE DRAWINGS REFLECT RECORDED INFORMATION OBTAINED DURING CONSTRUCTION. INFORMATION PROVIDED HEREIN IS ACCURATE TO THE BEST OF MY KNOWLEDGE. NAME _____ DATE _____
	Sheet No. E3.1		Project No. _____ Date _____ Designed _____ Drawn _____ Approved _____	CE2 ENGINEERS, INC. PO BOX 23294 ANCHORAGE, AK 99523 PH: 907-349-1910 FAX: 907-349-1015	2009 WATER SYSTEM UPGRADES ELECTRICAL DIAGRAMS AND DETAILS ATKA, ALASKA	CONSTRUCTION RECORD FIELD BOOK STAKING FOREMAN AS-BUILT INSPECTOR

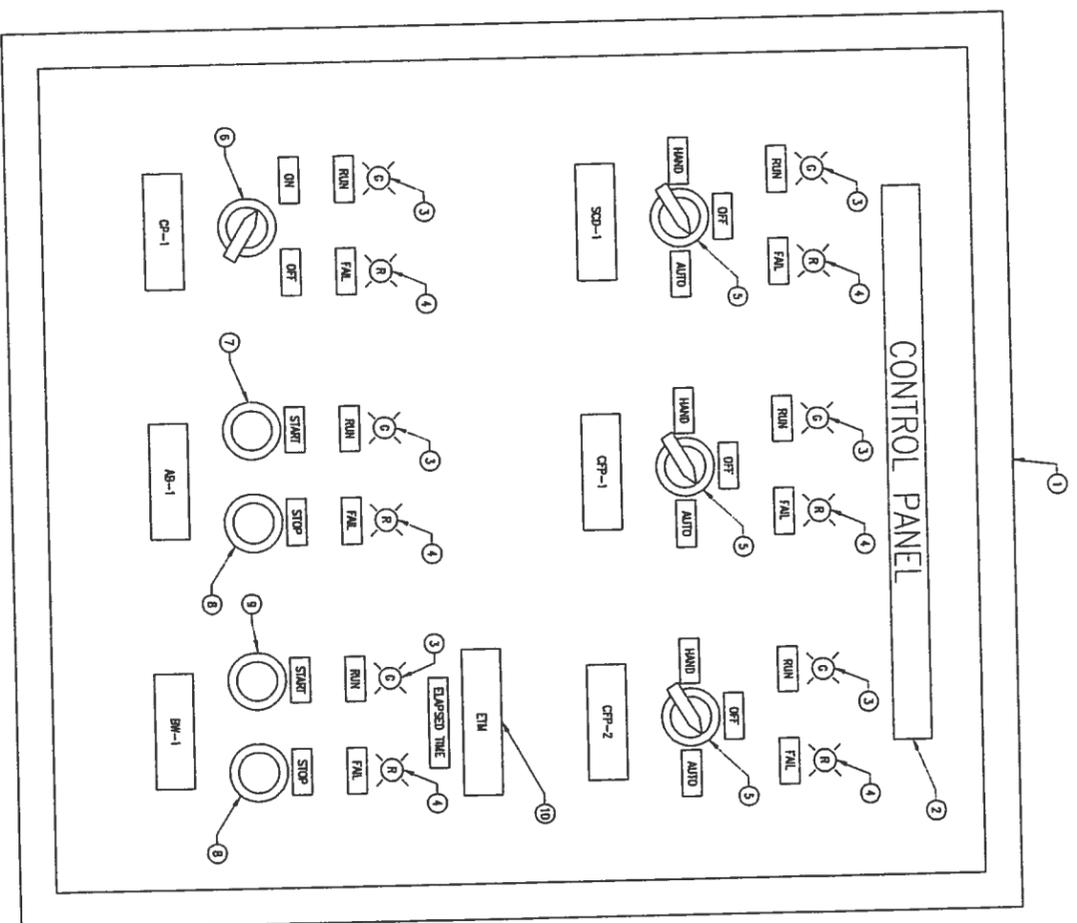


ITEM	DESCRIPTION	NOTES
1	CONTROL PANEL ENCLOSURE - NEHA 44, SIZE D AS SPECIFIED TO HOUSE COMPONENTS	
2	NAME TAG - BLACK UNPAINTED PLASTIC W/ WHITE CORE, STENCIL MOUNTED, 1/2" (1/2" FOR FRONT DOOR ONLY) ENGRAVED LETTERS	
3	PILOT LIGHT - 30mm, GREEN, LED, 120VAC, PUSH TO TEST TYPE, ALLEN BRADLEY 800-PR118	
4	PILOT LIGHT - 30mm, RED, LED, 120VAC, PUSH TO TEST TYPE, ALLEN BRADLEY 800-PR118	
5	SELECTION SWITCH - 30mm, 2-POSITION MAINTAINED W/ TERMINAL BLOCKS & COW SHOWN, ALLEN BRADLEY 800 SERIES	
6	ON/OFF SWITCH - 30mm, 2-POSITION MAINTAINED W/ TERMINAL BLOCKS & COW SHOWN, ALLEN BRADLEY 800 SERIES	
7	STOP PUSHBUTTON - 30mm, MAINTAINED SWITCH, 120VAC, GREEN, ALLEN BRADLEY 800 SERIES	
8	STOP PUSHBUTTON - 30mm, MAINTAINED SWITCH, 120VAC, RED, ALLEN BRADLEY 800 SERIES	
9	START PUSHBUTTON - 30mm, MAINTAINED SWITCH, 2-POLE, 120VAC, GREEN, ALLEN BRADLEY 800 SERIES	
10	ELAPSED TIME METER - HOUR METER, RESISTABLE, 989939 HOUR REGISTER, 120V	

NOTES:
 A) CONTRACTOR TO PROVIDE PART NUMBERS SHOWN OR EQUIVALENT.
 STANDARD NOTES

REFERRED NOTES:
 1) NONE

1 CONTROL PANEL
 E3.2 SCALE: NONE

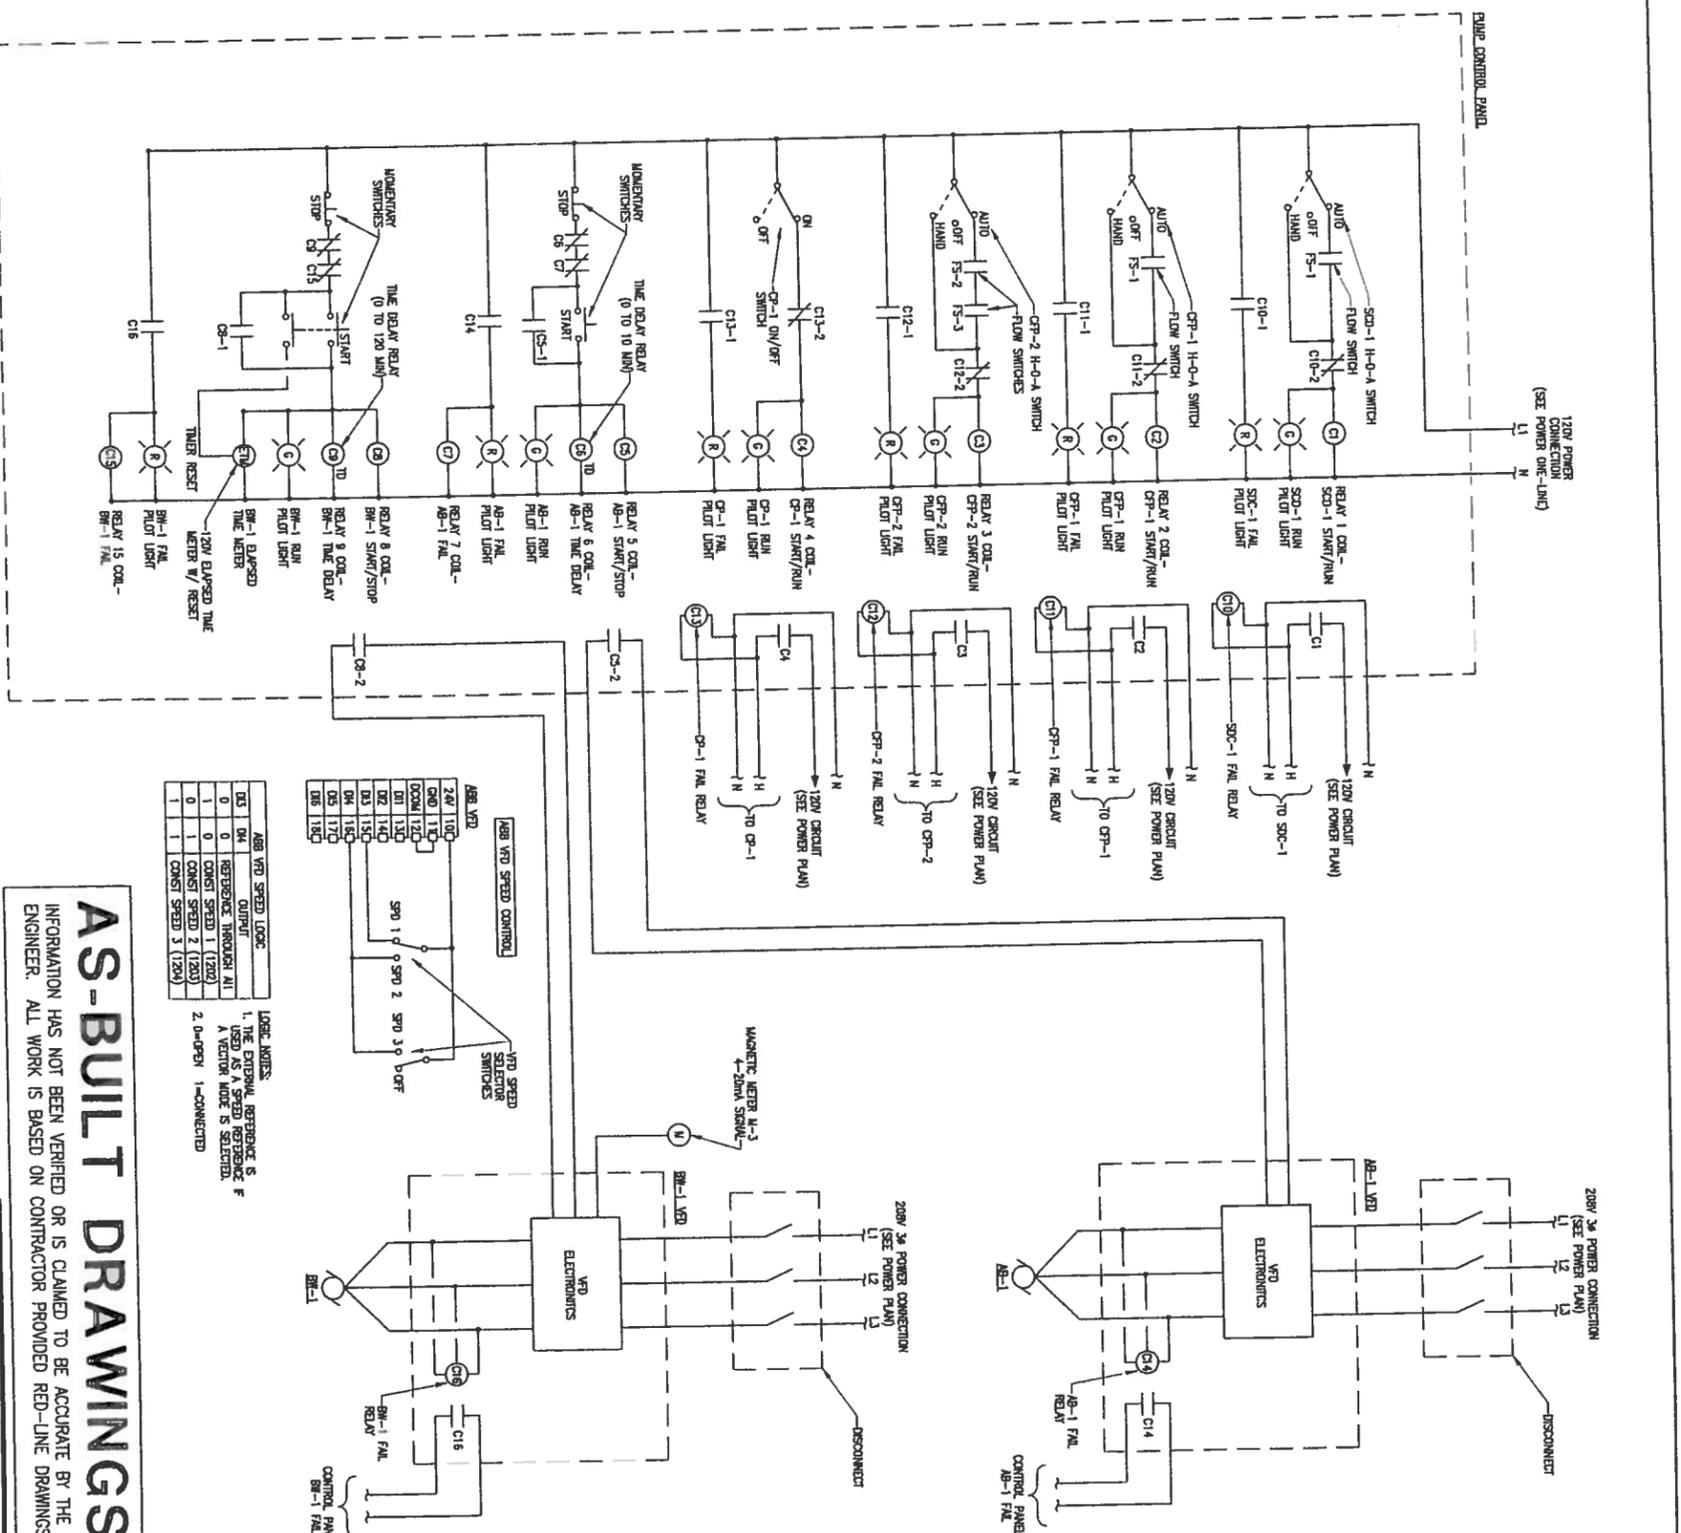

2 CONTROL PANEL DIAGRAM
 E3.2 SCALE: NONE

AS-BUILT DRAWINGS
 INFORMATION HAS NOT BEEN VERIFIED OR IS CLAIMED TO BE ACCURATE BY THE ENGINEER. ALL WORK IS BASED ON CONTRACTOR PROVIDED RED-LINE DRAWINGS.

EIC ENGINEERS, INC
 ELECTRICAL ENGINEERS

6927 OLD SEWARD HWY., SUITE 200
 ANCHORAGE, AK 99518
 F 907.249.9711
 www.eiceng.com

CONSTRUCTION RECORD	RECORD DRAWING CERTIFICATE
FIELD BOOK	THESE DRAWINGS REFLECT RECORDED INFORMATION OBTAINED DURING CONSTRUCTION. INFORMATION PROVIDED HEREIN IS ACCURATE TO THE BEST OF MY KNOWLEDGE.
STAGING	NAME _____ DATE _____
FOREMAN	
AS-BUILT	
INSPECTOR	





2009 WATER SYSTEM UPGRADES
 ELECTRICAL DIAGRAMS AND DETAILS
 ATKA, ALASKA

CE2
 ENGINEERS, INC.
 PO BOX 27294 ANCHORAGE, AK 99523 TEL: 907-349-1810 FAX: 907-349-1015

REVISION	BY	DATE

Project No. _____
 Date: APRIL 2011
 Designed: BLS
 Drawn: BLS
 Approved: EDC

Sheet No. **E3.2**

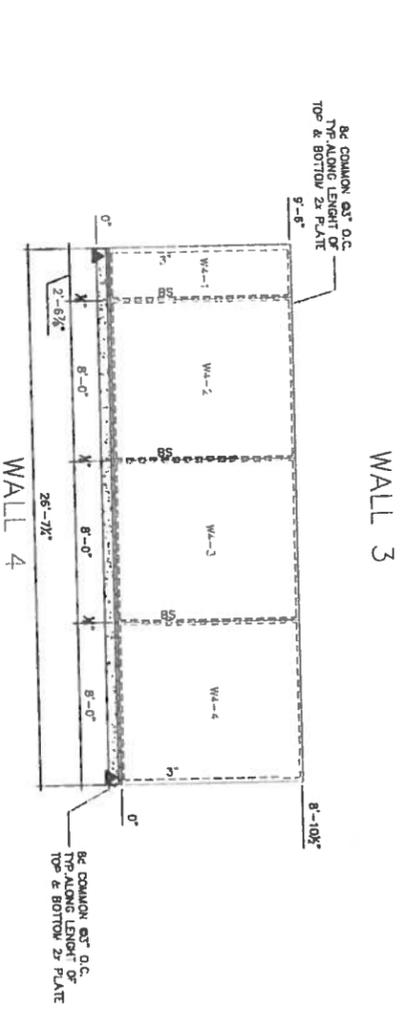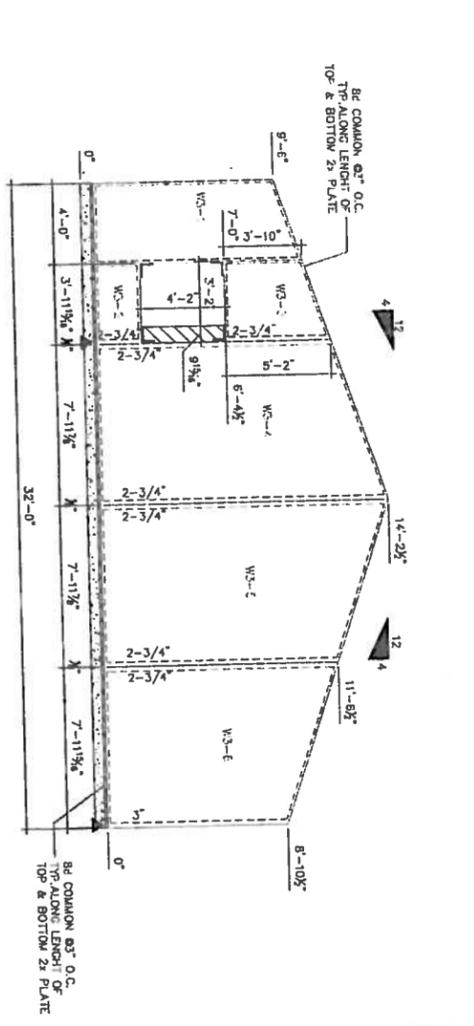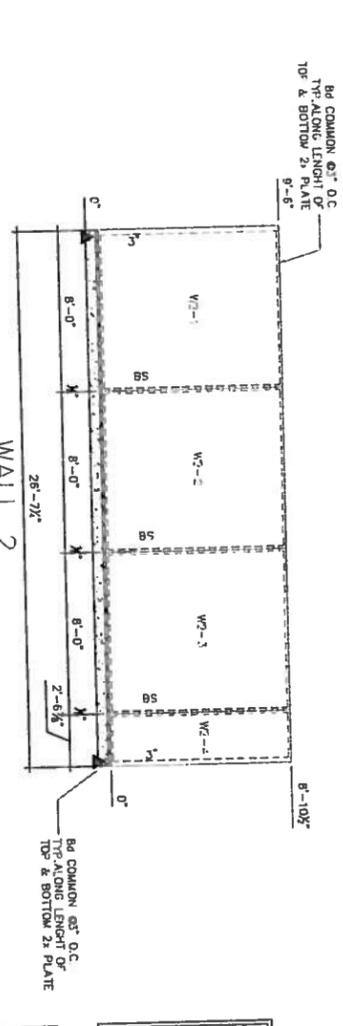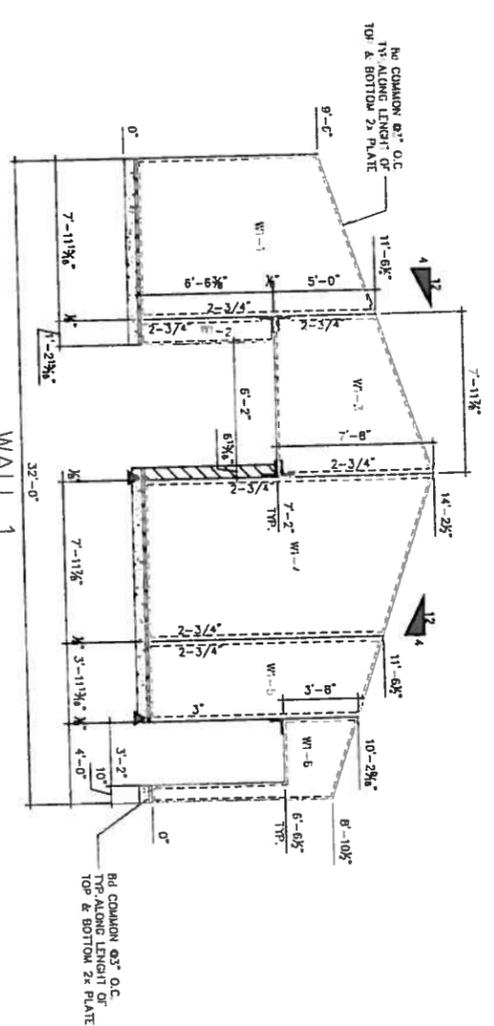

PAGE NOTES: WALL PANELS

- 0 ALL VIEWS ARE SET AT 1/4" = 1'-0" UNLESS OTHERWISE NOTED
- 0 ALL VIEWS ARE SET TO BE PERPENDICULAR TO WALL PANELS
- 0 ALL PERIMETER LUMBER IS TO BE RECESSED 5/8" FOR A SINGLE 2X UNLESS OTHERWISE NOTED
- 0 TS = TOP SKIN DIMENSION
- 0 BS = BOTTOM SKIN DIMENSION
- 0 H&O = HEADER NOT SUPPLIED BY BSI DUE TO SIZE OR LOADING CONDITIONS
- 0 ZZZZ = STICK FRAME BY OTHERS
- 0 PANELS TREATED WITH FRAMEGUARD.

PANEL COMPONENT LEGEND, SUPPLIED BY BSI

CODE	DESCRIPTION	DETAIL REF.	COMMENTS
BS	BLOCK SKIN (8' LENGTHS)	SP-102G	
BS	ROCK SKIN (8' LENGTHS)	SP-102	
OS	ROCK SKIN (8' LENGTHS)	SP-102L	
SS	SINGLE I-BEAM	SP-102B	
IB	INSULATED I-BEAM	SP-102C	
IB	FACTORY INSTALLED I-BEAM	BS-302B	
TIB	INSULATED DOUBLE-LAY HEADER	BS-515	
H&O	INSULATED SINGLE-LAY HEADER	BS-516	
AD-1	PANEL HEADER (CENTERED BY P)	BS-513	





PANEL RECESS LEGEND, LUMBER SUPPLIED BY OTHERS.

CODE	DESCRIPTION	DETAIL REF.	COMMENTS
1-1/4"	RECESS DEPTH	SP-102D (SM)	HW BOARD
1-1/2"	RECESS DEPTH	BS-302A	
2-1/4"	RECESS DEPTH	BS-302B (SM)	1" W.
3"	RECESS DEPTH	SP-102E (SM)	
2-3/4"	RECESS DEPTH	BS-302L (SM)	
3-5/8"	RECESS DEPTH	BS-302J (SM)	

NOTE: PANELS ARE RECESSED ACCORDING TO LUMBER SIZES CALLED OUT BY ENGINEER OF RECORD UNLESS SUPPLIED BY BSI.

HOLDOWN SCHEDULE

SIZE	POST/CHORD	NAILING	EMBEDMENT
STD14	(2) 2x8 MIN.	15-16c SINKERS	6"
STD14	(2) 2x8 MIN.	24-16c SINKERS	14c

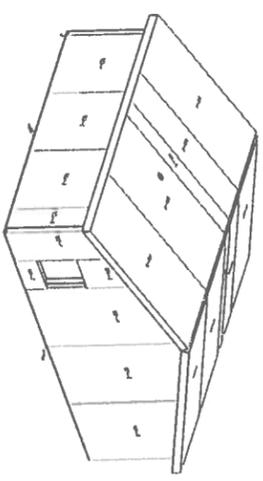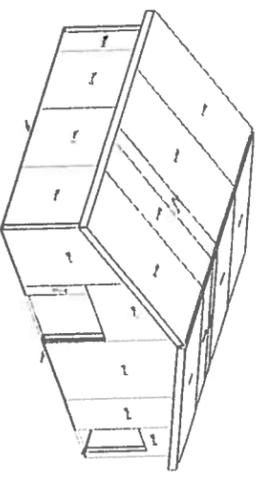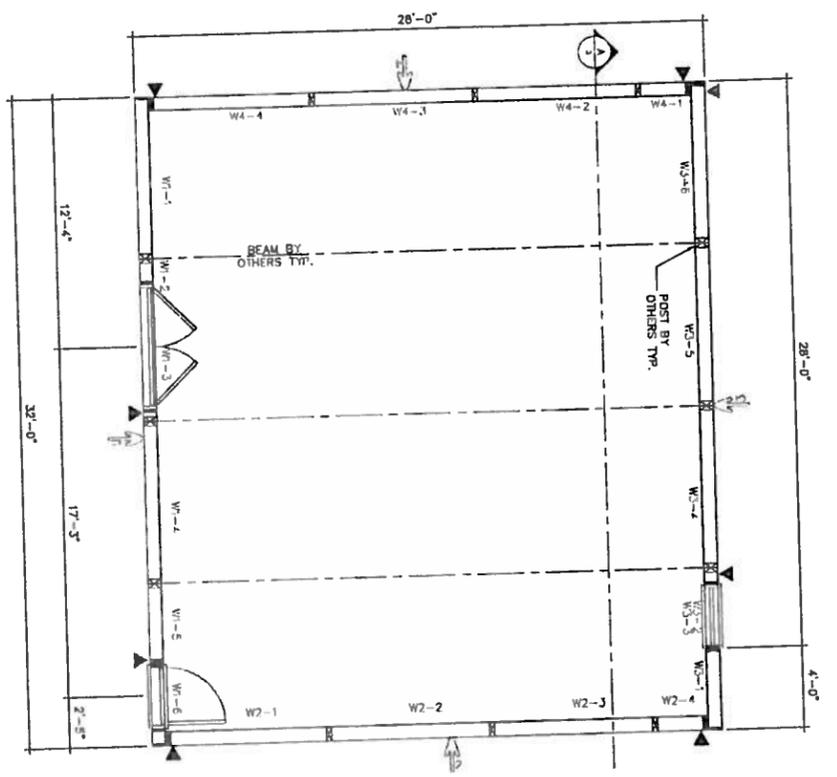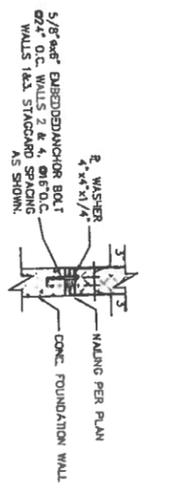


	<p>ATKA BLDG. PAK ATKA, AK</p>	<p>BIG SKY INSULATIONS, INC. 15 Arden Drive P.O. Box 838 Belgrade, Montana 59714 (800) 766-3626</p> <p>Denver, Colorado Grand Jct., Colorado Puyallup, Washington (303) 282-6665 (970) 241-3929 (866) 839-1321</p>	<p>2/4</p>
--	---	---	------------

CODE	DESCRIPTION	DETAIL REF.	COMMENTS
1-1/4"	RECESS DEPTH	SP-1020 (SNU)	RM BOARD
1-1/2"	RECESS DEPTH	SP-1020	
2-1/2"	RECESS DEPTH	BS-5024	
3-1/2"	RECESS DEPTH	SP-1020 (SNU)	LV
5/8"	RECESS DEPTH	BS-5024 (SNU)	


CODE	DESCRIPTION	DETAIL REF.	COMMENTS
BS	BLOCK SPLINE (8' LENGTHS)	SP-1026	
DS	DOUBLE SPLINE (8' LENGTHS)	SP-102	
SS	SINGLE SPLINE (8' LENGTHS)	SP-1028	
B	SINGLE I-BEAM	SP-1026	
IB	INSULATED I-BEAM	BS-5028	
FB	FACTORY INSTALLED I-BEAM	BS-515	
HOR-E	INSULATED DOUBLE WOOD-LAMINATE HEADER	BS-516	
HOR-F	INSULATED SINGLE WOOD-LAMINATE HEADER	BS-513	
PH-HOR	PANEL HEADER (DEFINIED BY P)		

NOTE: PANELS ARE RECESSED ACCORDING TO LUMBER SIZES CALLED OUT BY ENGINEER OF RECORD UNLESS SUPPLIED BY BS.

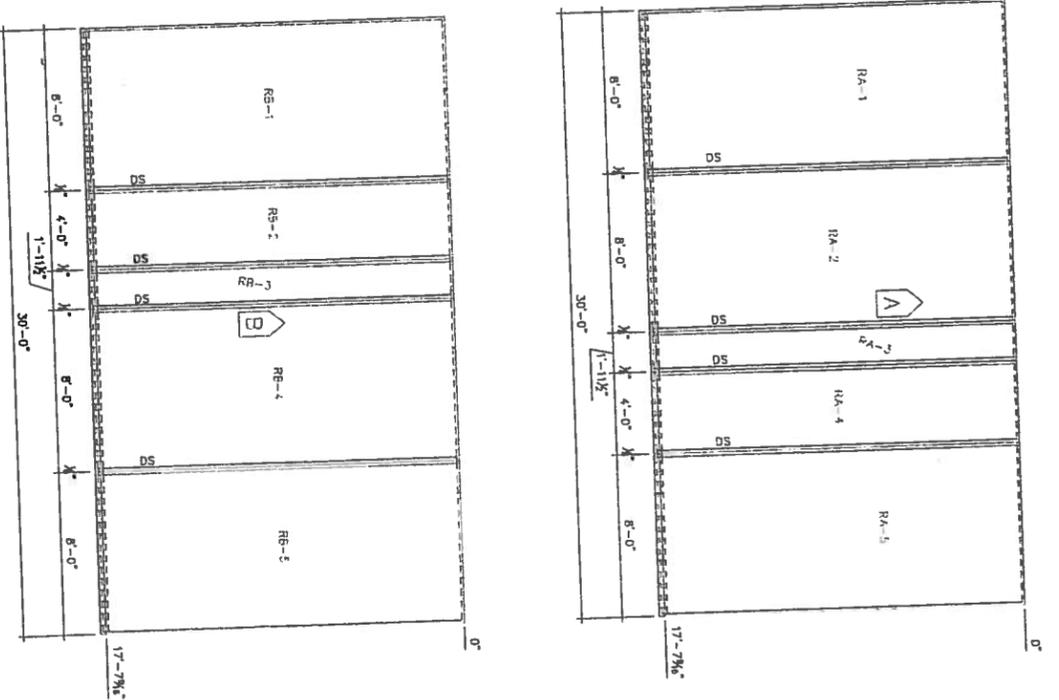


PAGE NOTES: ROOF PANELS

- ALL VIEWS ARE SET AT 1/4" = 1'-0" UNLESS OTHERWISE NOTED
- ALL VIEWS ARE SET TO BE PERPENDICULAR TO ROOF PLUMES
- ALL PERIMETER LUMBER IS TO BE RECESSED 1/4" FOR A SINGLE 2X UNLESS OTHERWISE NOTED
- ALL DIMENSIONS ARE TO TOP SKIN UNLESS NOTED OTHERWISE
- TS= TOP SKIN DIMENSION
- BS= BOTTOM SKIN DIMENSION
- PANELS TREATED WITH FRAMING GLUE

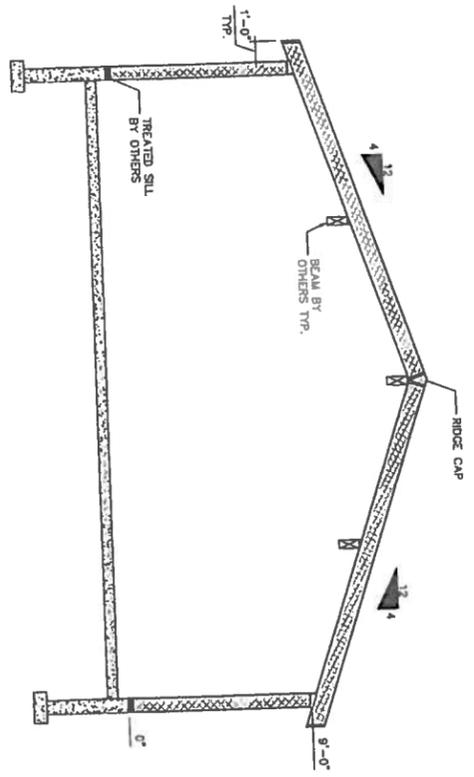


A BUILDING SECTION
1/4" = 1'-0"

STAGGERED PATTERN @ WALL

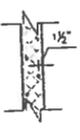

12" R-CONTROL SCREWS @ 4" O.C. STAGGERED SPACING TO W/IN 1-1/2" OF FACE OF SIP WALL TYP. @ CORNERS.




















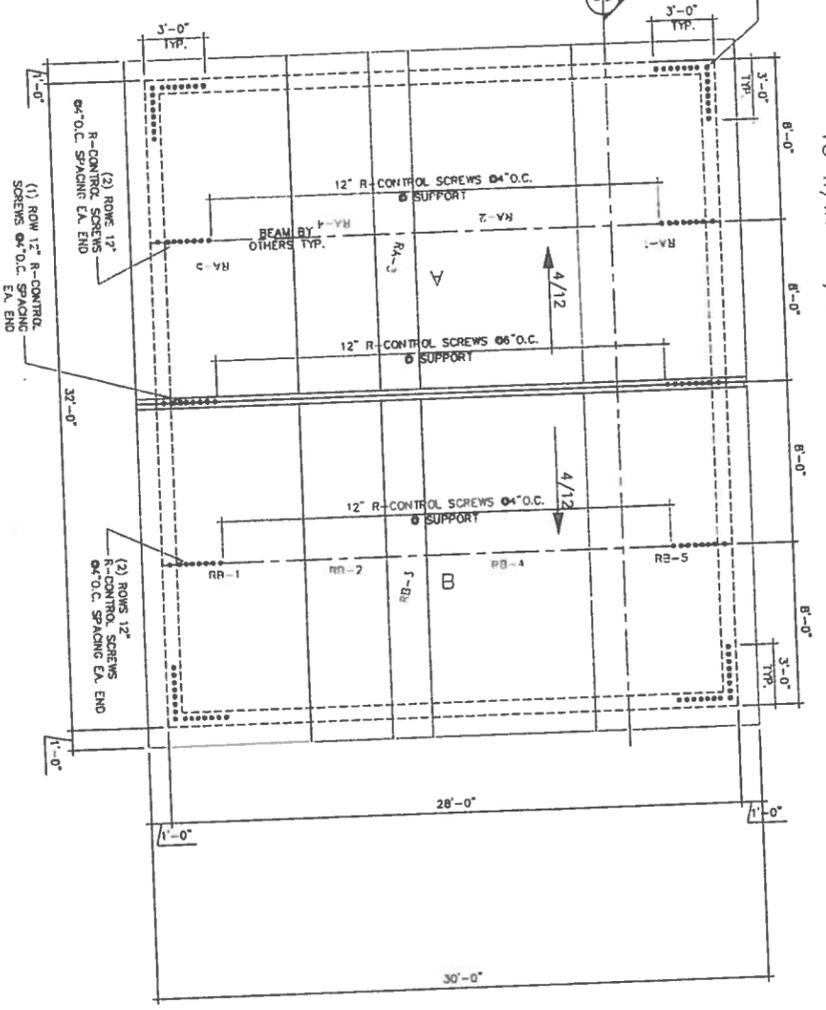


TYP. CONNECTION @ WALL U.N.O. 12" R-CONTROL SCREW @ 6" O.C. STAGGER SPACING TO W/IN 1-1/2" OF FACE OF SIP WALL.

ROOF PLAN
1/4" = 1'-0"


	BIG SKY INSULATIONS, INC. 15 Arden Drive P.O. Box 838 Belgrade, Montana 59714 (800) 766-3626	
	Denver, Colorado Grand Jct., Colorado Puyallup, Washington (303) 282-6665 (970) 241-3929 (866) 839-1321	
ATKA BLDG. PAK ATKA, AK	DRAWN BY: [Name] DRAWING NO: [Number] DATE: 3/2/11 REVISION:	3/4

- 1) On inside SIPs, see note.
- 2) The product being used must be SIPs with a minimum thickness of 2 1/2" and a minimum density of 150 lbs/cu ft.
- 3) The product being used must be SIPs with a minimum thickness of 2 1/2" and a minimum density of 150 lbs/cu ft.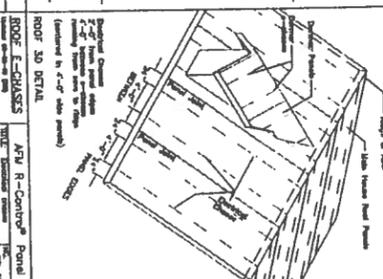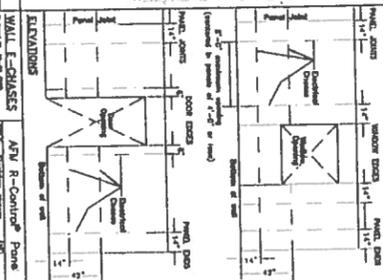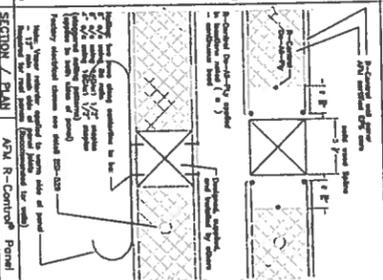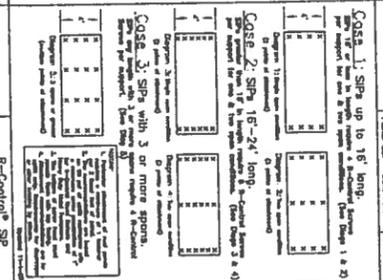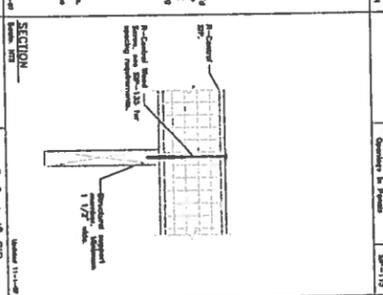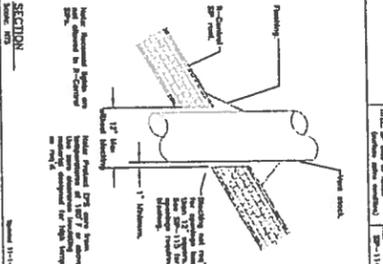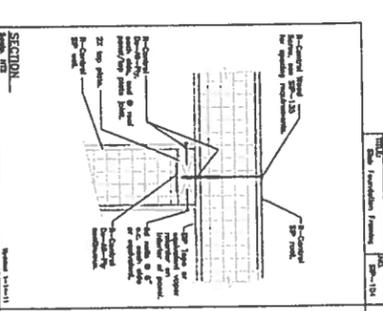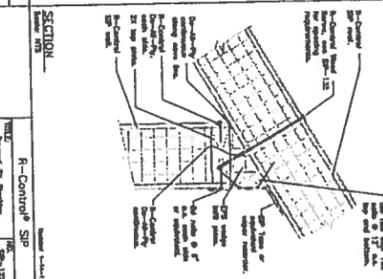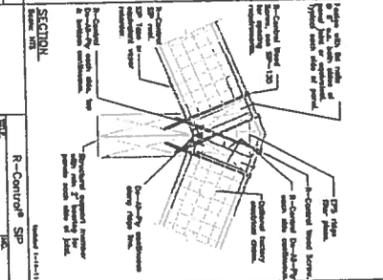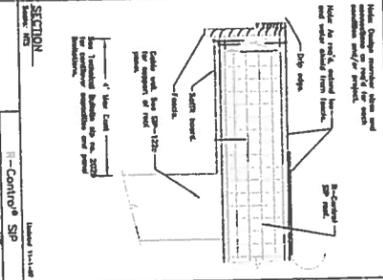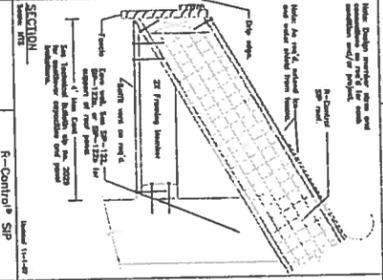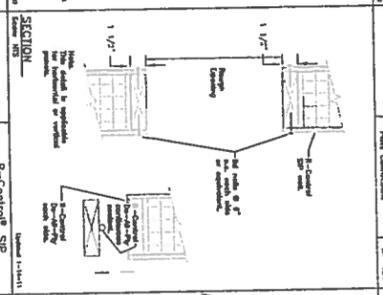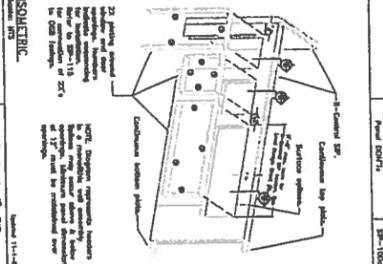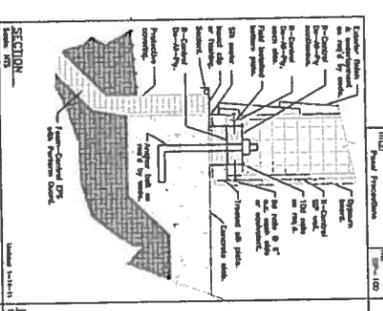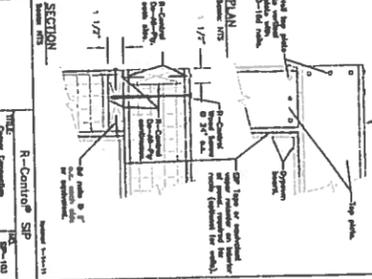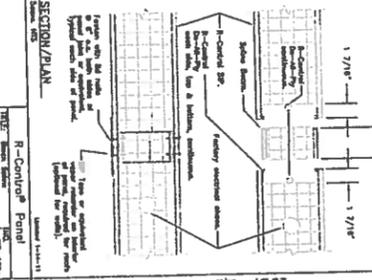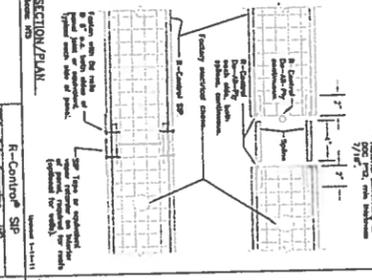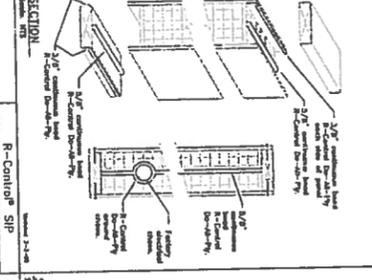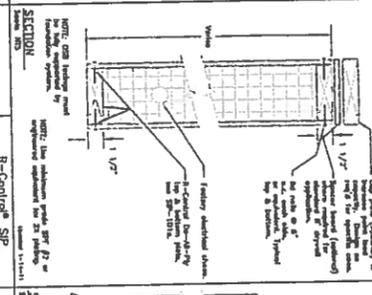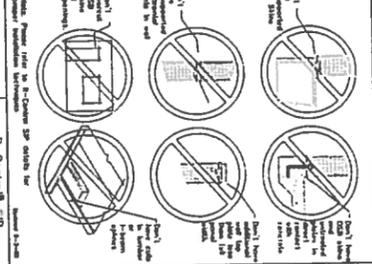
SECTION R-Contro[®] SIP Sp-109
 SECTION R-Contro[®] SIP Sp-110
 SECTION R-Contro[®] SIP Sp-111
 SECTION R-Contro[®] SIP Sp-200

CASE 1: SIPs up to 16' long.
 CASE 2: SIPs 16'-24' long.
 CASE 3: SIPs with 3 or more spans.

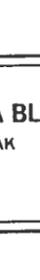

ATKA BLDG. PAK
 ATKA, AK
 4/4

BIG SKY INSULATIONS, INC.
 16 Arden Drive P.O. Box 838
 Belgrade, Montana 59714
 (800) 766-3826
 Denver, Colorado Grand Jct., Colorado Puyallup, Washington
 (303) 282-6665 (970) 241-3929 (866) 839-1321

R CONTROL

DESIGNED BY: Kevin
 DRAWING FILE:
 DATE: 5/2/21
 REVISED